


BEGIN STONE FILL TYPE IV
 BEGIN UNCLASSIFIED CHANNEL EXCAVATION
 BEGIN GEOTEXTILE UNDER STONE FILL
 BEGIN GRUBBING MATERIAL

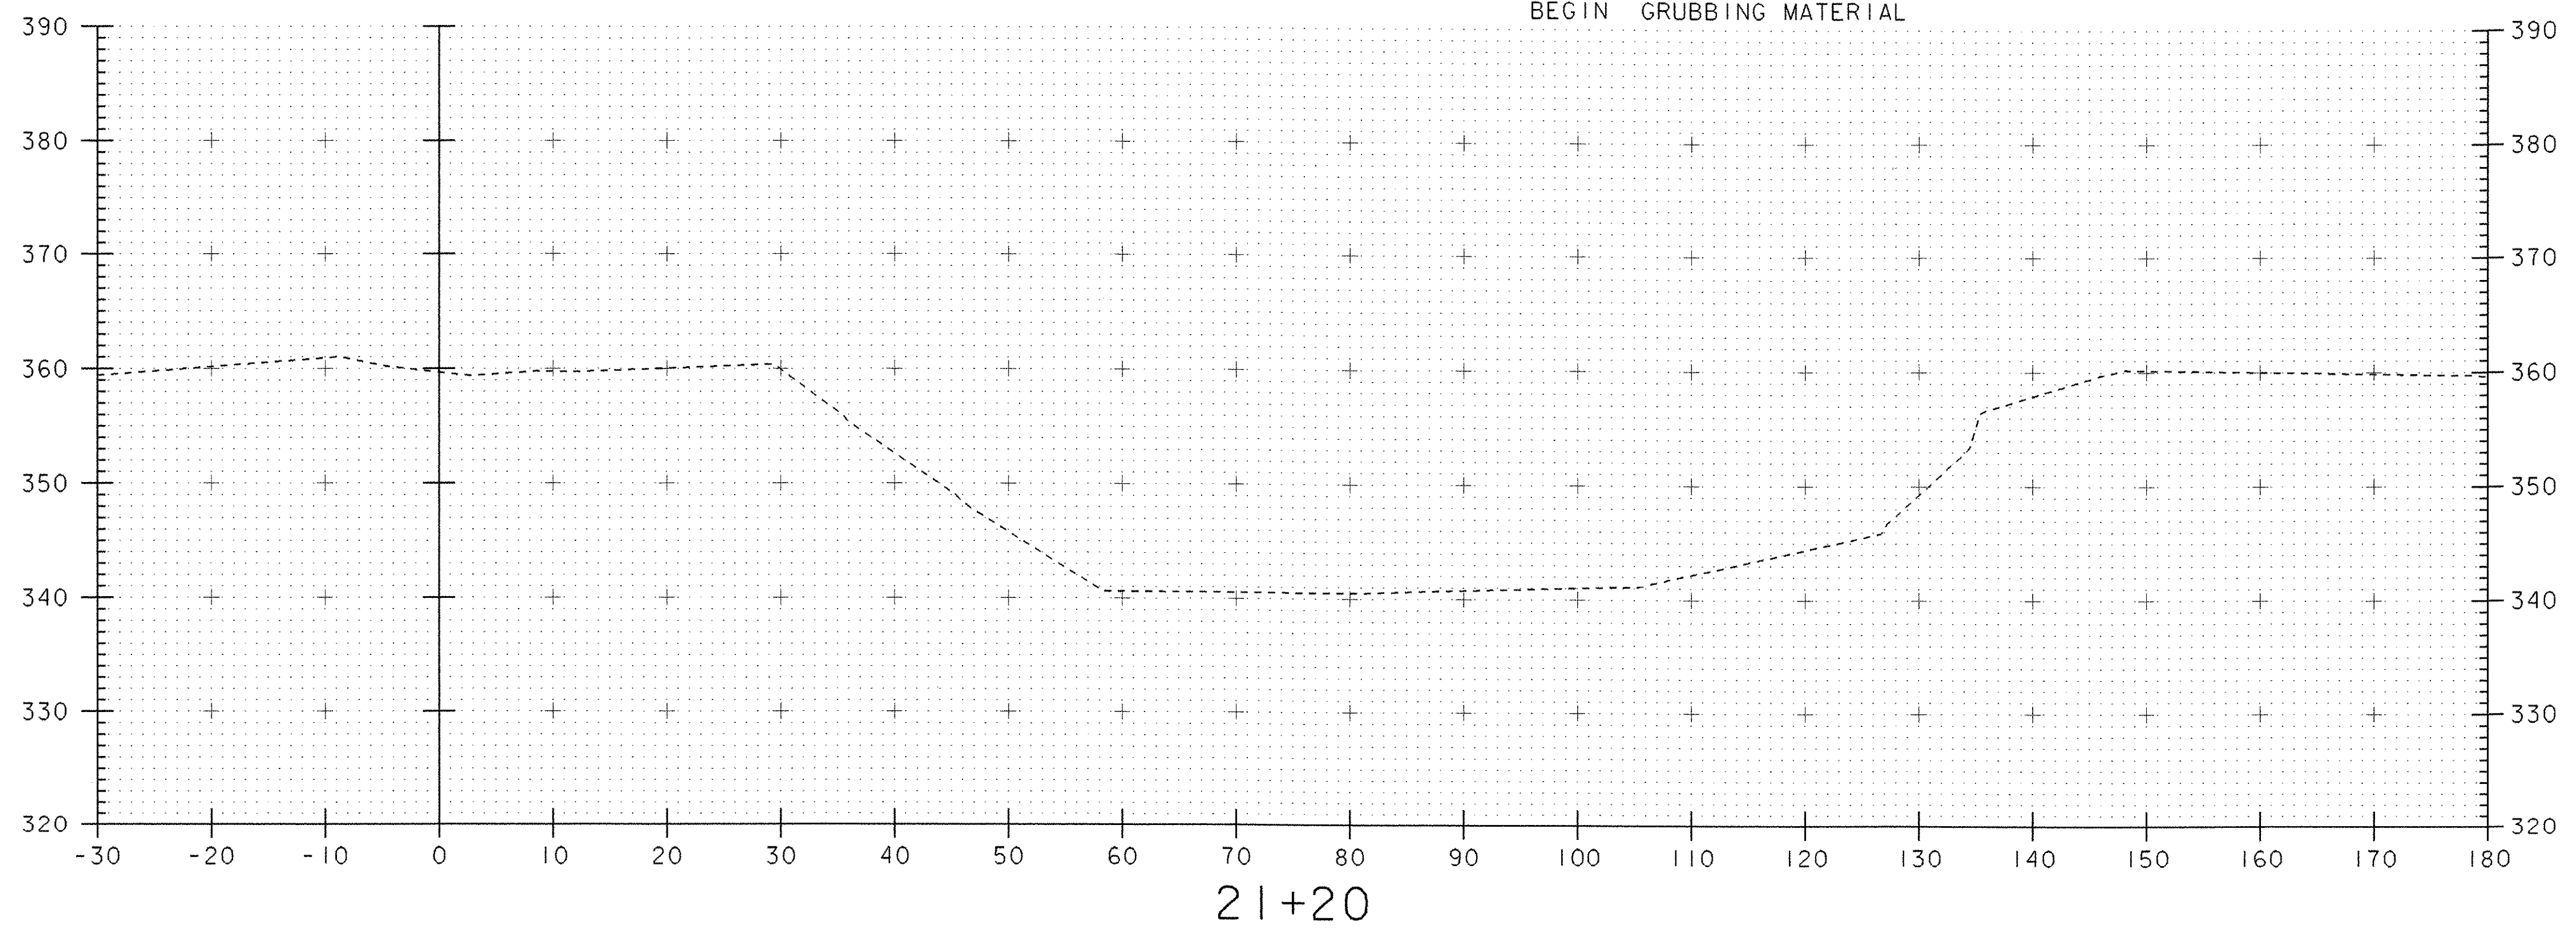

SCALE 1" = 10'-0"
 10 0 10

DATUM
 VERTICAL NAVD 88
 HORIZONTAL NAD 83/92

PROJECT: PROCTOR - PITTSFORD	PROJECT NO.: BHO 1443 (37)
DESIGN FILE NAME: 96J242\Structures\sj242esec.dgn	PLOT DATE: 10-JAN-2003
IPARM FILE NAME: sj242ch7.i	SURVEY DATE: 02-02-98
SURVEYED BY: L. ORVIS	DRAWN BY: T. ANDERSON
SQUAD LEADER: C.P. WILLIAMS	SHEET: 54 OF 60
CHANNEL CROSS SECTIONS	