


1.67
1.5
2.17

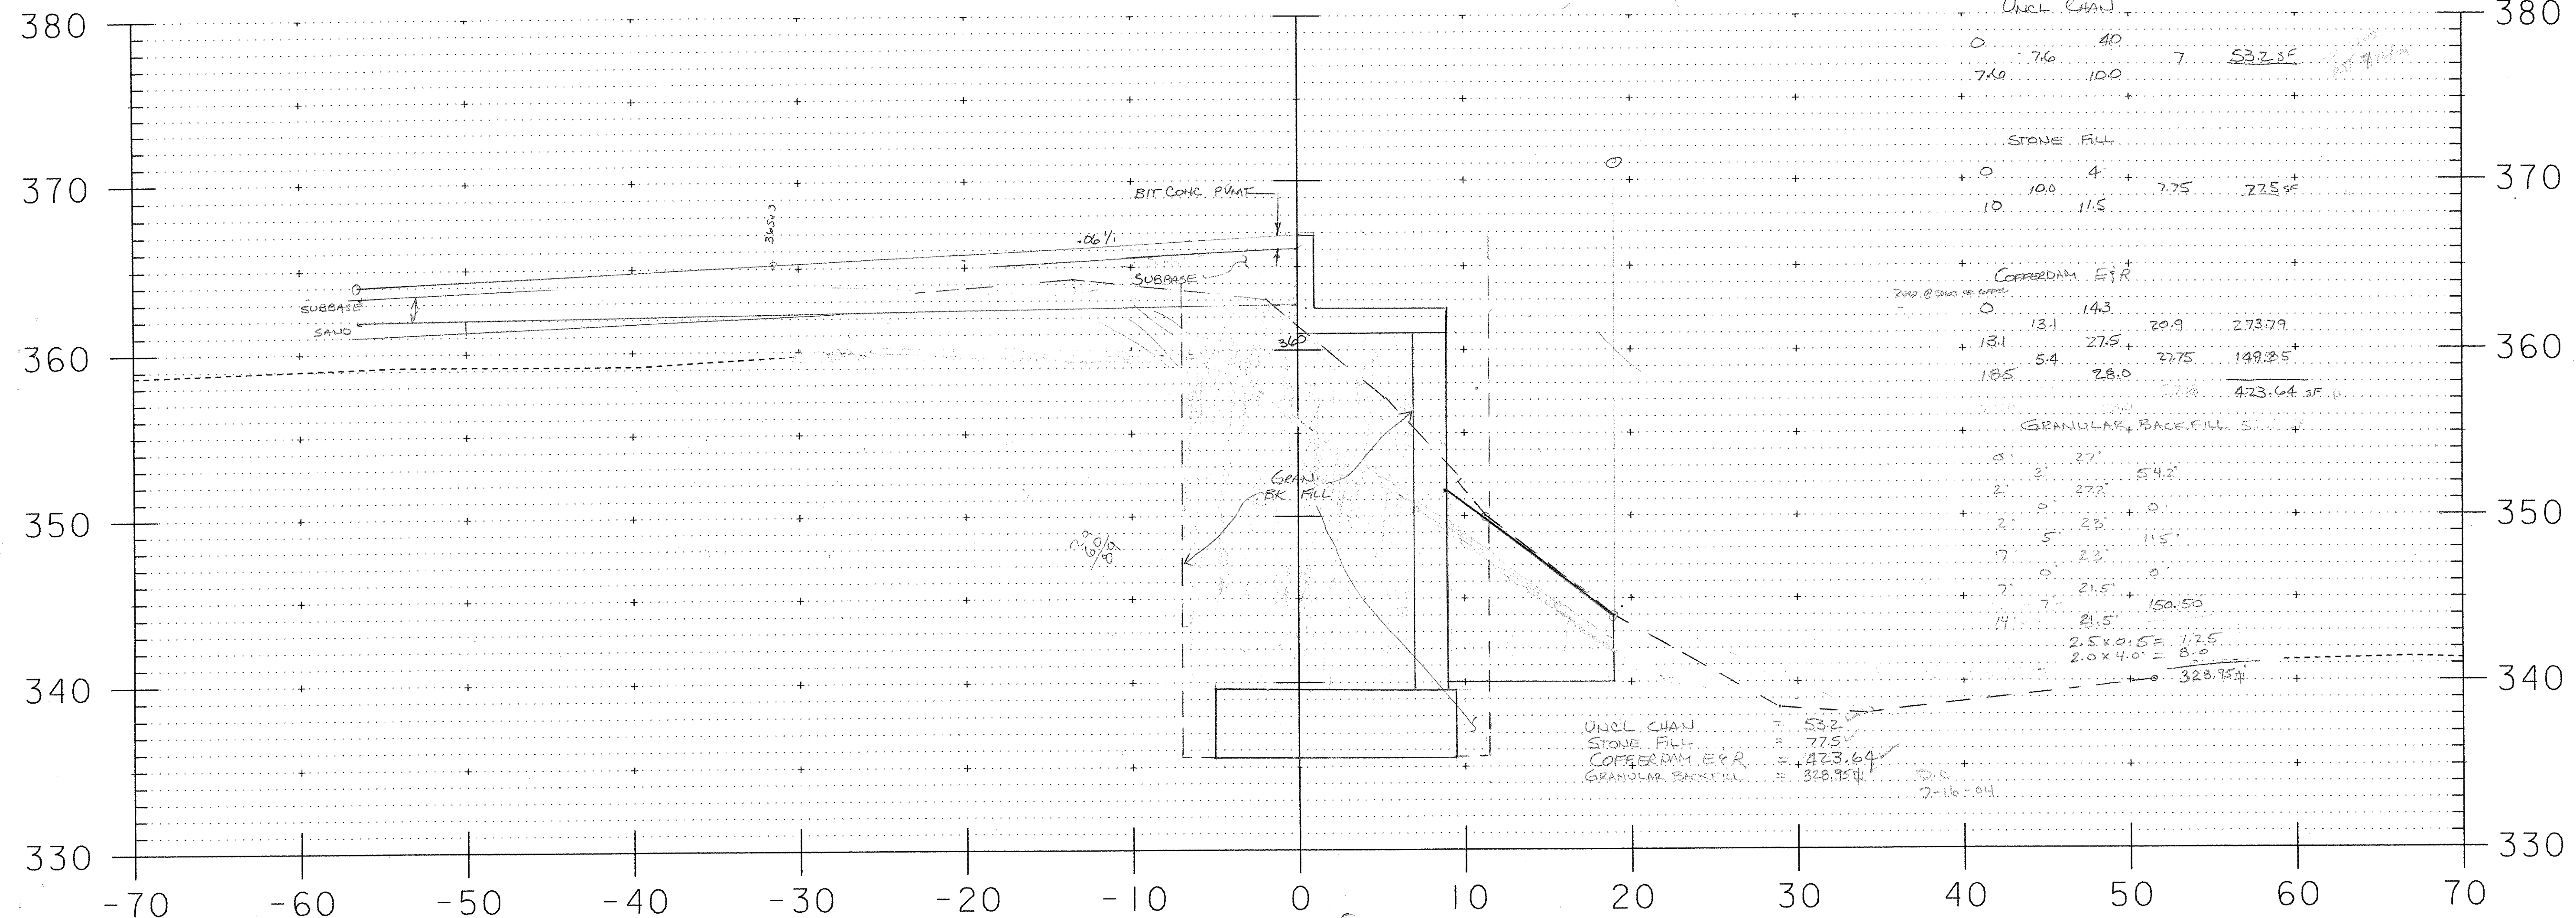

UNCL. CHAN.	0	7.6	40	7	532.0F
STONE FILL	0	100	4	7.75	725.0F
COFFERDAM E.P.R.	0	13.1	143	20.9	273.79
GRANULAR BACKFILL	0	18.1	27.5	27.5	149.25
	0	18.5	28.0		423.64 SF
	0	2	27	54.2	
	0	2	27.2		
	0	2	23	0	
	0	2	23	11.5	
	0	2	21.5	0	
	0	7	21.5	150.50	
	0	14	21.5		
	0		2.5 x 0.5 =	1.25	
	0		2.0 x 4.0 =	8.0	
	0			328.95#	

UNCL. CHAN. = 532
 STONE FILL = 725
 COFFERDAM E.P.R. = 423.64
 GRANULAR BACKFILL = 328.95#

2-16-84

20+87.44