

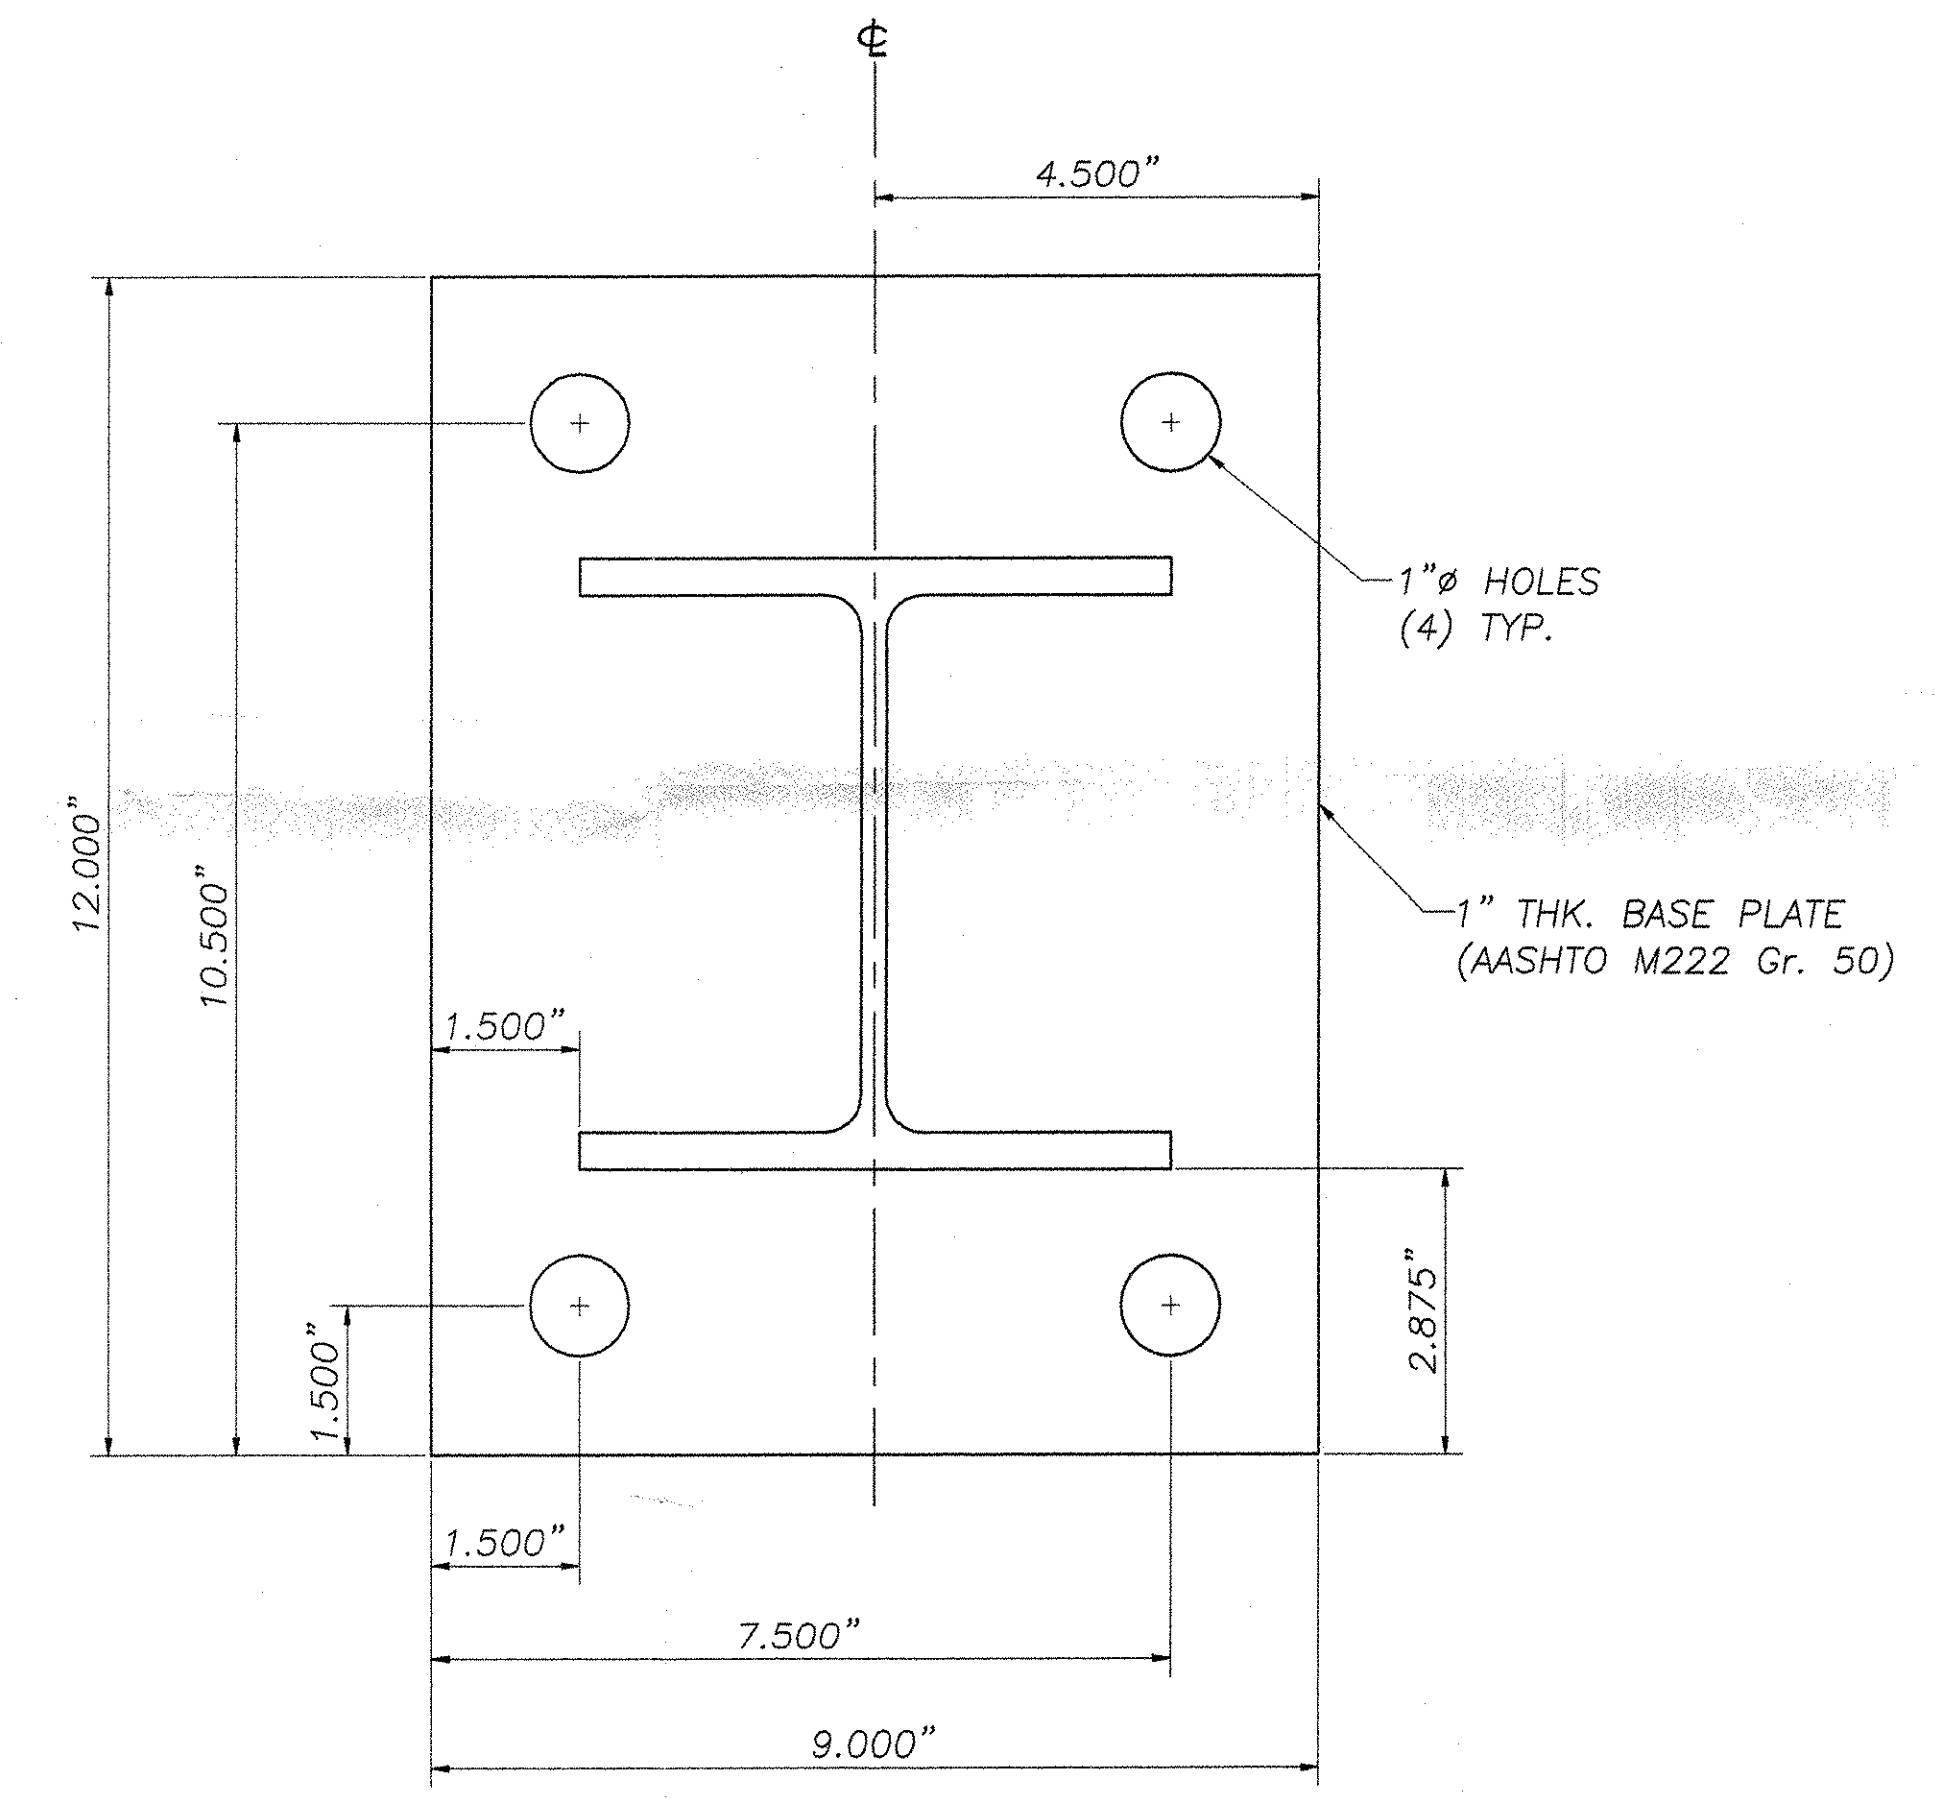


BILL OF MATERIAL					
Mk.	Qty.	Description	Size/Shape	Length/Qty per unit	Material
	4	Base plate	1" x 9"	12"	M222 Gr. 50
	4	Upright Post	W6 x 20	2'-2.875"	M222 Gr. 50

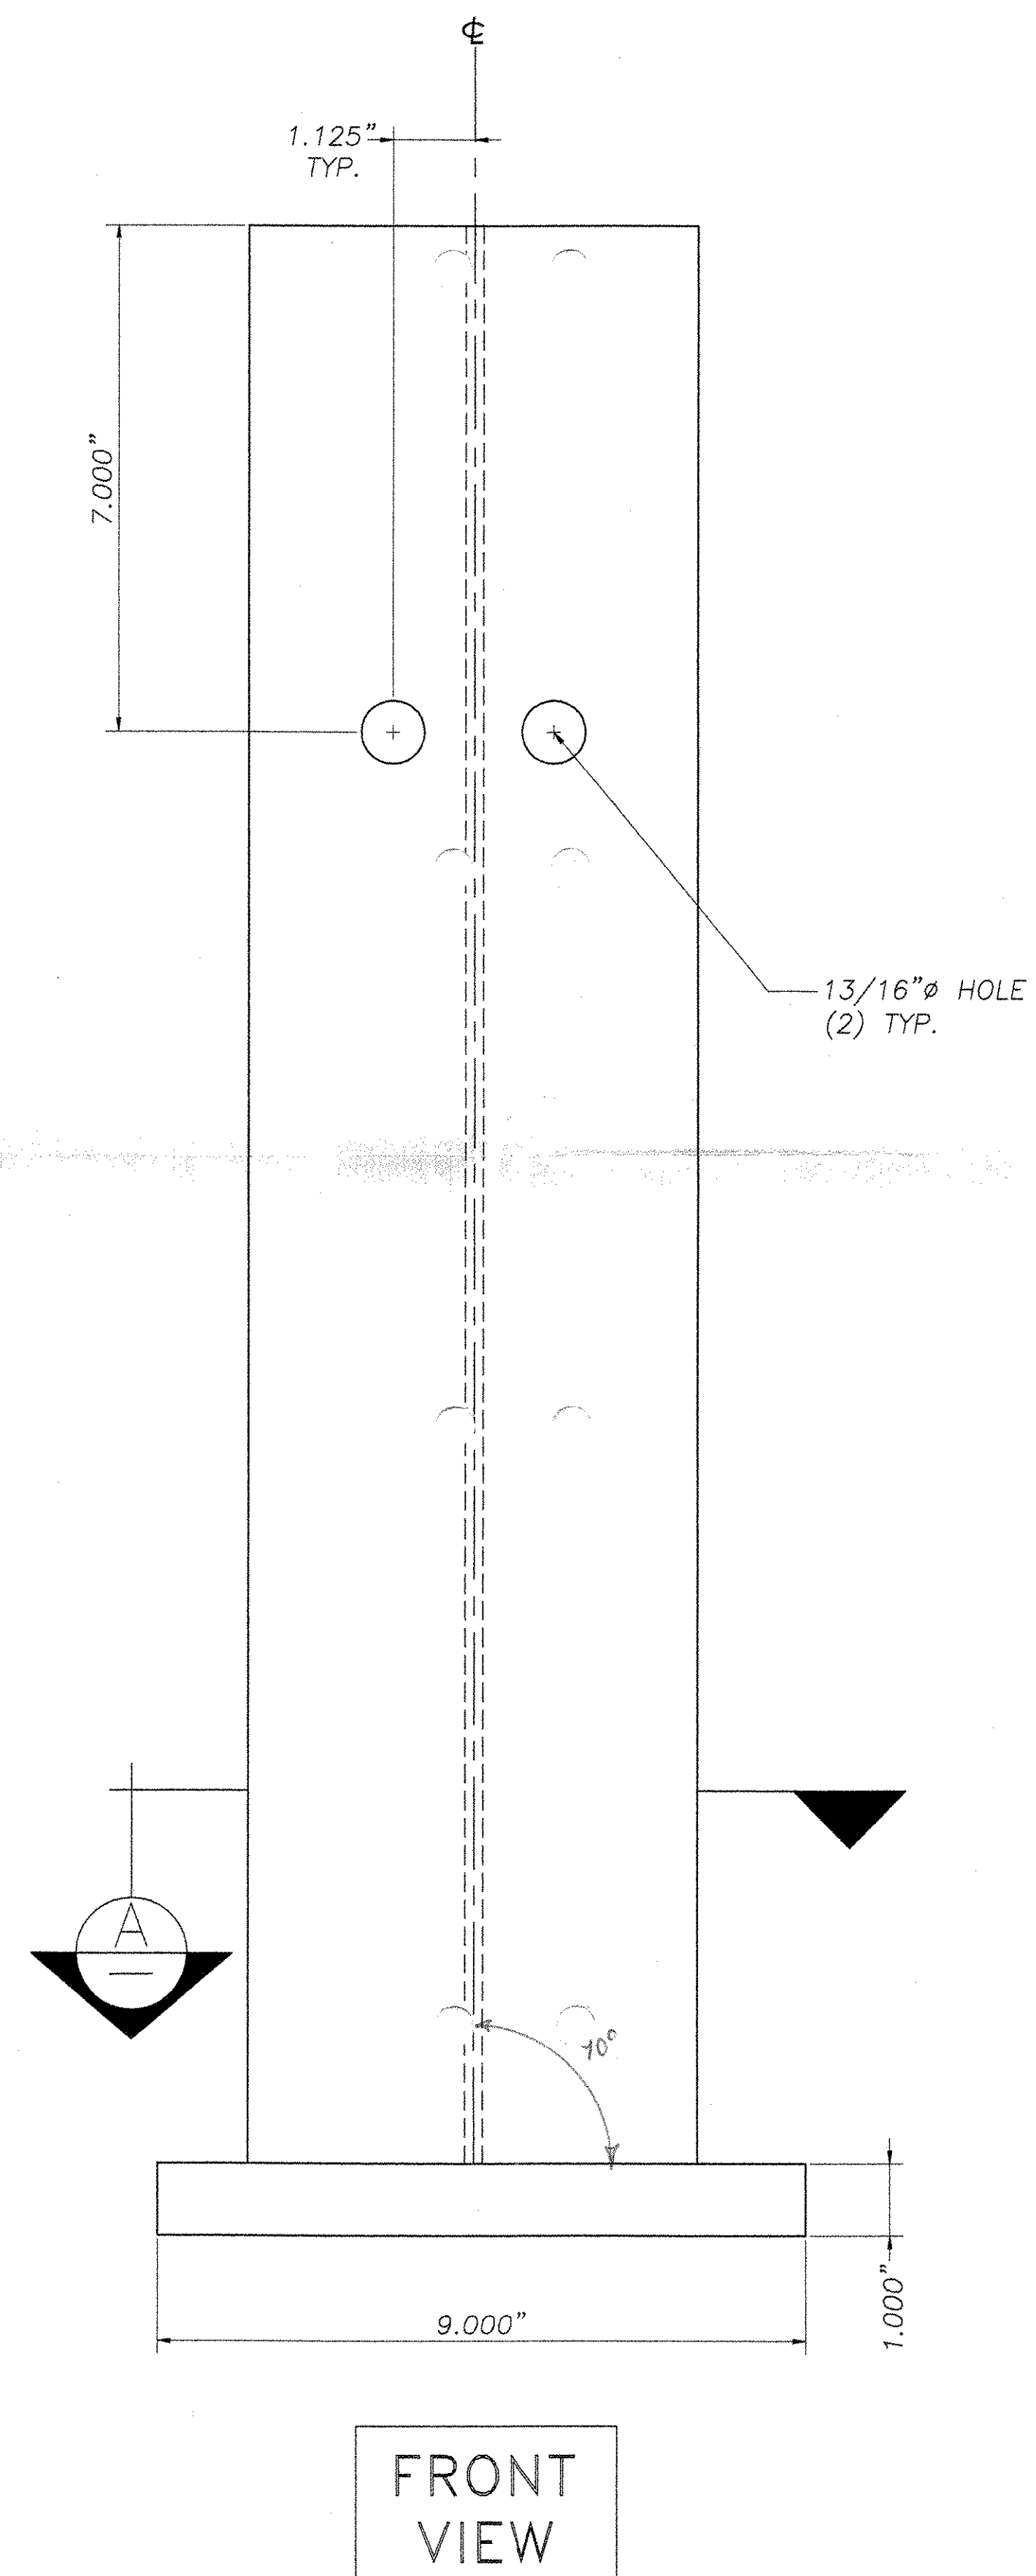

RECEIVED
 OK'D BY *WES* OK'D BY _____
 NOV 13 2003
 RESUBMIT APPROVED *As Shld*
 BY *Wes* DATE *11/15/03*

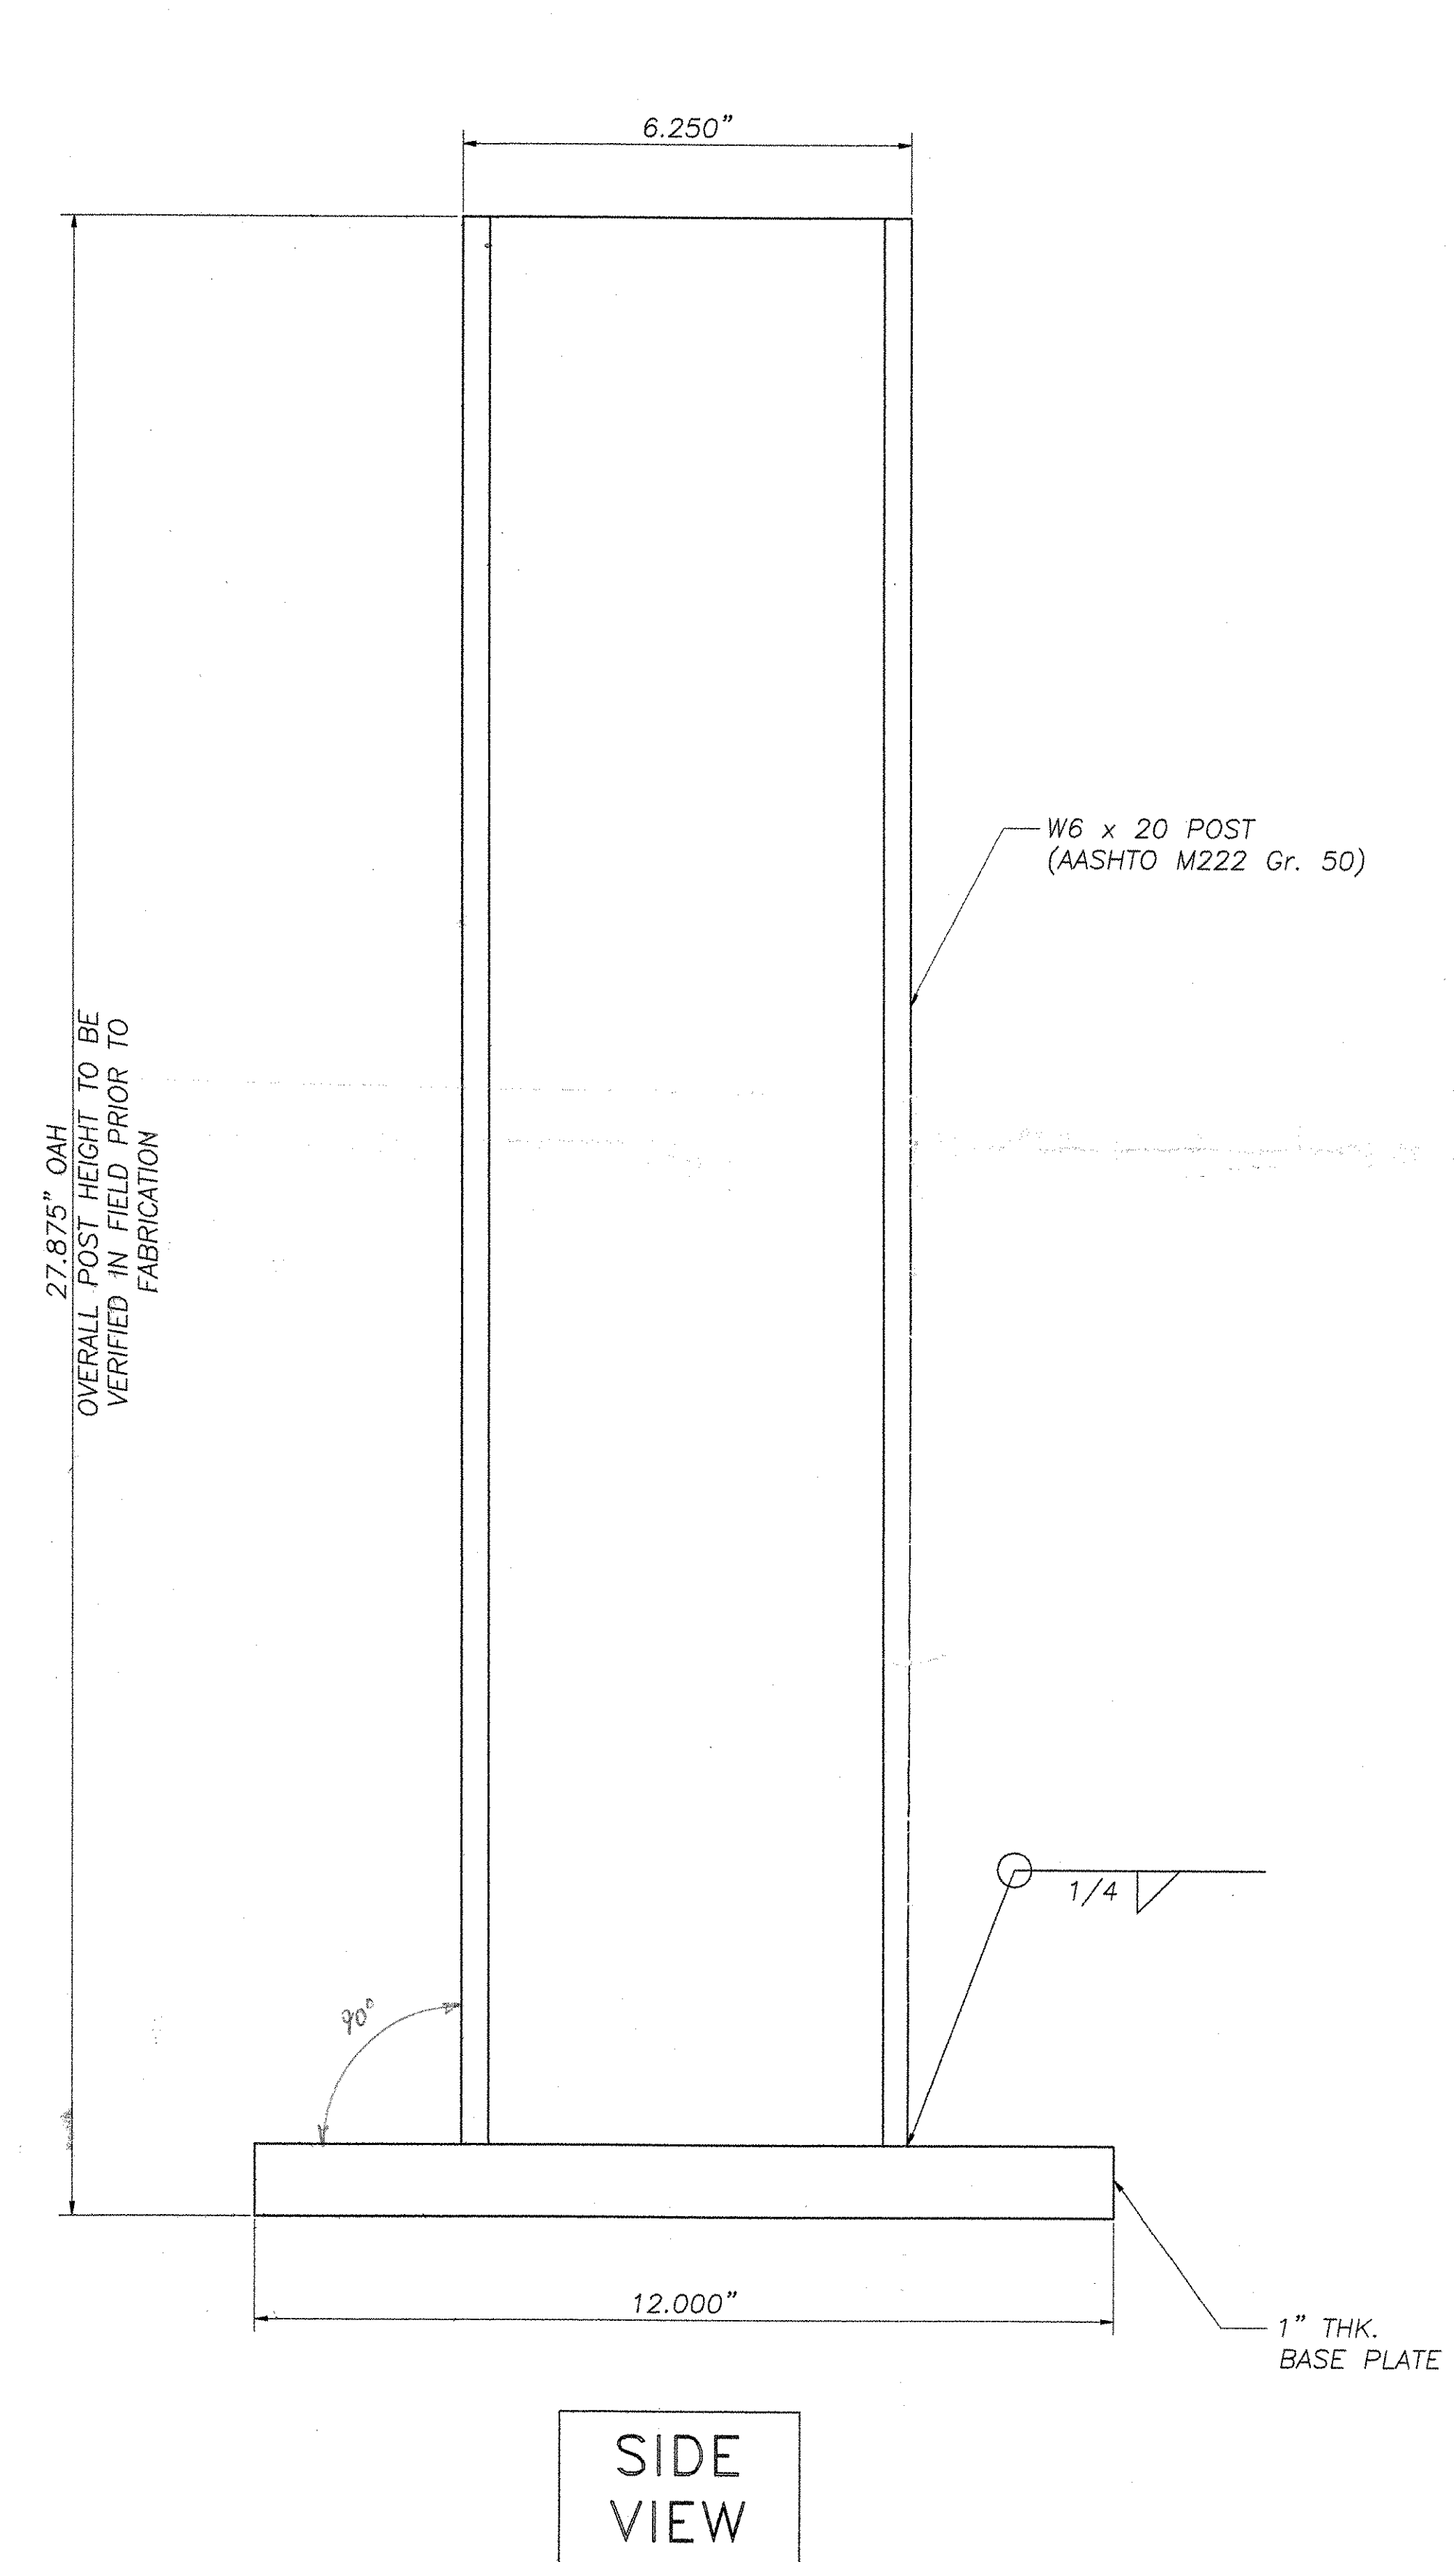

REVISIONS		
No.	Remarks	Date
0	Initial submittal	11-4-03

HIGHWAY SAFETY CORP.
GLASTONBURY, CT

VERMONT PED POST
 P220202 - PITTSDALE Bldg 1943(17)
 FOR STEEL BEAM GUARDRAIL

W6 x 20 2'-3.875" OAH

GENERAL CONTRACTOR
F.R. LAFAYETTE

DRAWN J. Ruiz
 CHECKED *[Signature]*
 DATE 11/5/03
 SCALE NONE
 HSC REFERENCE NO. 1406
 SIZE D REVISION 0
 SHEET NO. 1 of 1