




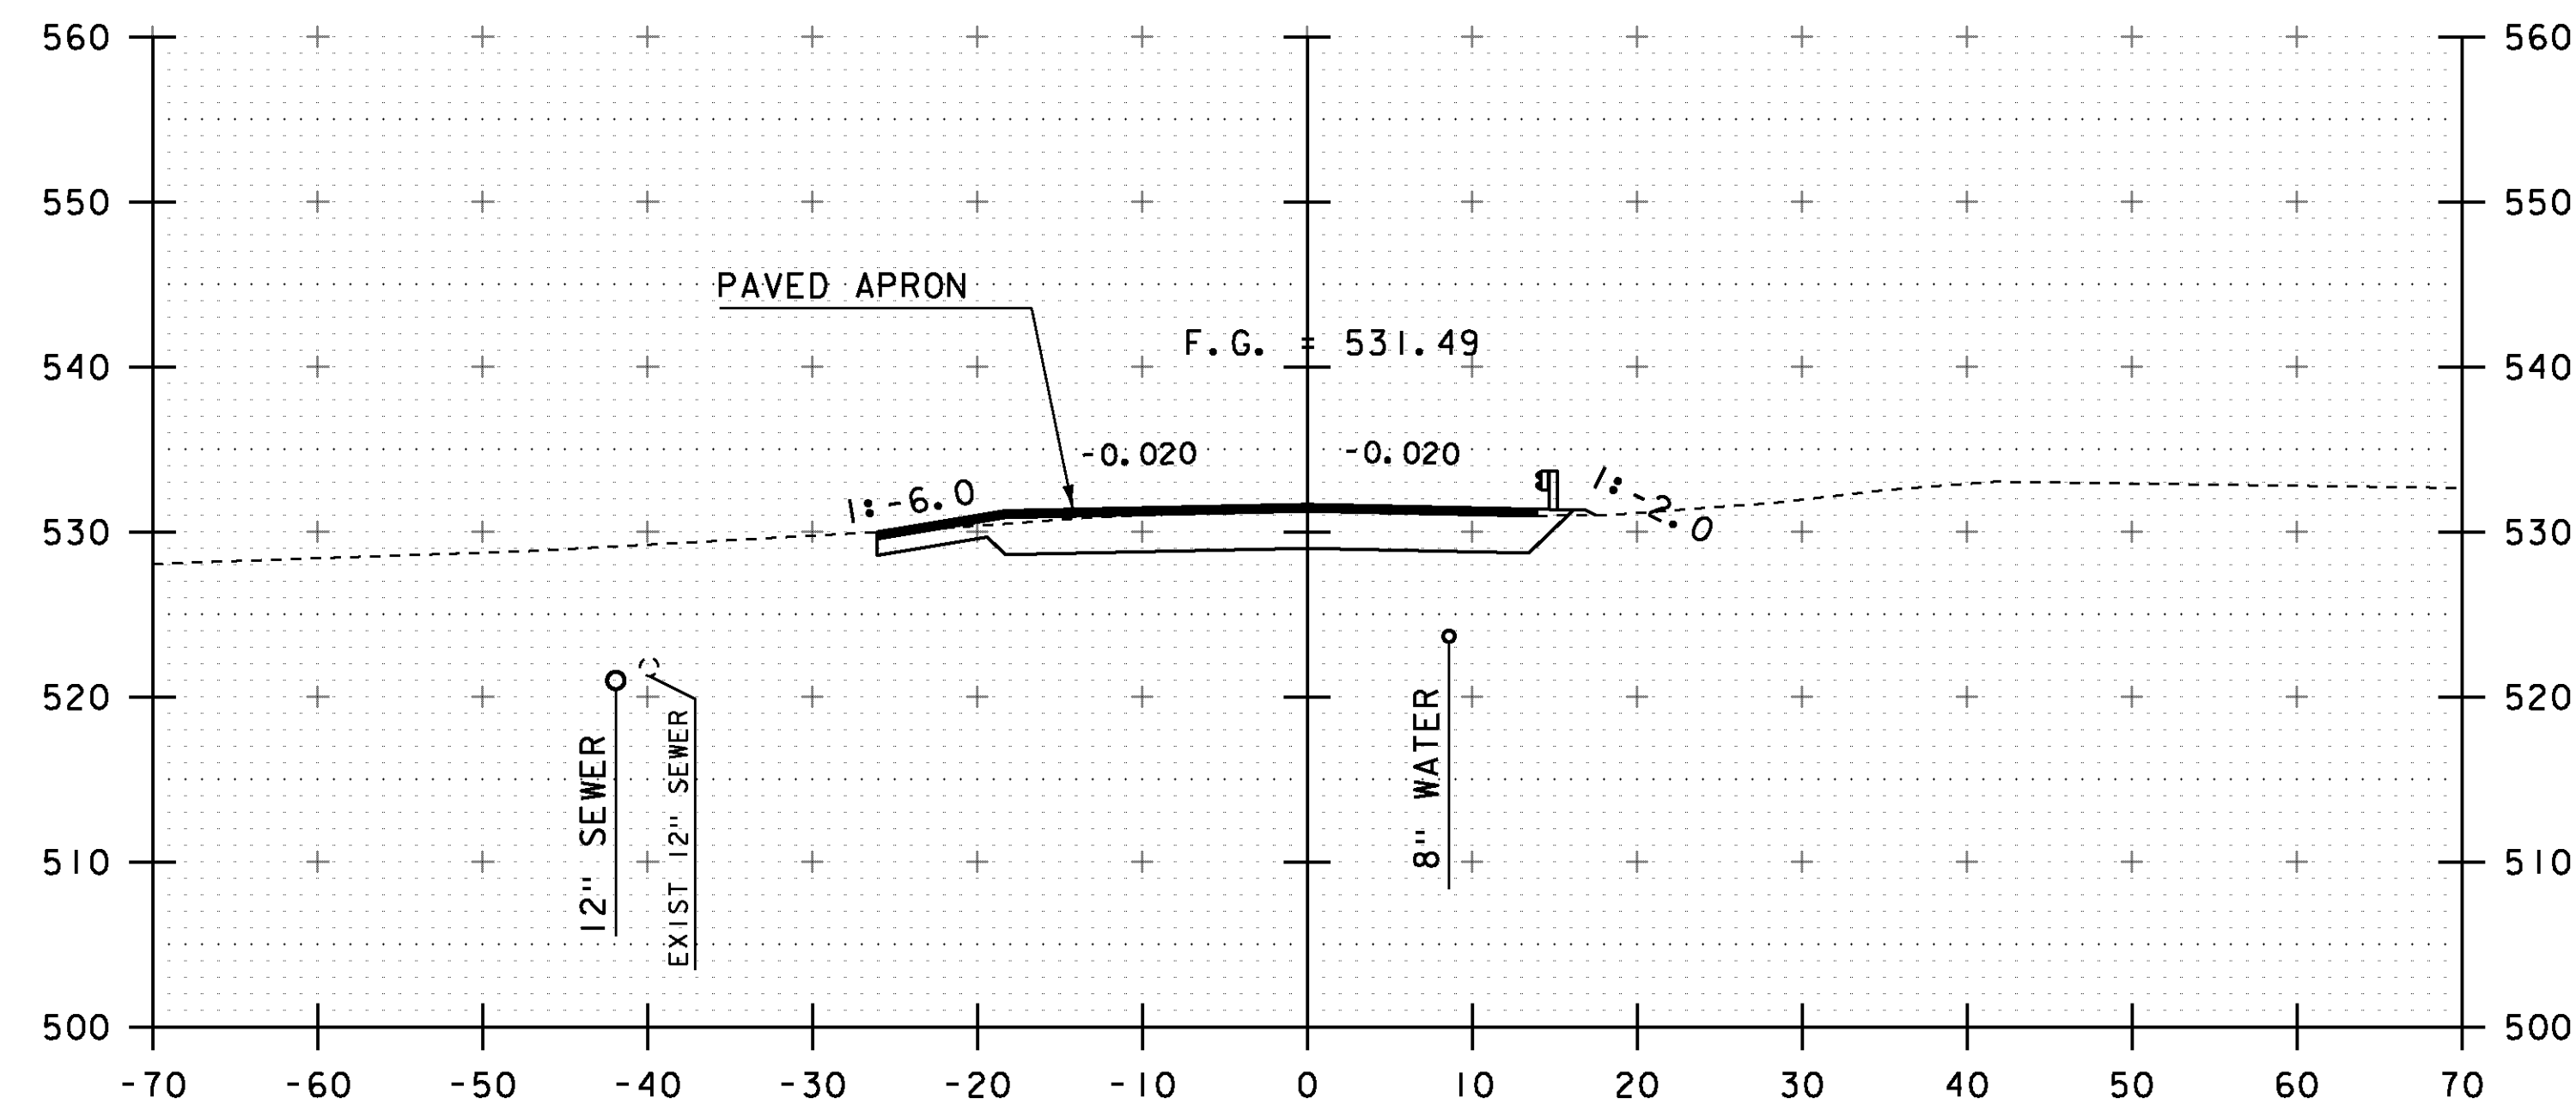


4+50

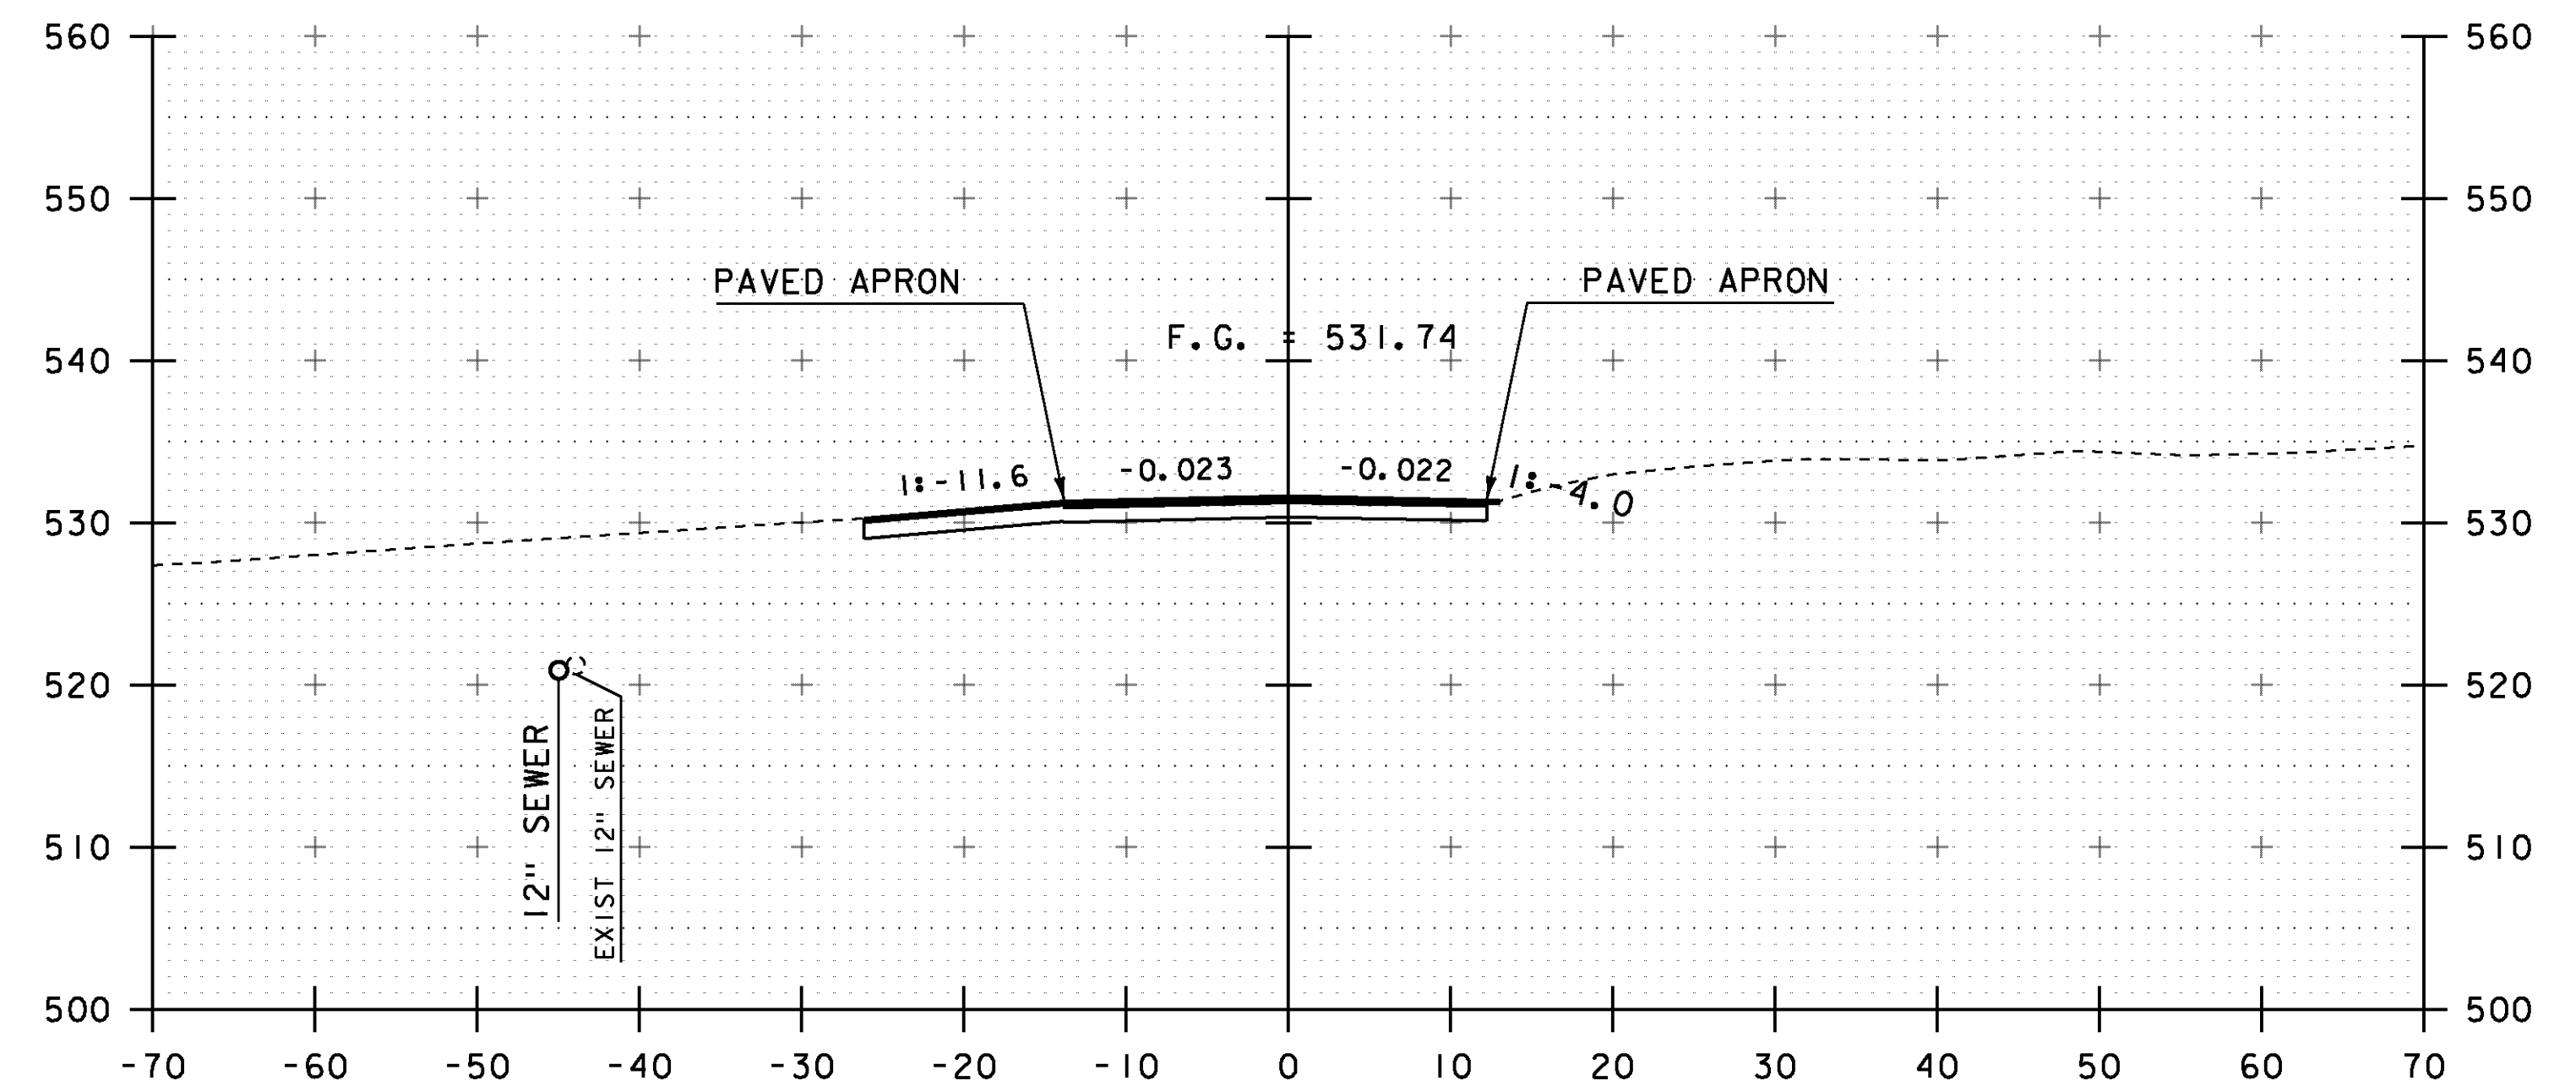

5+00

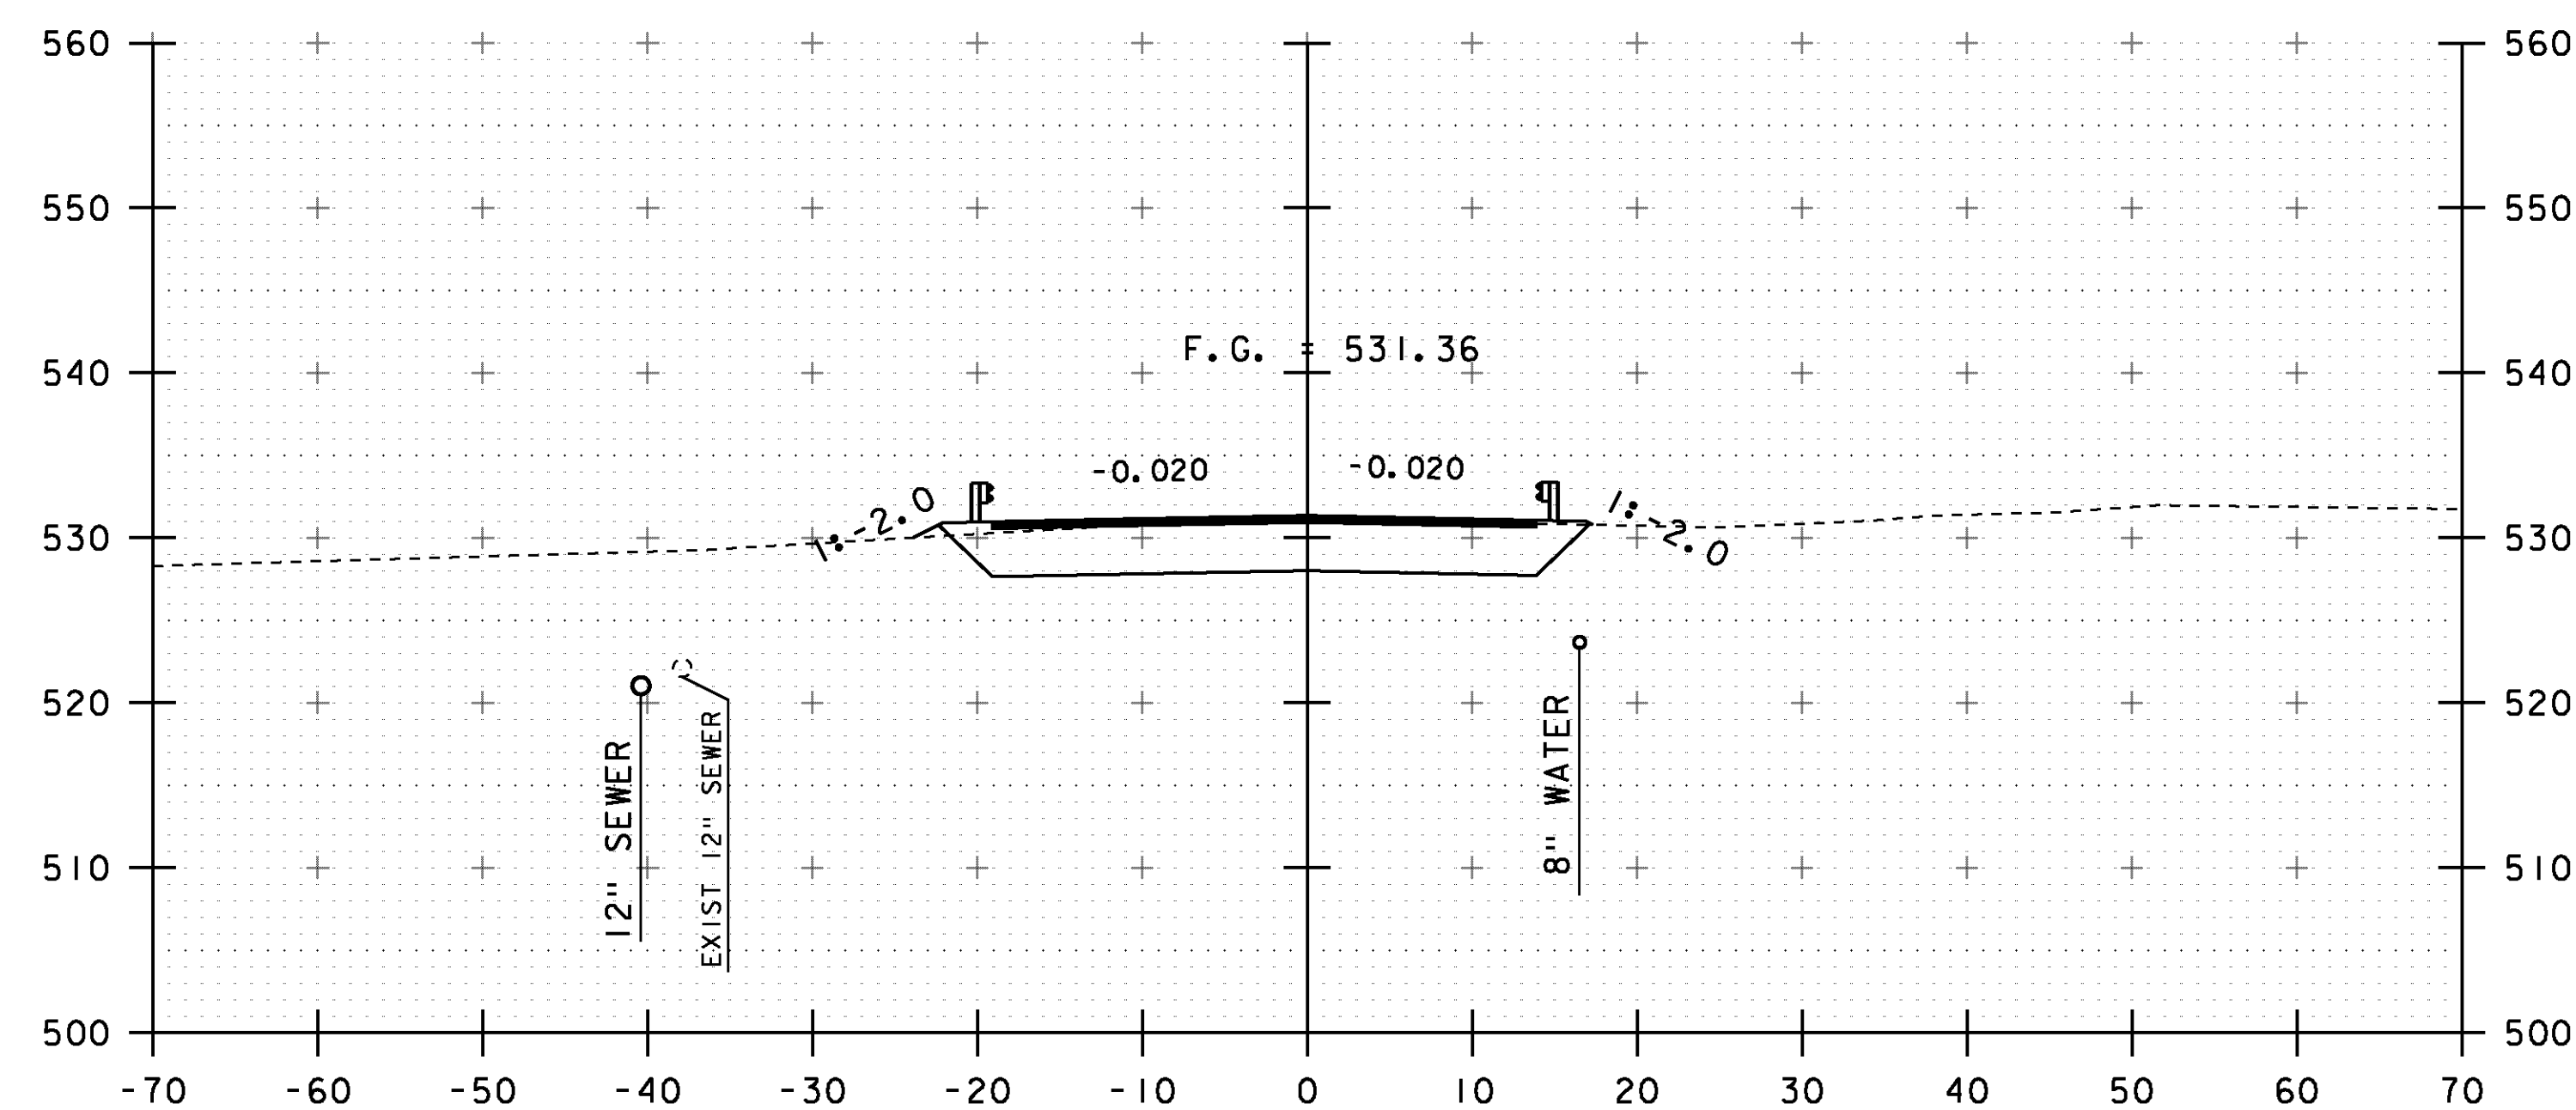

4+25

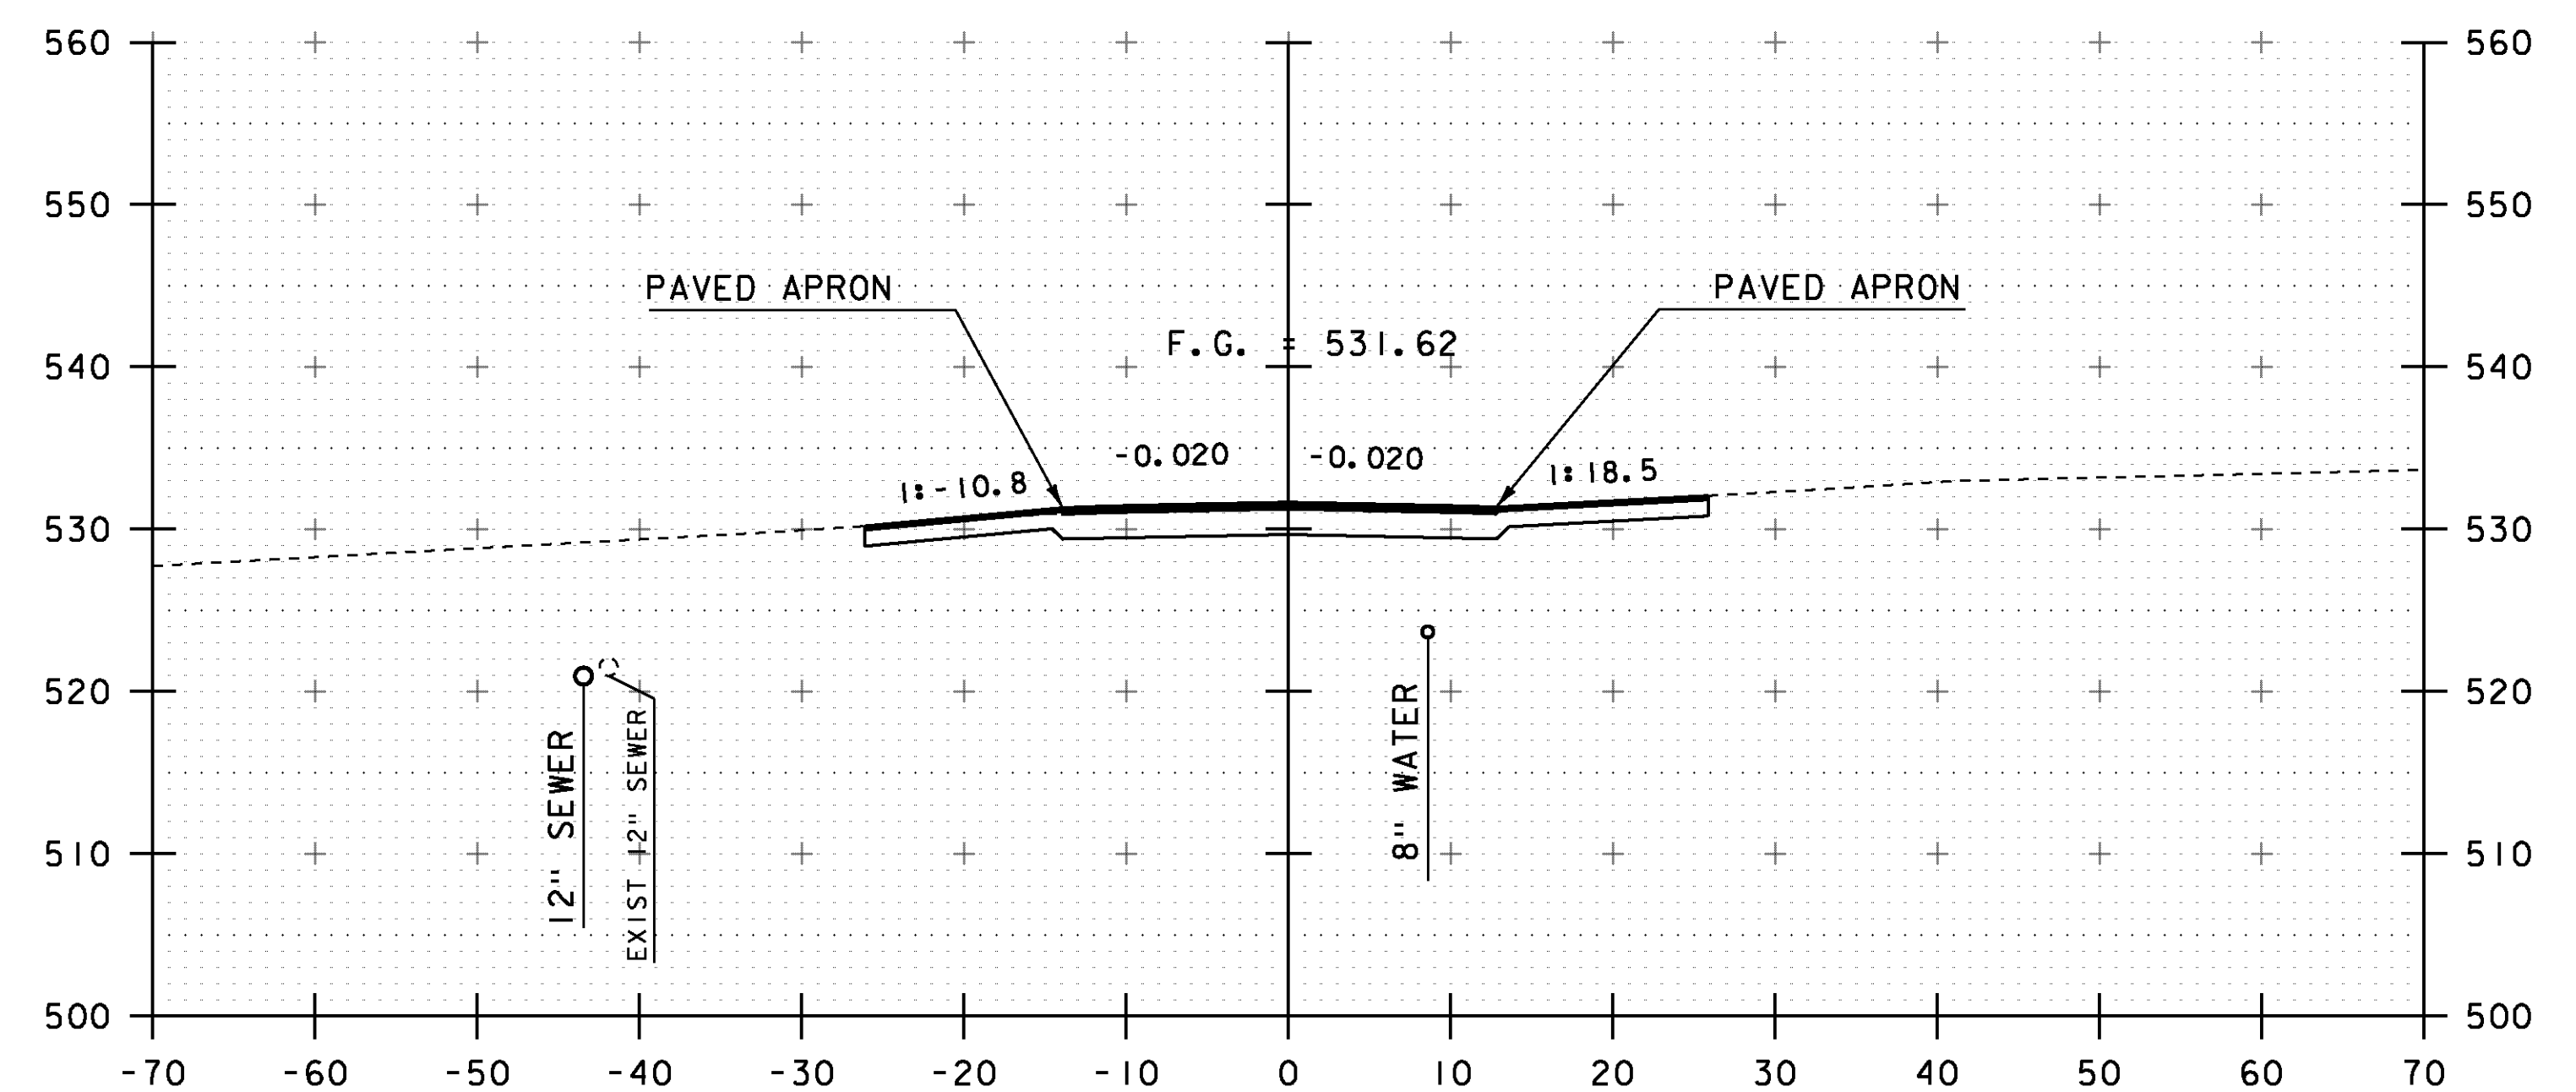

4+75

STA 4+75
END PROJECT
BEGIN APPROACH

STA. 4+25 TO STA. 5+00

PROJECT NAME: RUTLAND CITY	
PROJECT NUMBER: BRF 3000(18)	
FILE NAME: s96j244xs.dgn	PLOT DATE: 28-FEB-2014
PROJECT LEADER: C. CARLSON	DRAWN BY: R. PELLETT
DESIGNED BY: M. EVANS-MONGEON	CHECKED BY: M. E-M
MAINLINE CROSS SECTIONS 4	SHEET 30 OF 44