




STA 8+27.61
END NON-PARTICIPATING PAVING

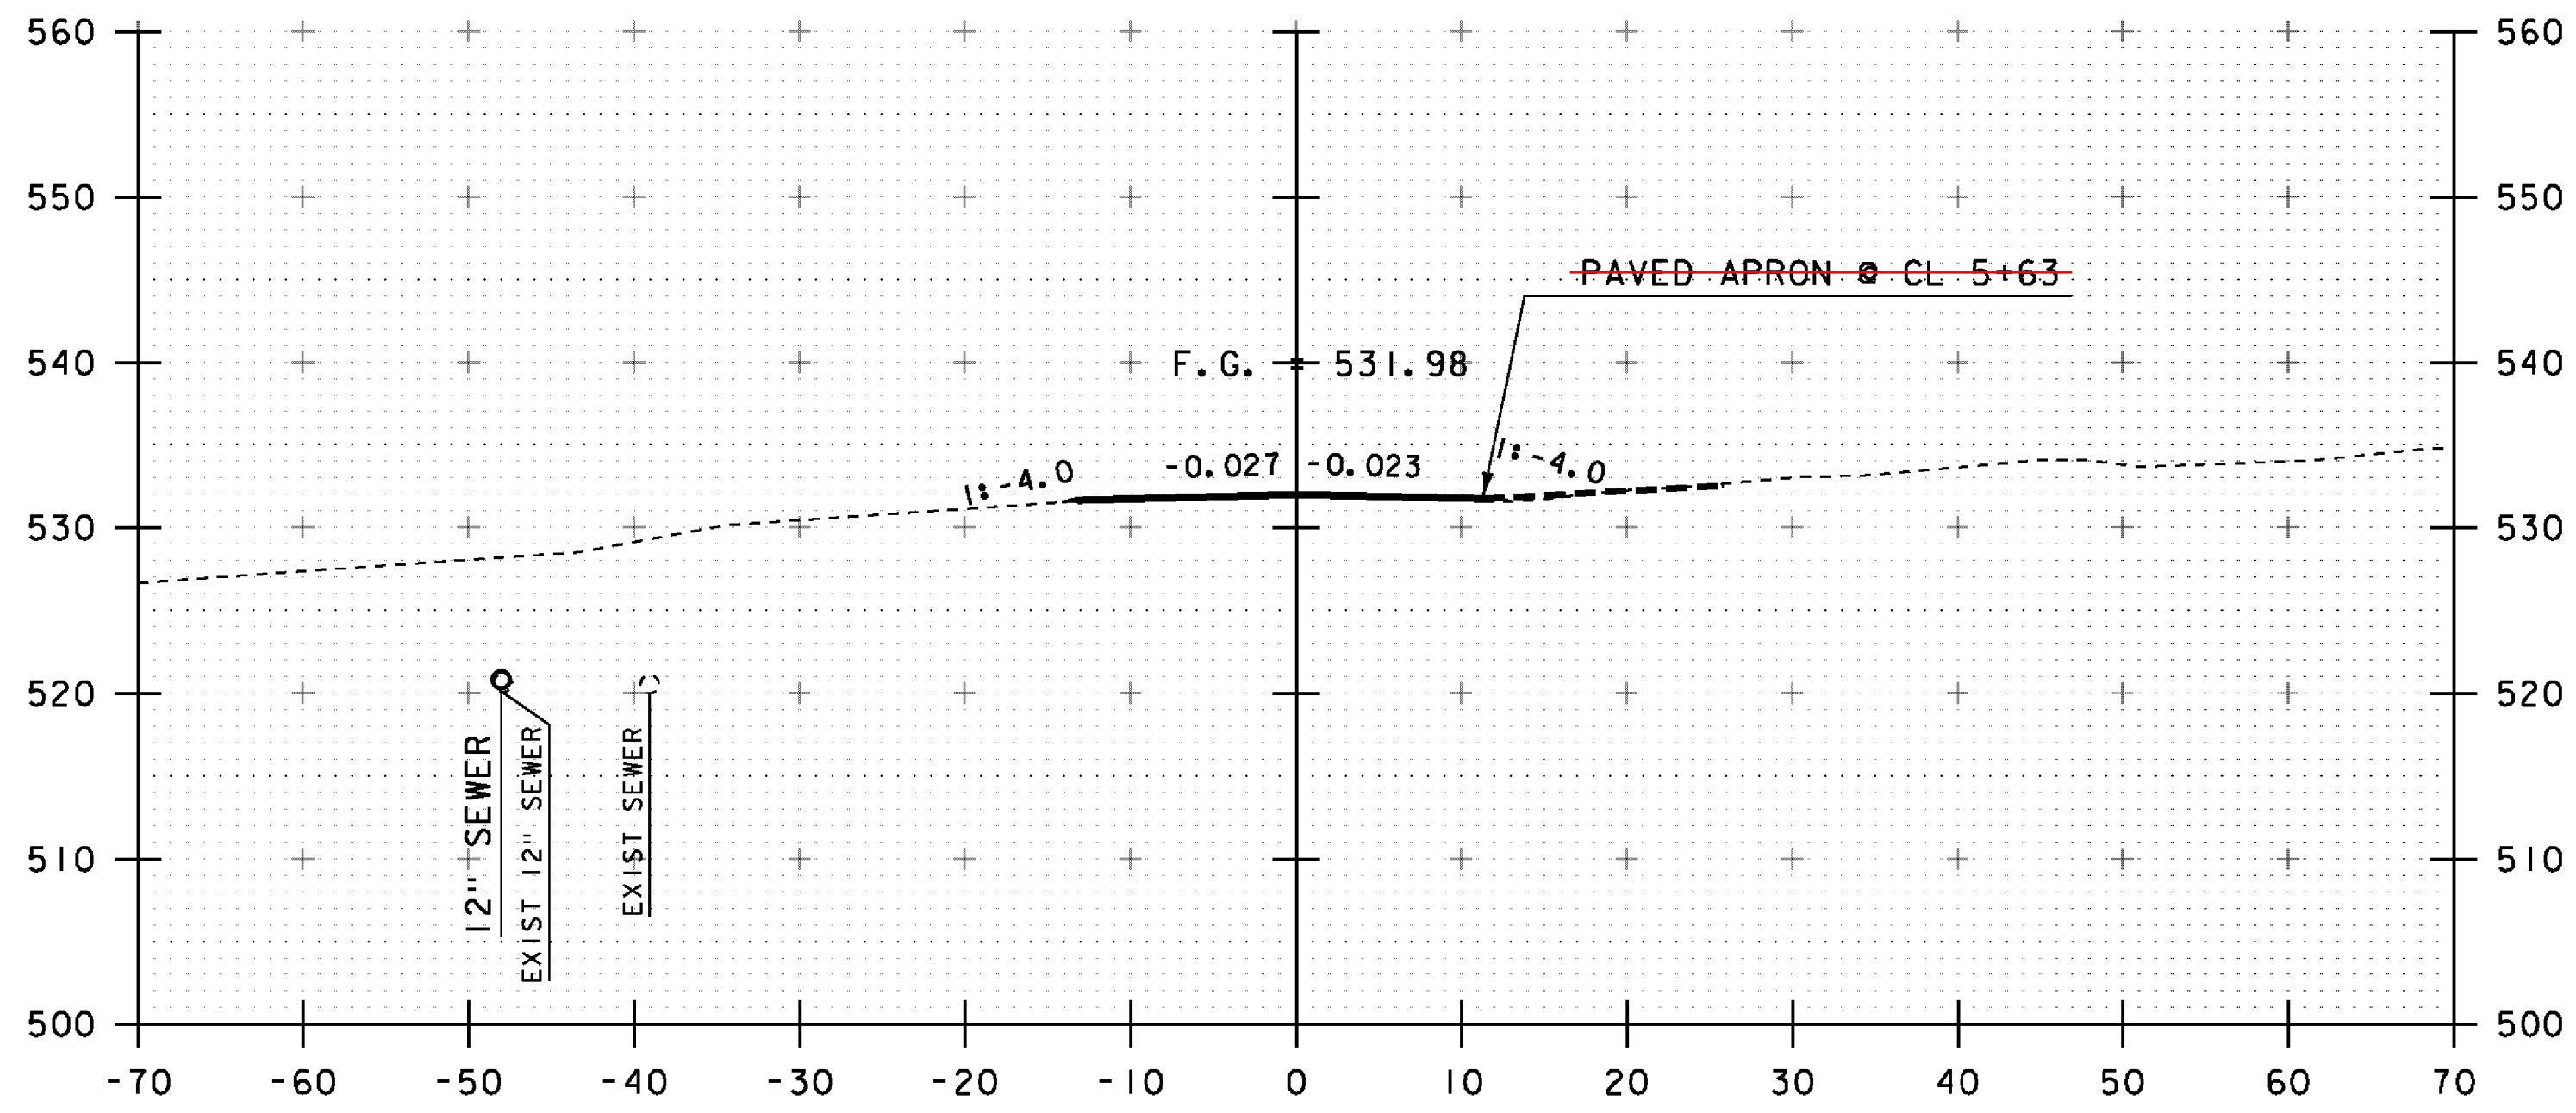


5+50

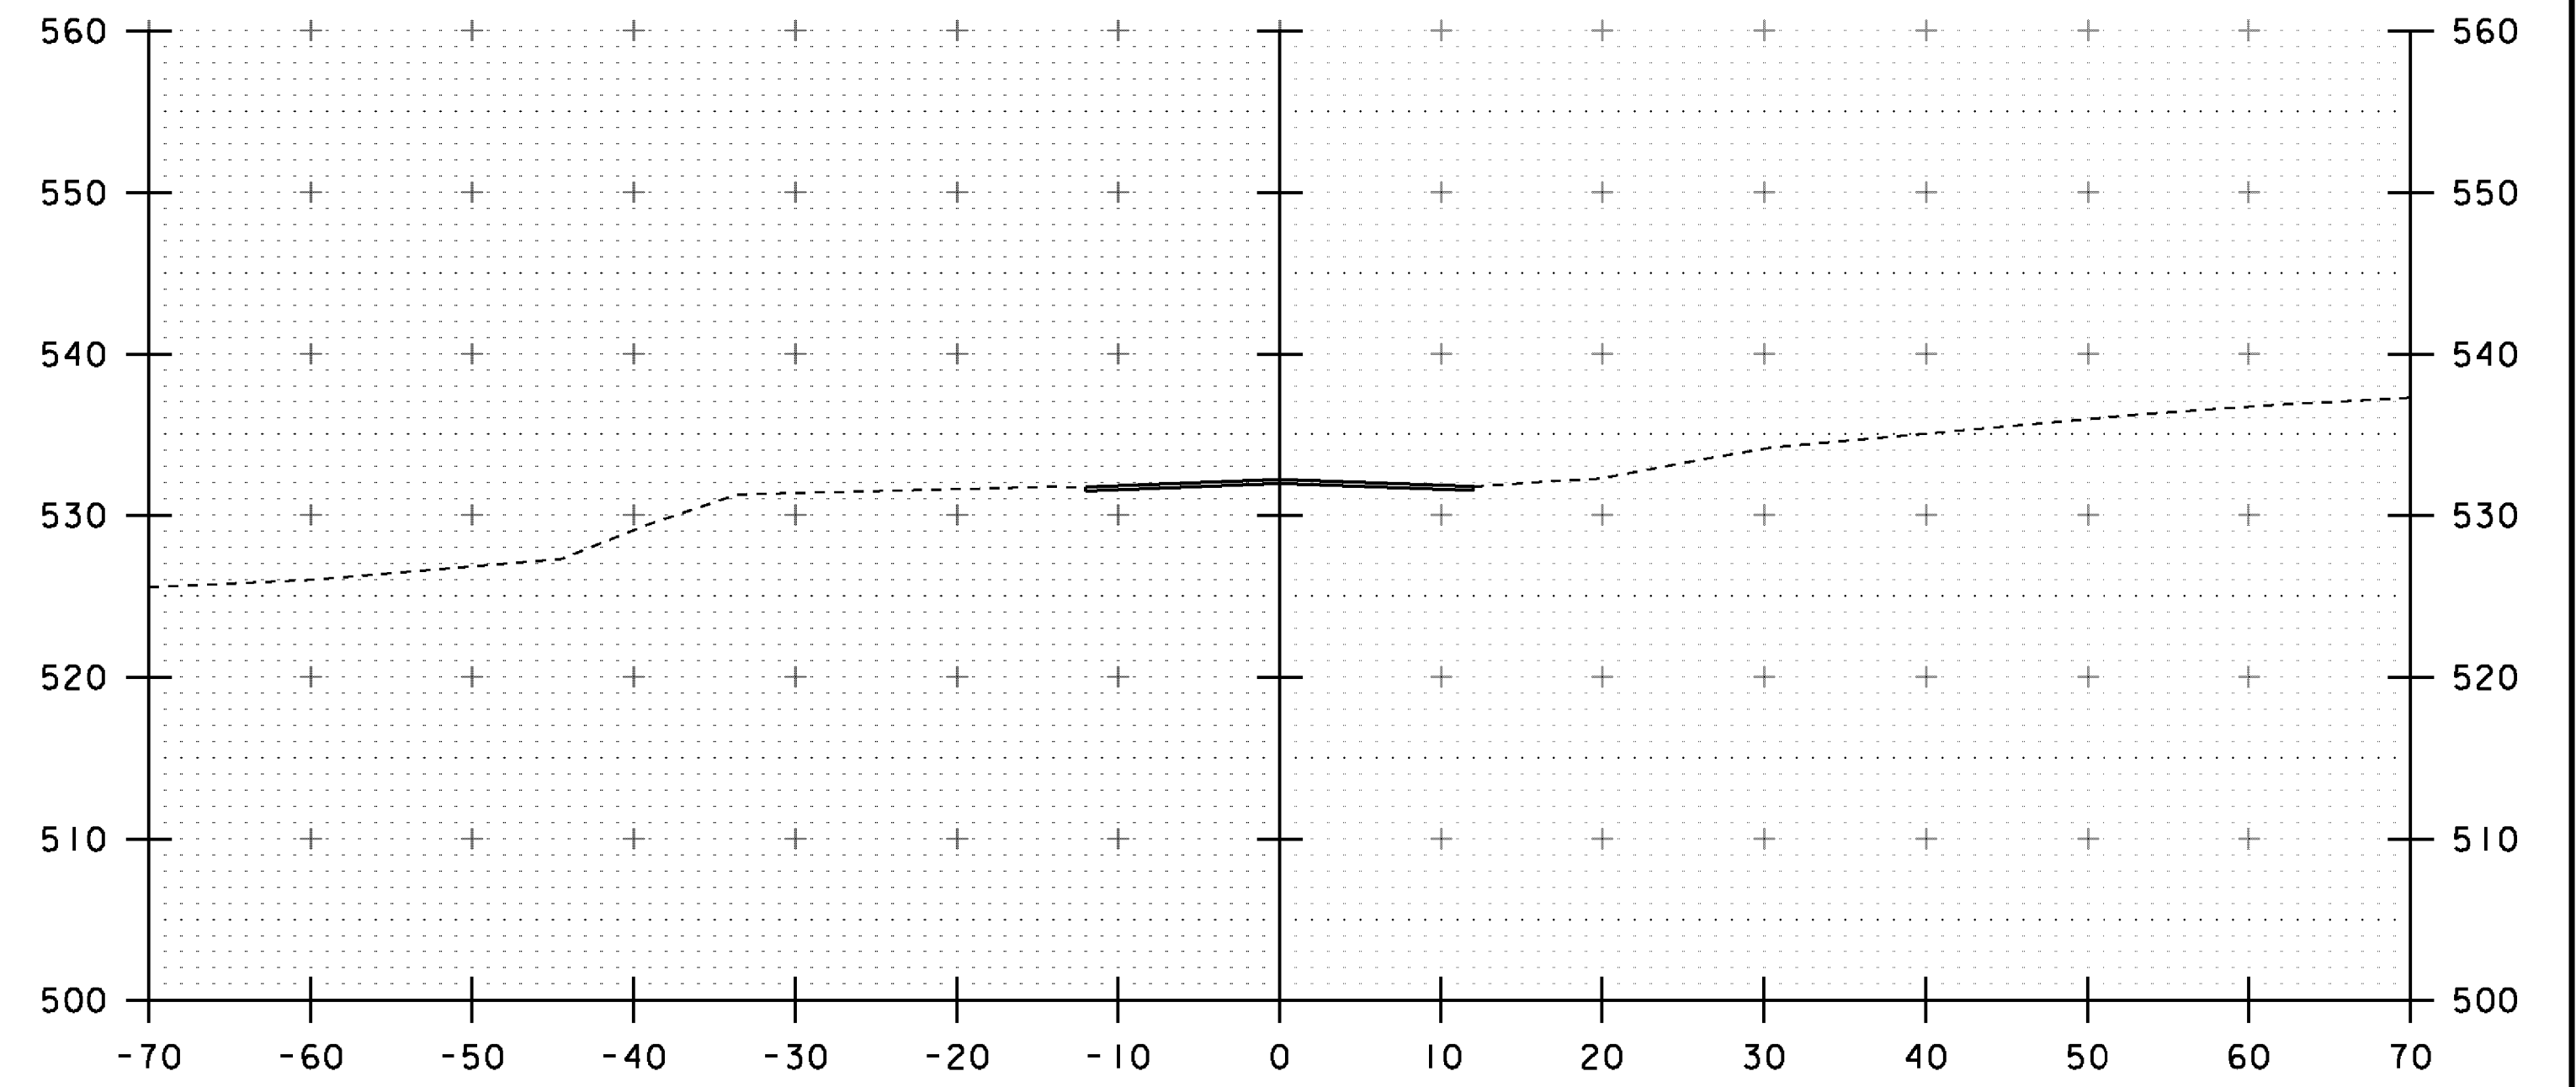

6+00

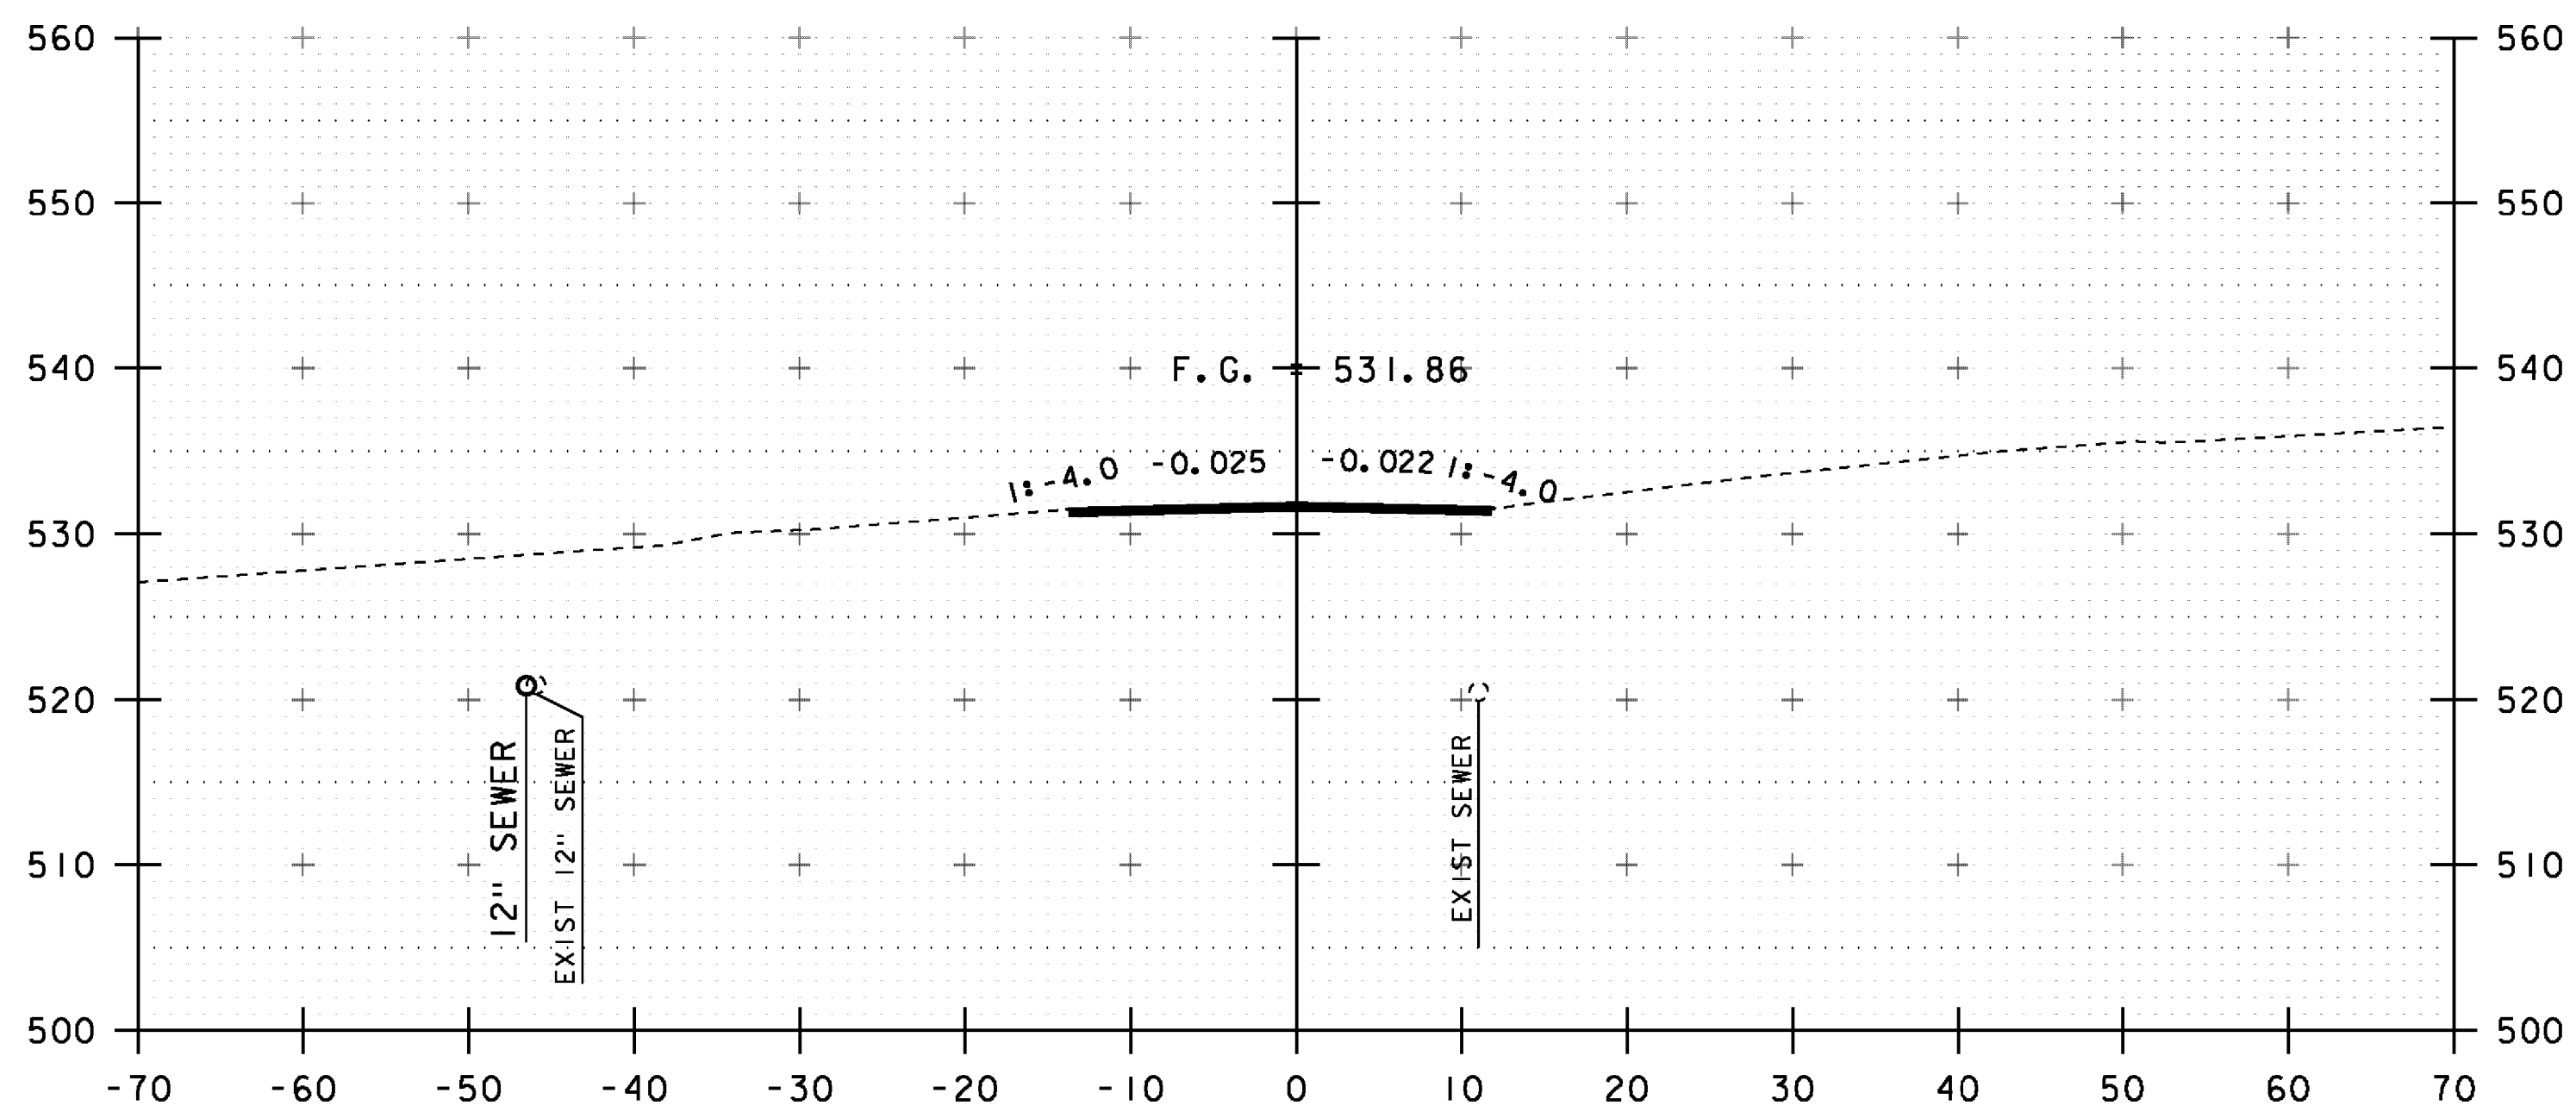

5+25

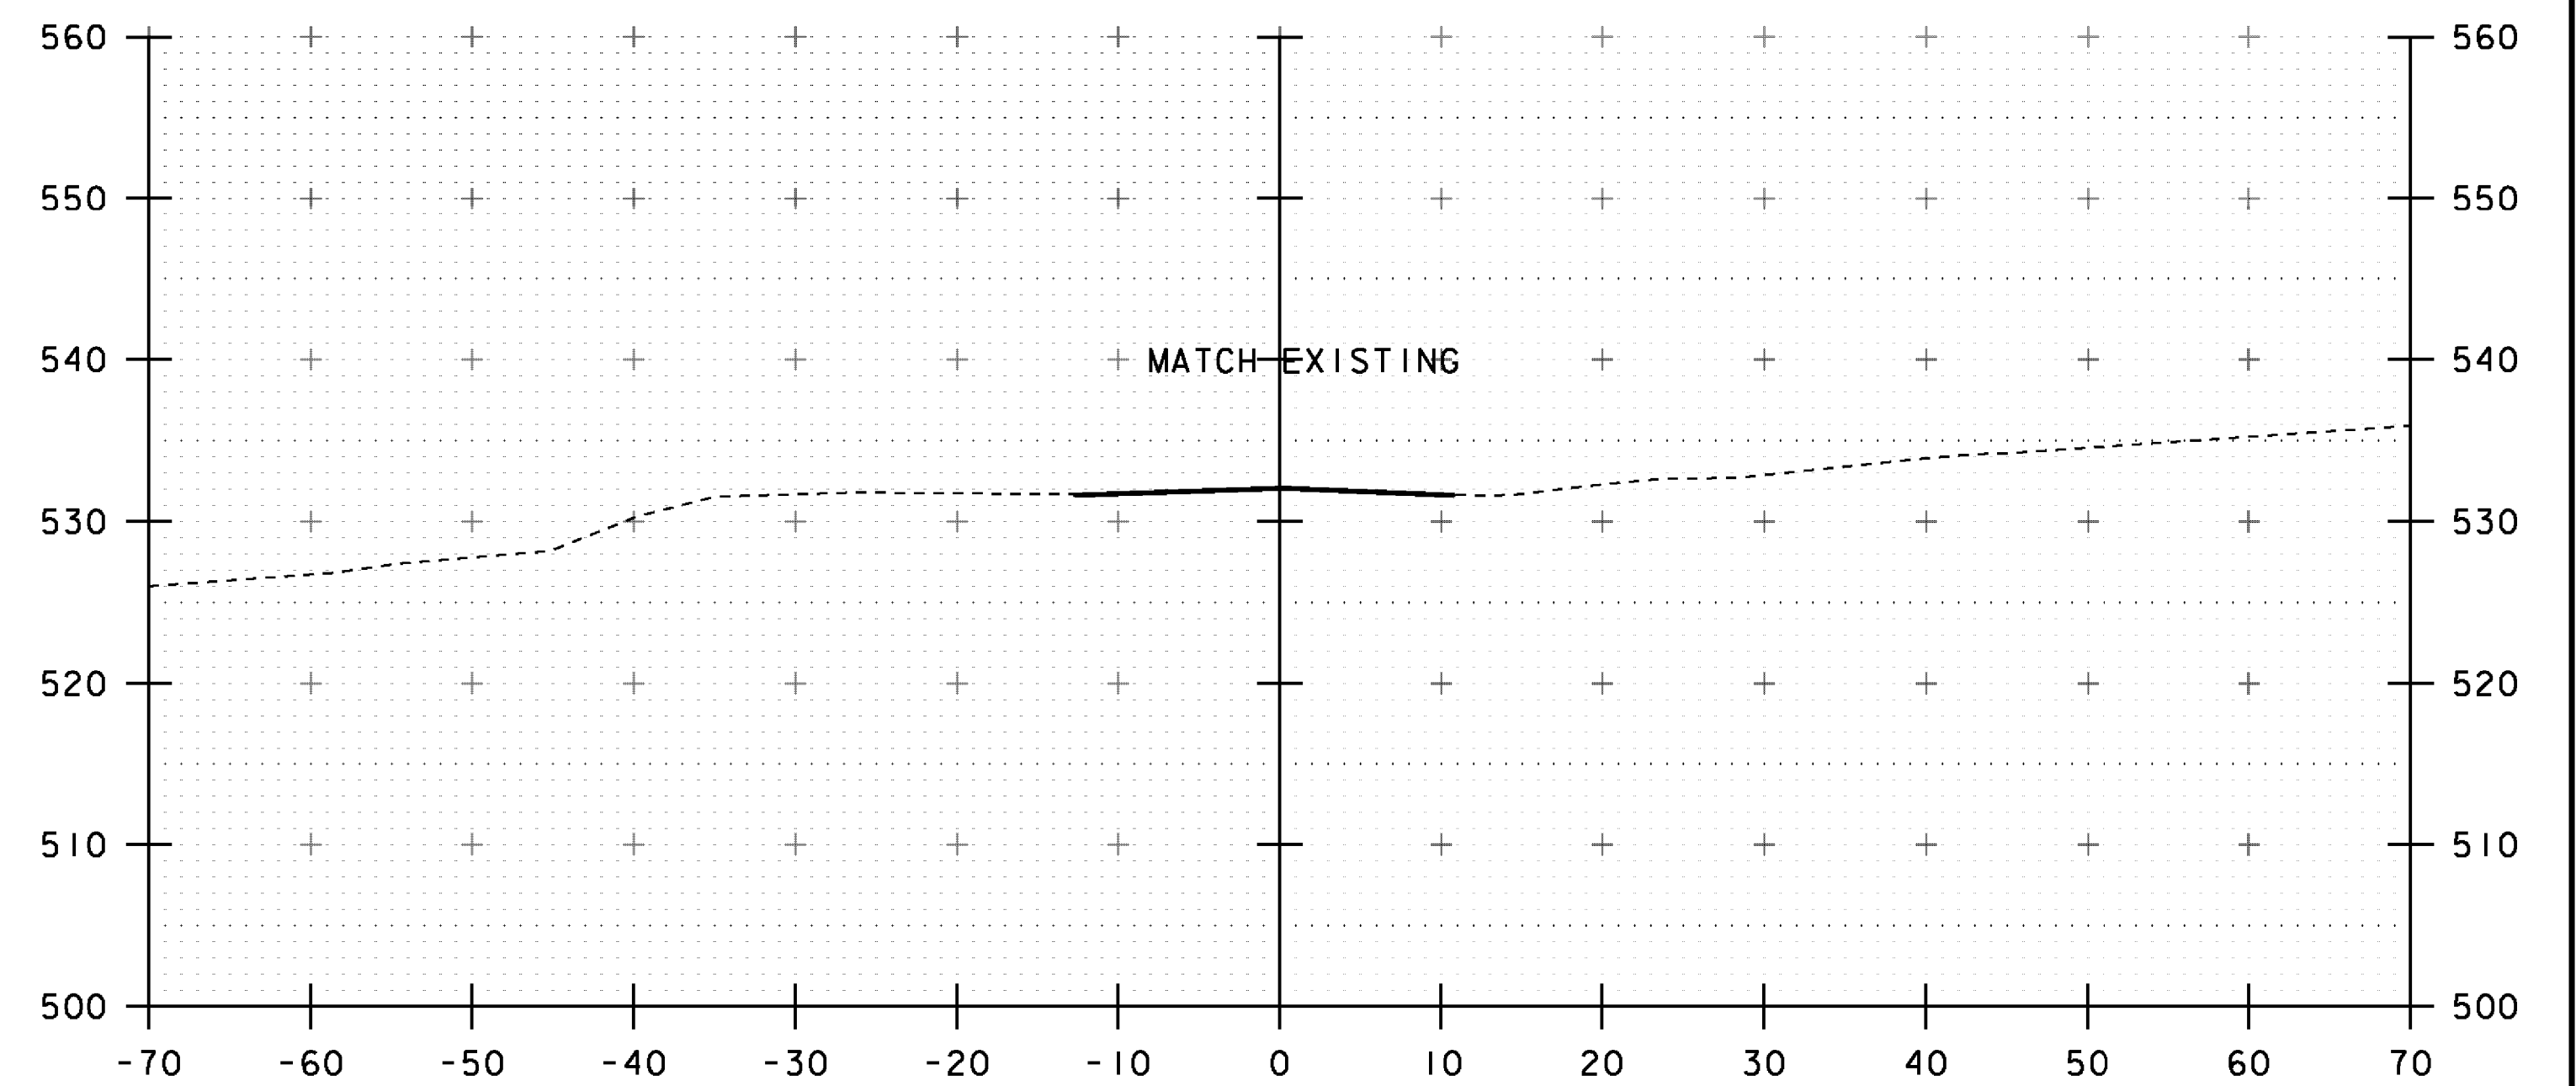

5+75

STA 5+75
END APPROACH
RESUME NON-PARTICIPATING PAVING

STA. 5+25 TO STA. 6+00

PROJECT NAME: RUTLAND CITY	
PROJECT NUMBER: BRF 3000(18)	
FILE NAME: s96j244xs.dgn	PLOT DATE: 28-FEB-2014
PROJECT LEADER: C. CARLSON	DRAWN BY: R. PELLETT
DESIGNED BY: M. EVANS-MONGEON	CHECKED BY: M. E-M
MAINLINE CROSS SECTIONS 5	SHEET 31 OF 44