


~~INSTALL AIR RELIEF VALVE WITH WEATHERPROOF, INSULATED AND LOCKABLE ENCLOSURE. PROVIDE FABRICATION DRAWING FOR REVIEW. COST SHALL BE INCIDENTAL TO ITEM 900.640 SPECIAL PROVISION (DUCTILE IRON PIPE, CEMENT-LINED, ALL-INCLUSIVE) (8" WATER ON BRIDGE)~~
 NOT REQUIRED BY CITY

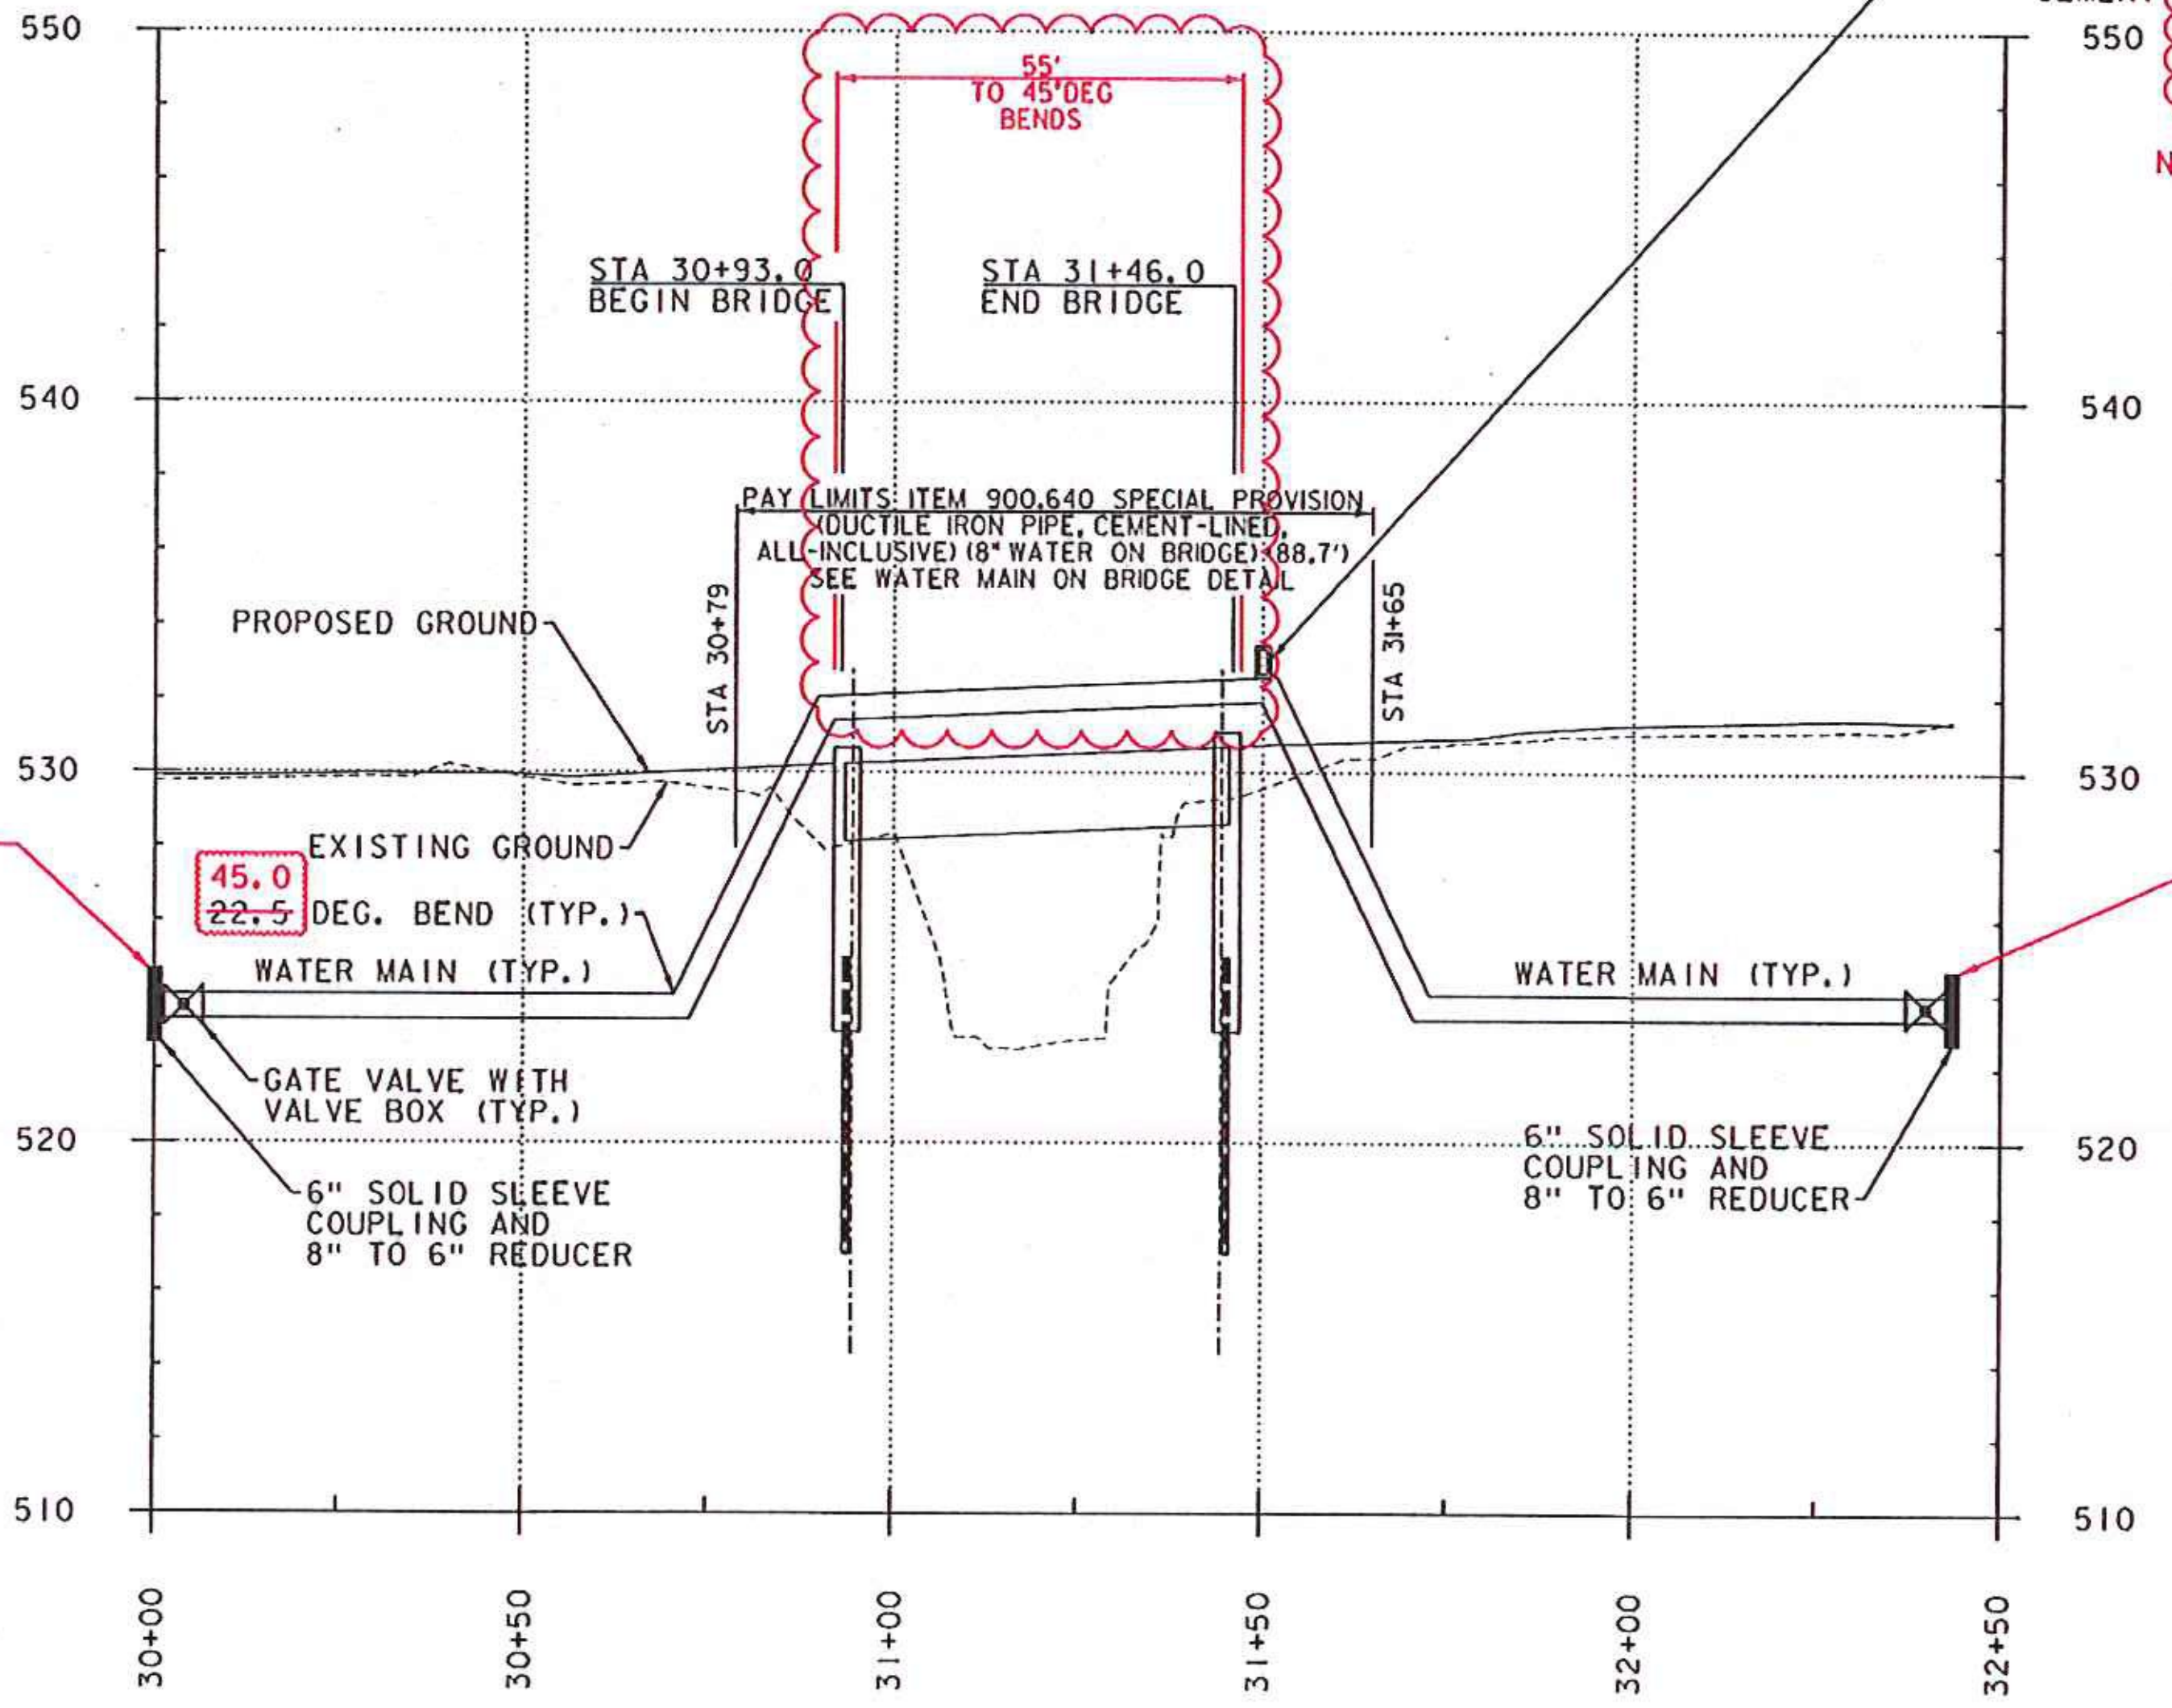

WATER MAIN STATION
 HOR. SCALE 1" = 20'-0"
 VER. SCALE 1" = 4'-0"

- ③ RECORD CHANGES [CLOUD]
- ② PLAN REVISIONS
 3/5/14: REVISED WATER MAIN PROFILE ON BRIDGE TO ACCOMMODATE HANGER INSTALLATION REQUIREMENTS. REVISED AIR RELIEF VALVE AND GATE VALVE LOCATIONS.
- ① 1/16/14: ADDED NOTE TO DEFINE INSULATION EXTENT AND CORRECTED SCALE (PER DEC).

 <small>540 Commercial Street, Manchester, NH 03101 (603) 668-8223 • Fax (603) 668-8502 cde@cldeengineers.com • www.cldeengineers.com Maine • New Hampshire • Vermont</small>	PROJECT NAME: RUTLAND CITY PROJECT NUMBER: BRF 3000(18)
	FILE NAME: #FILEABBREV# PROJECT LEADER: C. BEAN DESIGNED BY: D. LEWIS WATER PROFILE