


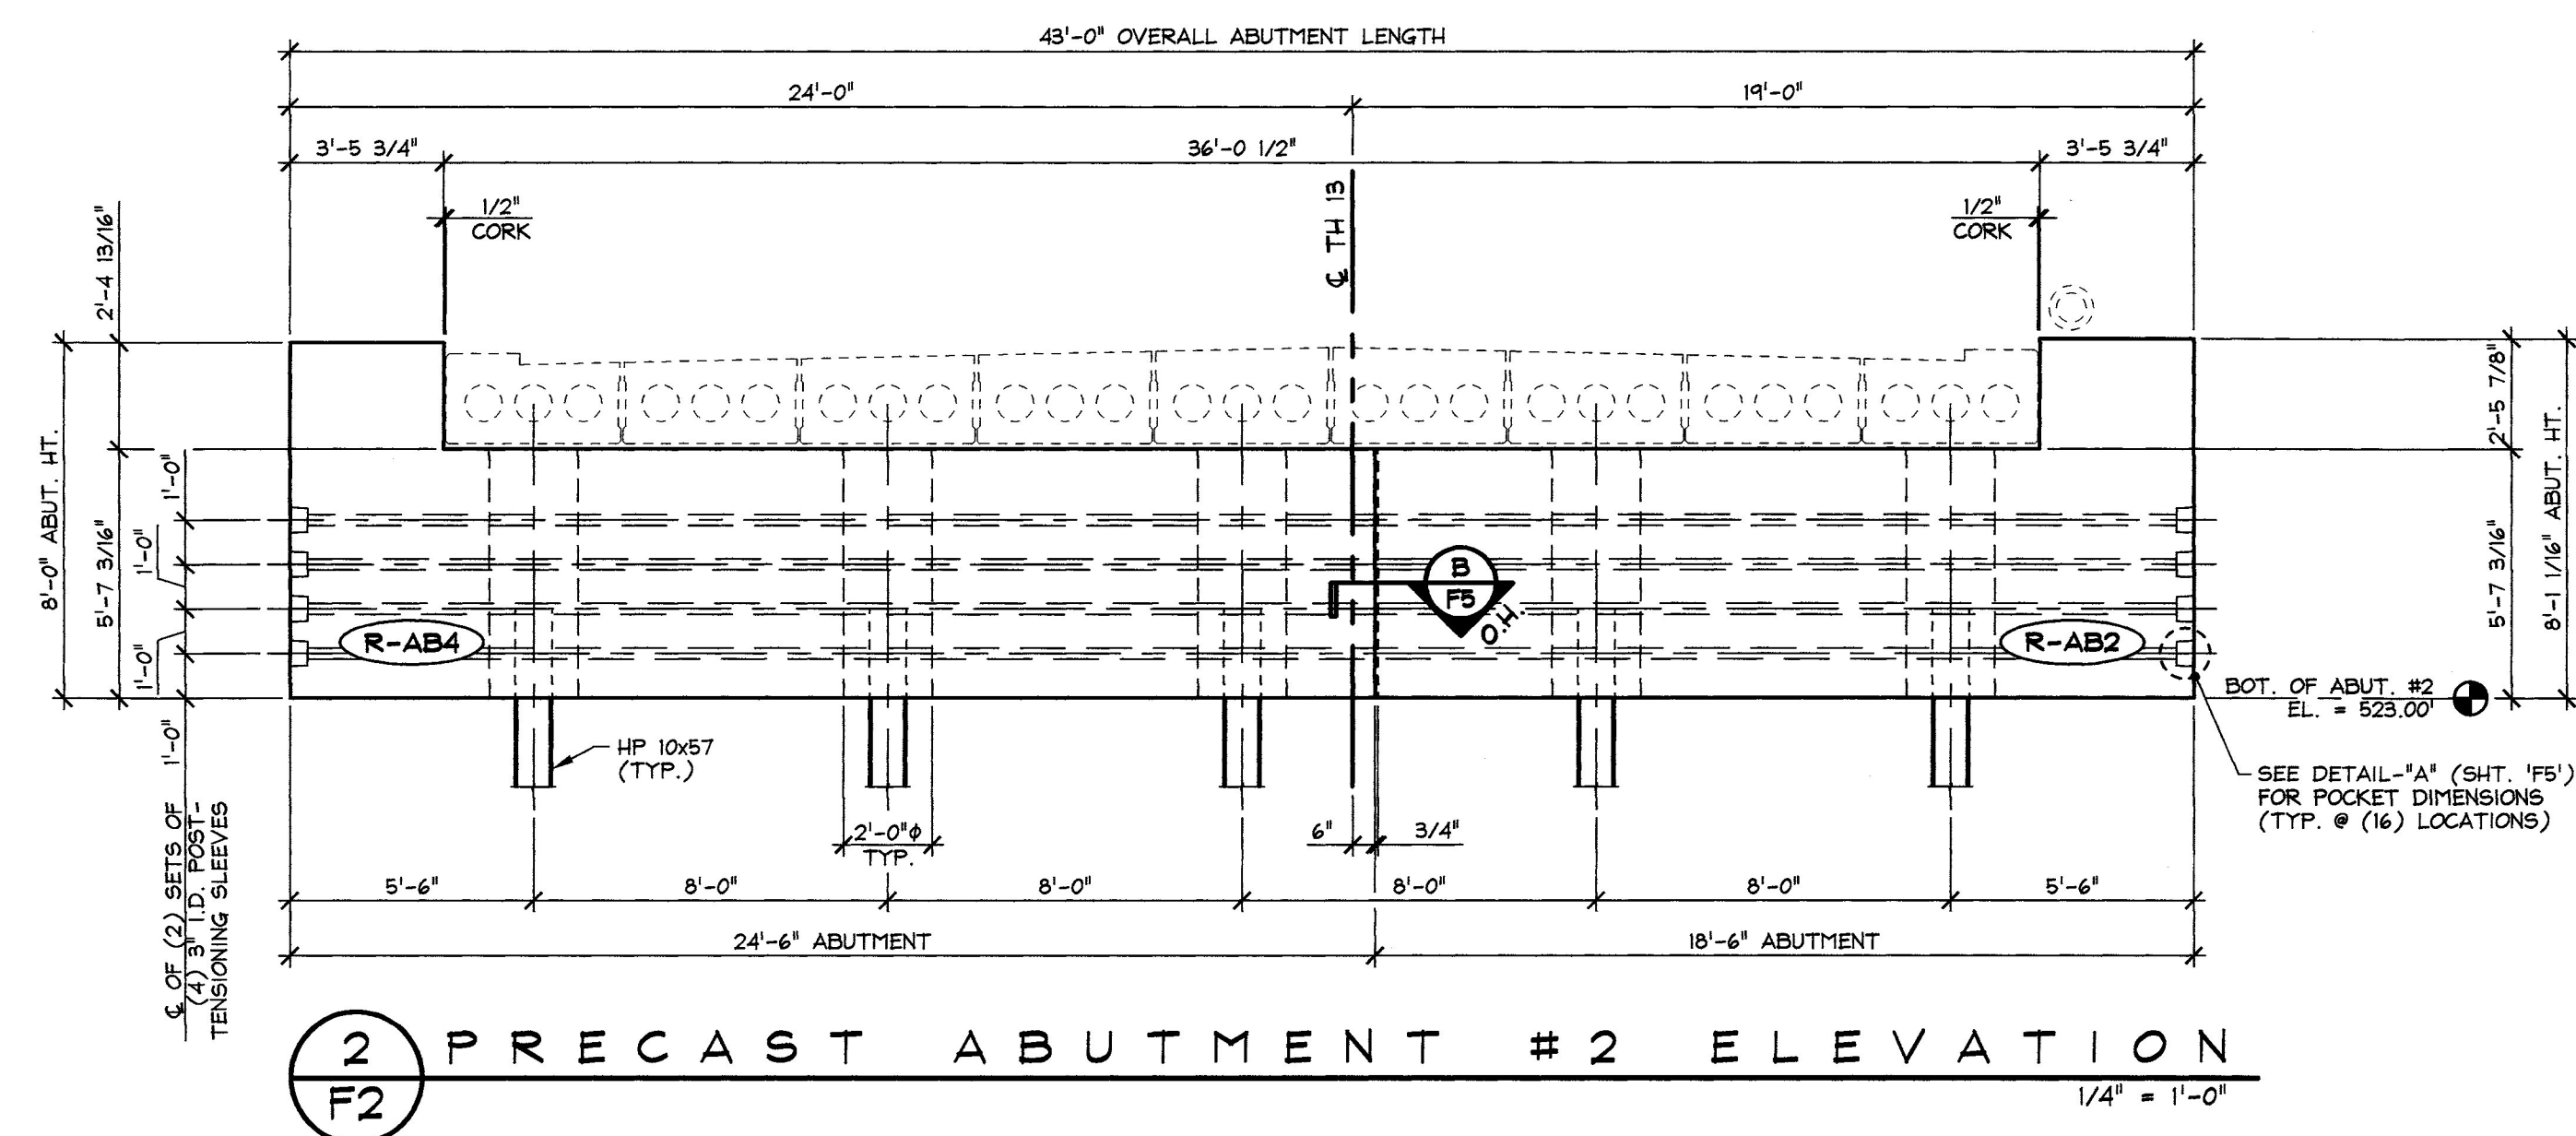

RECEIVED

**RESUBMIT** No **Approved** \_\_\_\_\_  
**BY** C. Carlson **DATE** 07/08/2014

|                                                                                                                        |                                                                                                                                                                                   |                                                                         |
|------------------------------------------------------------------------------------------------------------------------|-----------------------------------------------------------------------------------------------------------------------------------------------------------------------------------|-------------------------------------------------------------------------|
| APPROVAL STAMP:                                                                                                        | <b>J.P. CARRARA &amp; SONS INC.</b><br>Precast & Prestress Manufacturer<br><small>2464 CASE STR., WOODBURY, VERMONT 05753    Phone: (802) 388-6361    Fax: (802) 388-9010</small> | <b>THE BELDEN COMPANY, INC.</b><br>CONTRACTOR<br>RUTLAND, VERMONT       |
| <b>STATE OF VERMONT AGENCY OF TRANSPORTATION</b><br>COUNTY OF RUTLAND                                                  |                                                                                                                                                                                   | DATE: APR. 25, 2014                                                     |
| CITY OF RUTLAND<br>ROUTE NO.: TH 13 (FOREST STREET) - URBAN COLLECTOR<br>BRIDGE NO.: 14      PROJECT NO.: BRP 3000(1B) |                                                                                                                                                                                   | SCALE:      NOTED<br>CHKD: M.D.    DFTM: B.L.<br>JOB NO:      23430-014 |
| <b>PRECAST ABUTMENT ELEVATIONS</b>                                                                                     |                                                                                                                                                                                   | DWG. NO: <b>F2</b>                                                      |