




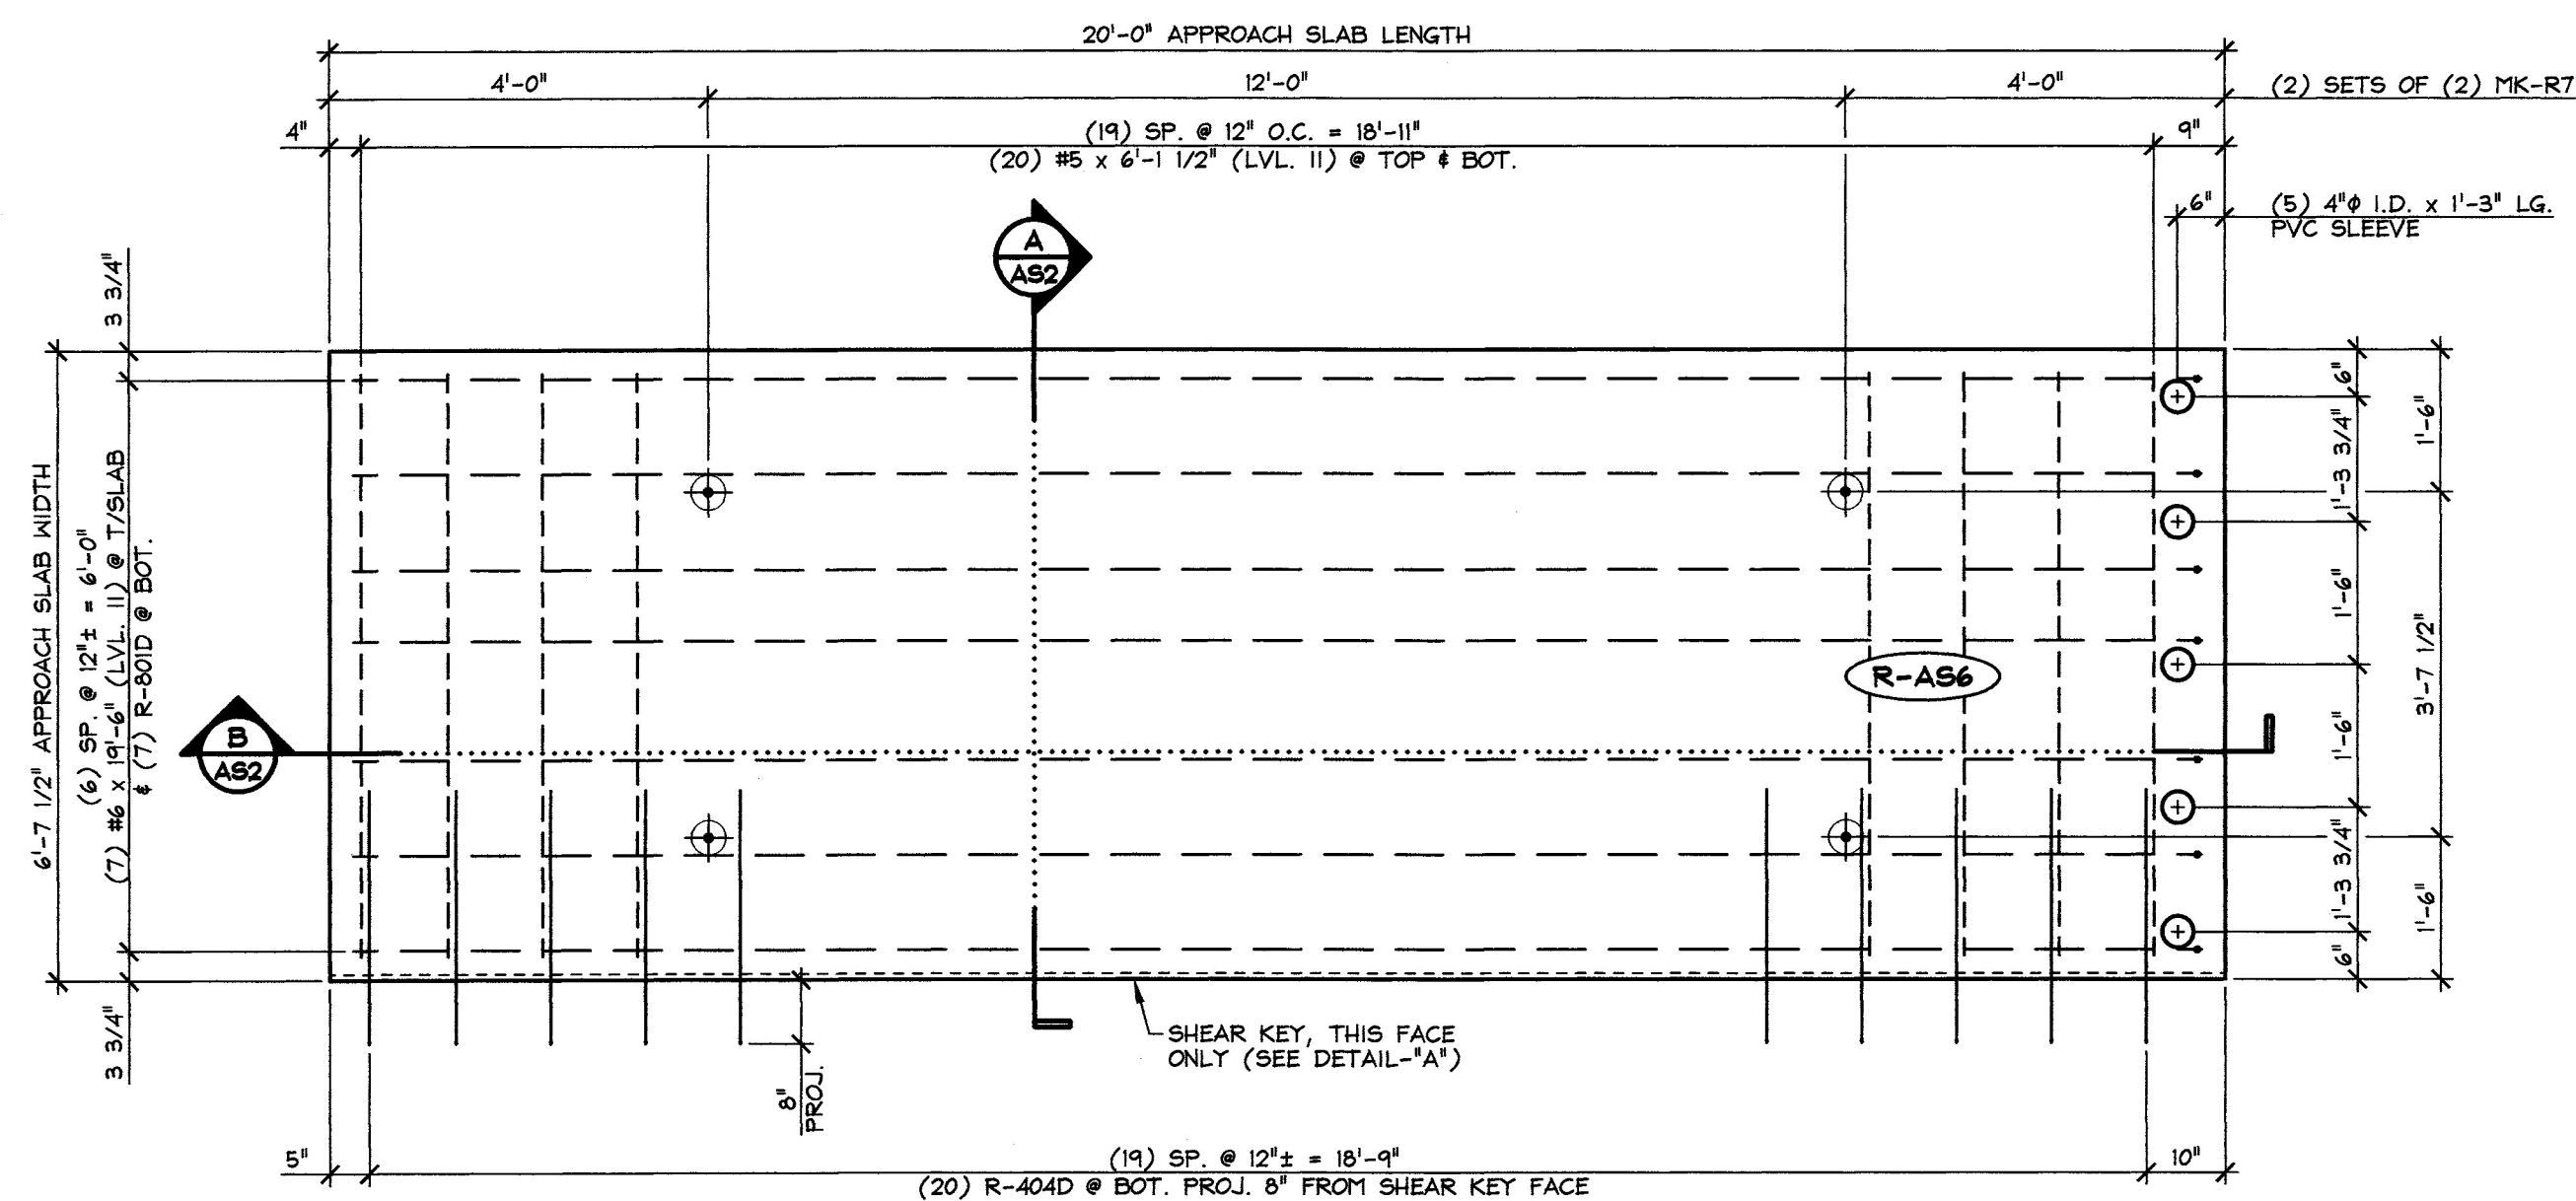


1 APPROACH SLAB PLAN VIEW IN FORM
AS2 1/2" = 1'-0"

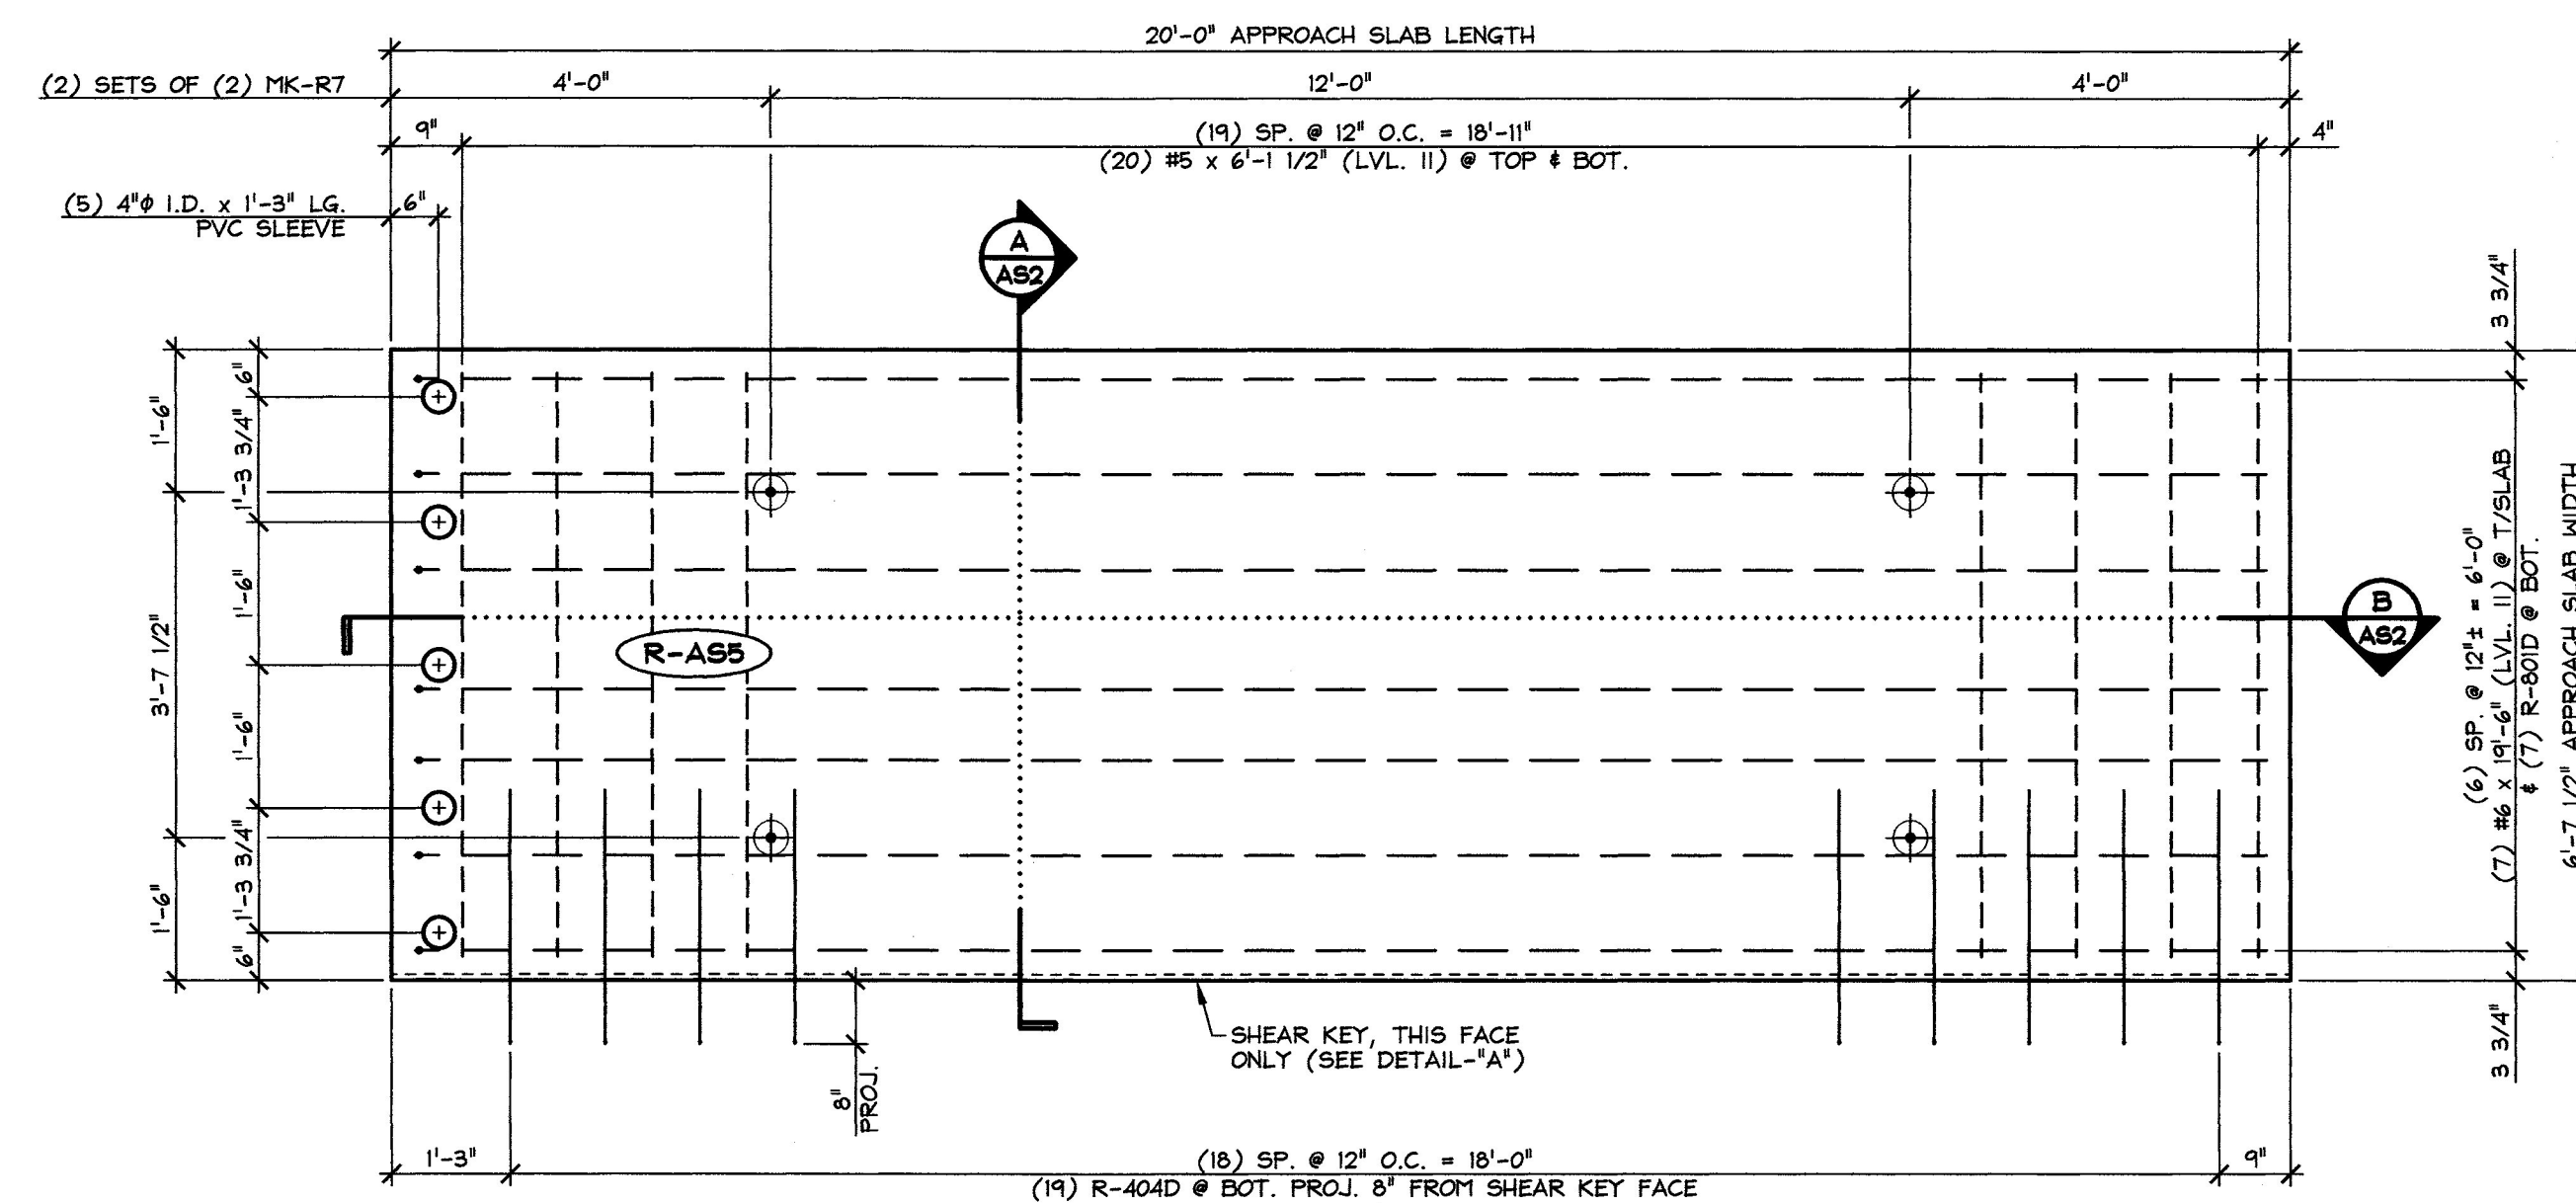


2 APPROACH SLAB PLAN VIEW IN FORM
AS2 1/2" = 1'-0"

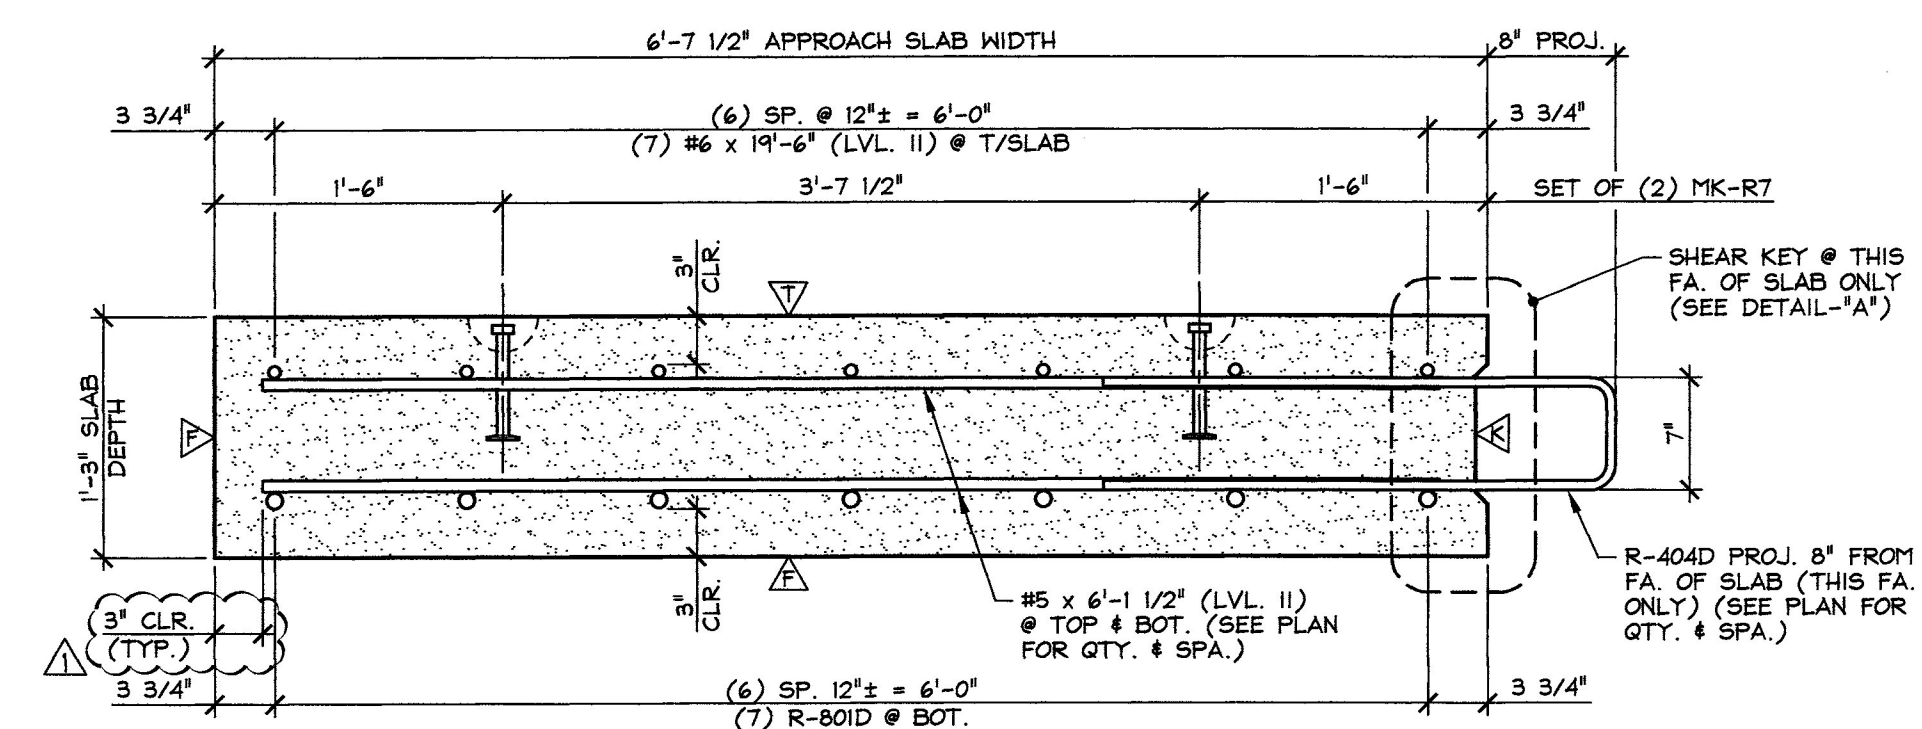

A TRANSVERSE SECTION
AS2 1" = 1'-0"

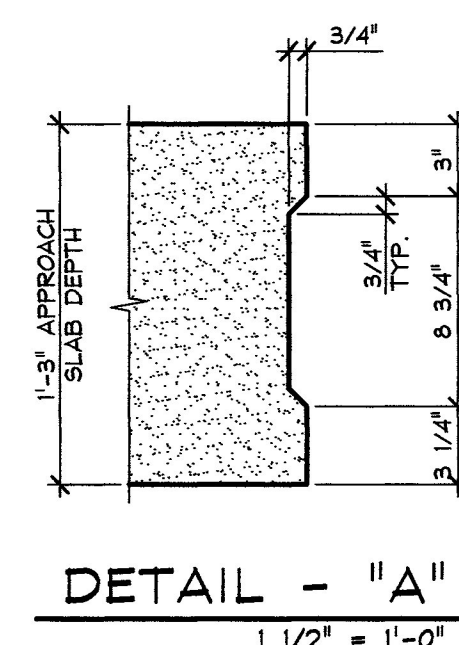

DETAIL - "A"
1 1/2" = 1'-0"

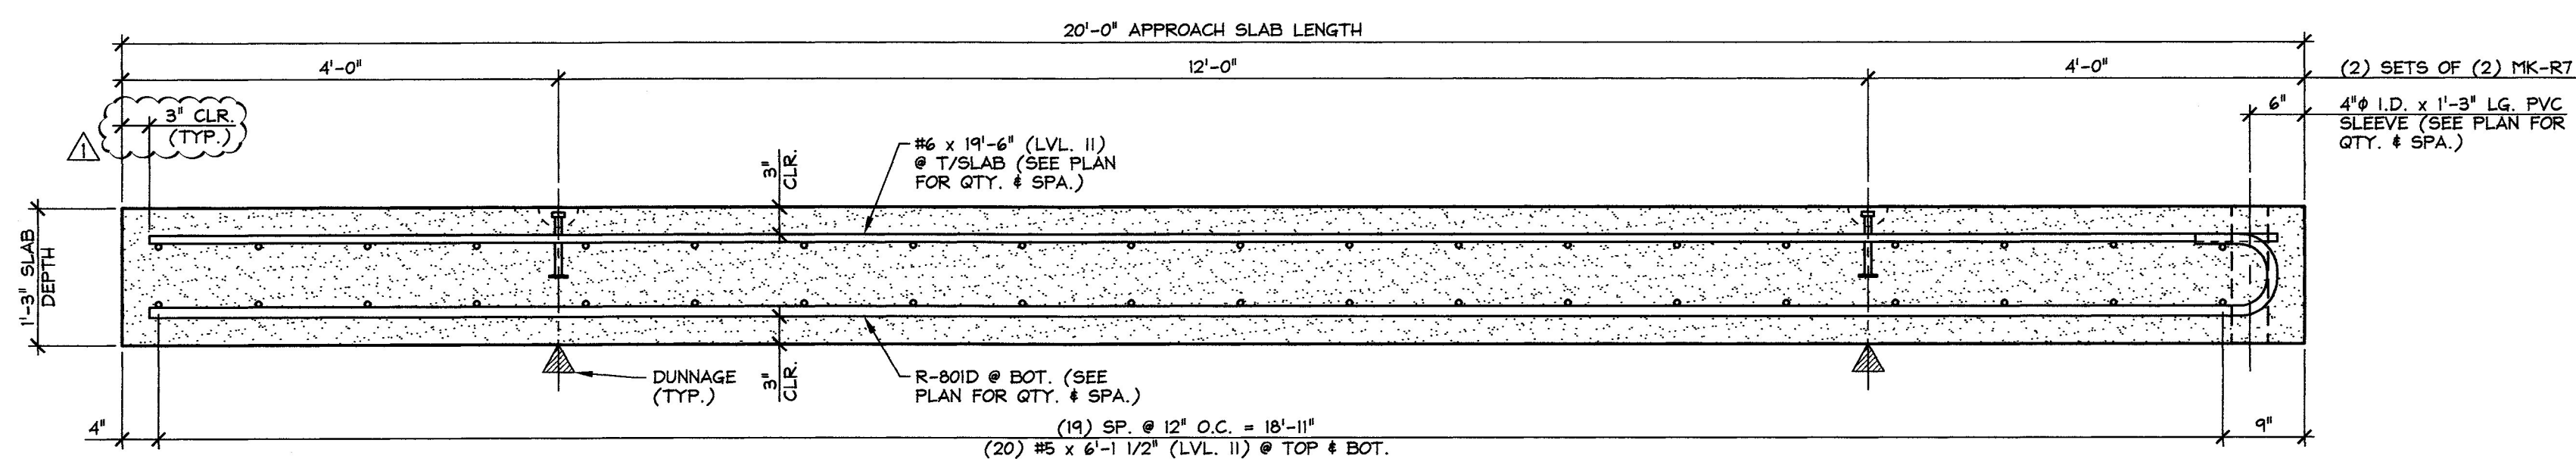

B LONGITUDINAL SECTION
AS2 3/4" = 1'-0"

Vermont Agency of Transportation
RECEIVED

CK'D BY M. Umberger OK'D BY C. Carlson

July 1, 2014

RESUBMIT No Approved
BY C. Carlson DATE 07/08/2014

MARK:	R-AS6	QTY.:	1	WT.:	12.4 T	VOL.:	6.1 cy
MARK:	R-AS5	QTY.:	1	WT.:	12.4 T	VOL.:	6.1 cy
MATERIAL LIST / APPROACH SLAB							
ITEM	MARK	DESCRIPTION		QTY./SLAB			
1	R-404D	#4 BENT BAR (LEVEL II, DUAL COATED)		20	19		
2		#5 x 6'-1 1/2" (LEVEL II, DUAL COATED)		40	40		
3		#6 x 19'-6" (LEVEL II, DUAL COATED)		7	7		
4		#6 x 19'-6" (LEVEL II, DUAL COATED)		7	7		
5		#6 x 19'-6" (LEVEL II, DUAL COATED)		7	7		
6		#6 x 19'-6" (LEVEL II, DUAL COATED)		7	7		
7	R-801D	#8 BENT BAR (LEVEL II, DUAL COATED)		7	7		
8		#8 BENT BAR (LEVEL II, DUAL COATED)		7	7		
9	MK-R7	4T x 7 1/8" SKIFF LIFT LIFTER (GALVANIZE)		4	4		
10		4" I.D. x 1'-3" PVC SLEEVE		5	5		

7-1-14 REVISED AS NOTED

APPROVAL STAMP:	J.P. CARRARA & SONS INC. Precast & Prestress Manufacturer 2464 OSE STR., MIDDLEBURY, VERMONT 05753 Phone:(802)388-6361 Fax:(802)388-9010		THE BELDEN COMPANY, INC. CONTRACTOR RUTLAND, VERMONT	
	STATE OF VERMONT AGENCY OF TRANSPORTATION COUNTY OF RUTLAND		DATE: APR. 25, 2014 SCALE: NOTED	
	CITY OF RUTLAND ROUTE NO.: TH 13 (FOREST STREET) - URBAN COLLECTOR BRIDGE NO.: 14 PROJECT NO.: BRF 3000(18)		CHKD: M.D. DFTM: B.L. JOB NO: 23430-014	
	PRECAST APPROACH SLAB DETAILS		DWG. NO: AS2	