




STA 8+27.61
END NON-PARTICIPATING PAVING

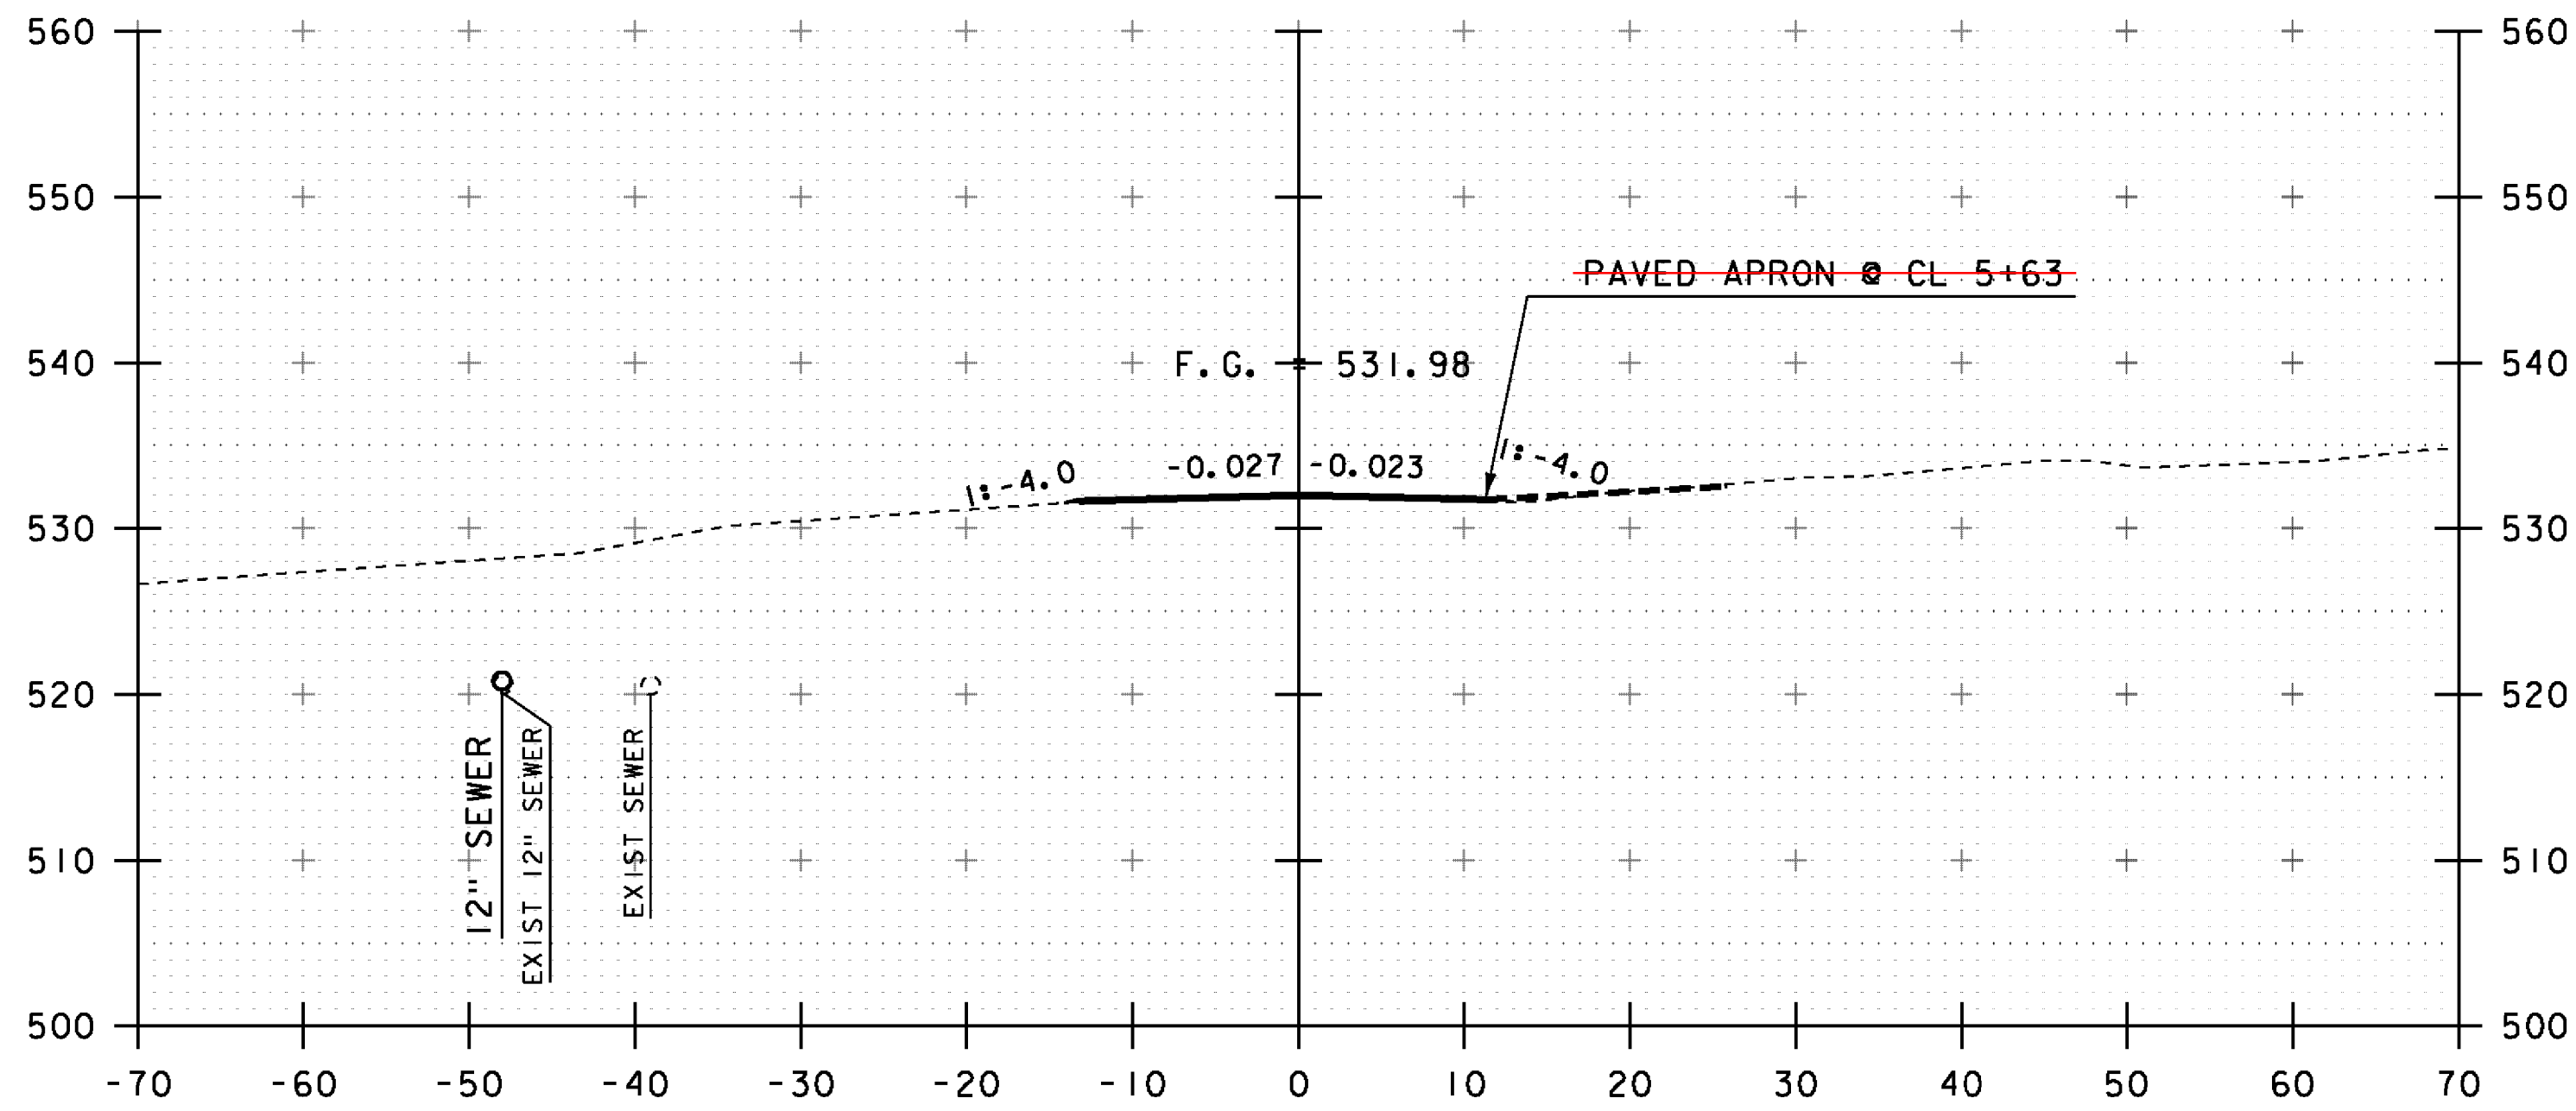


5+50

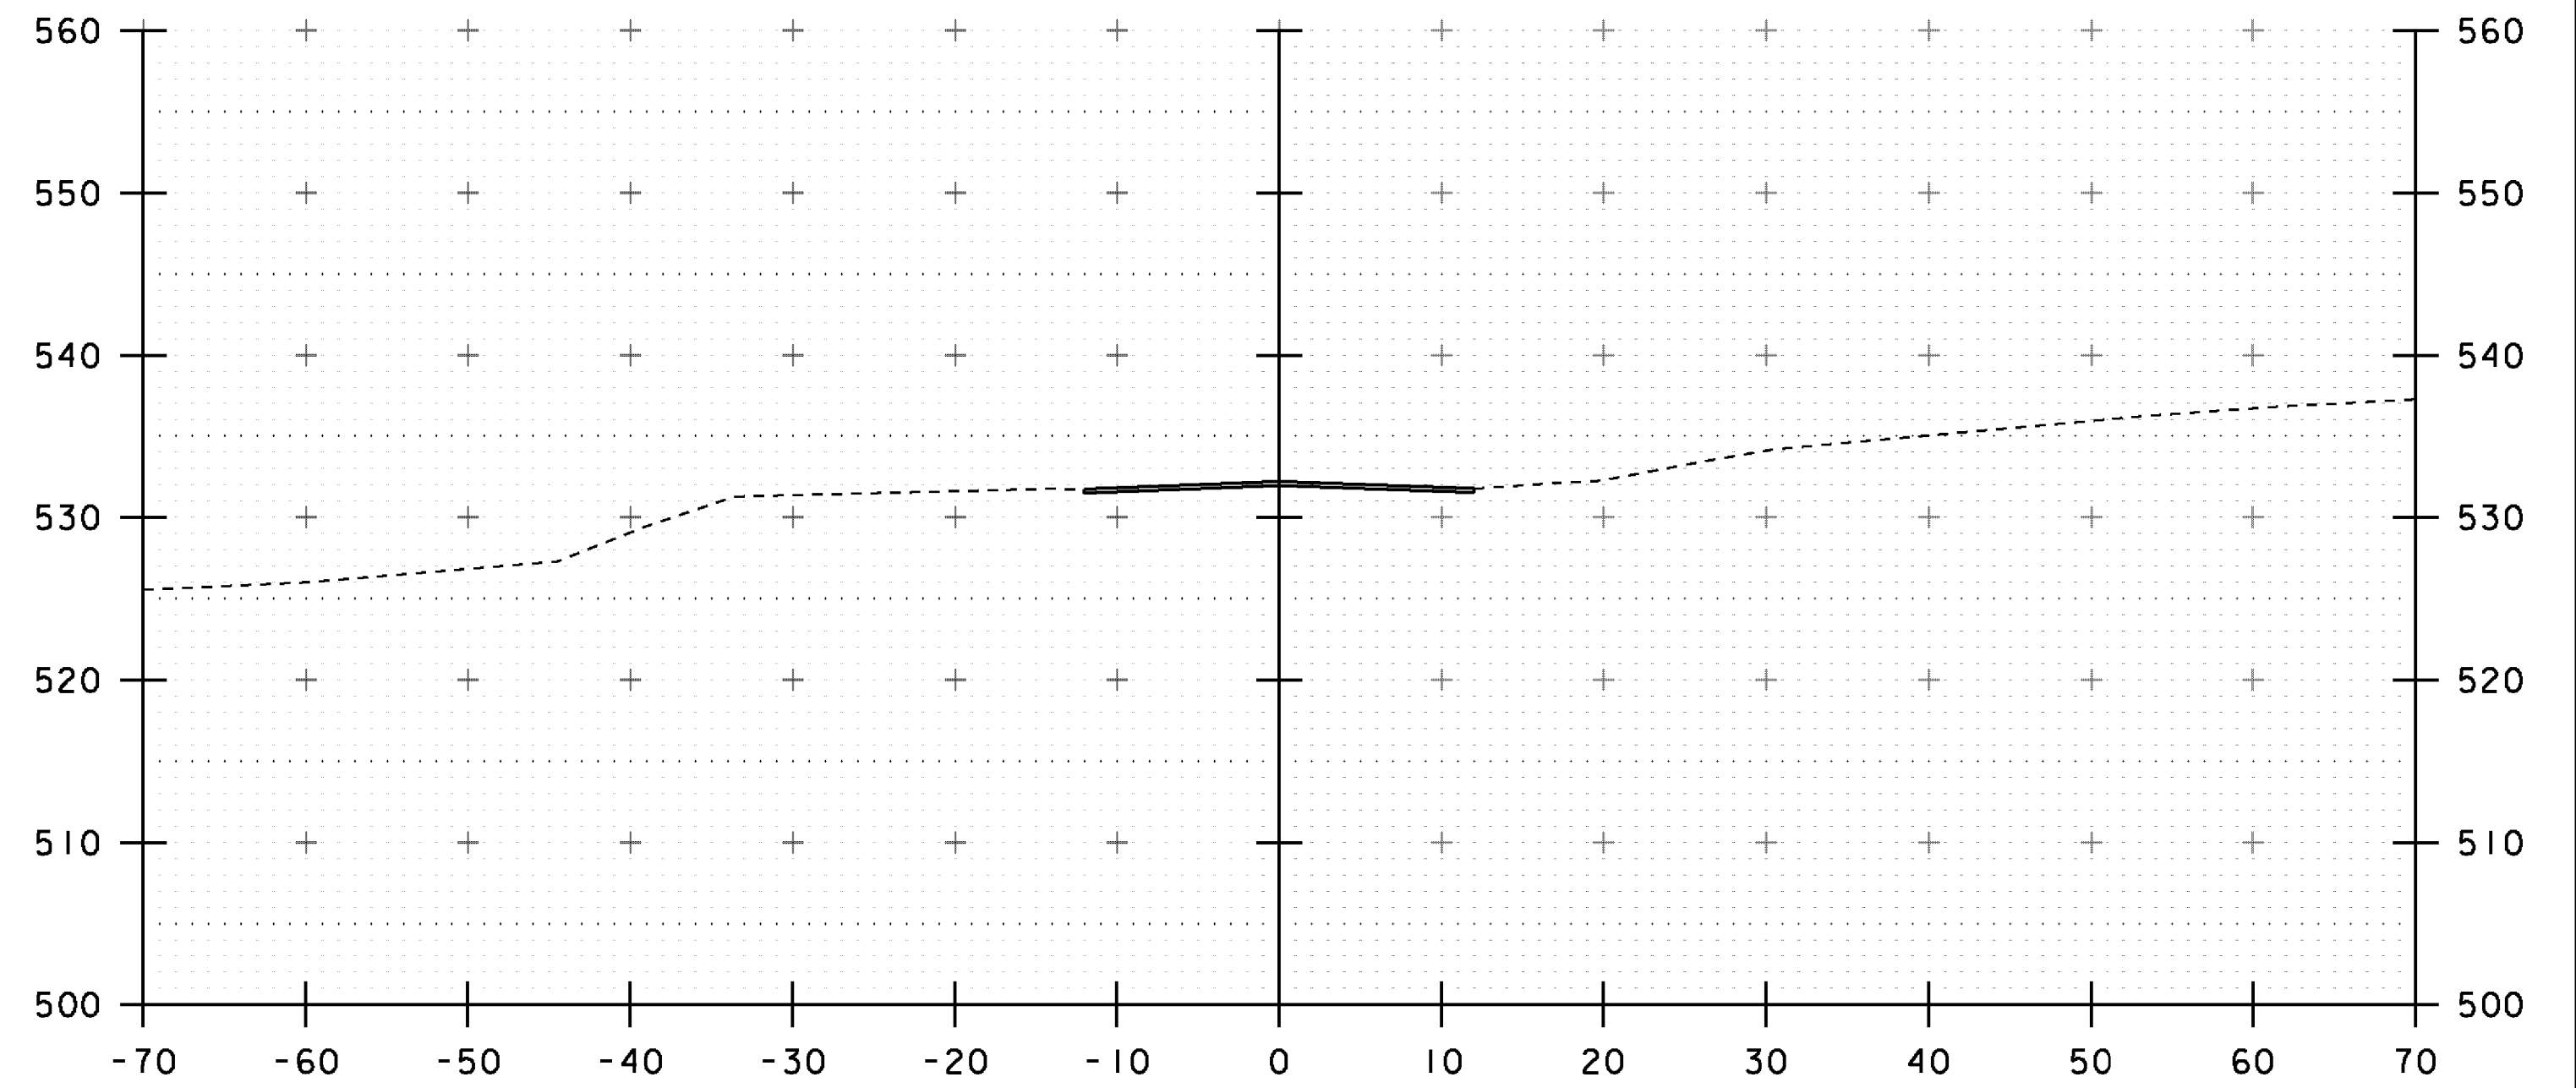

6+00

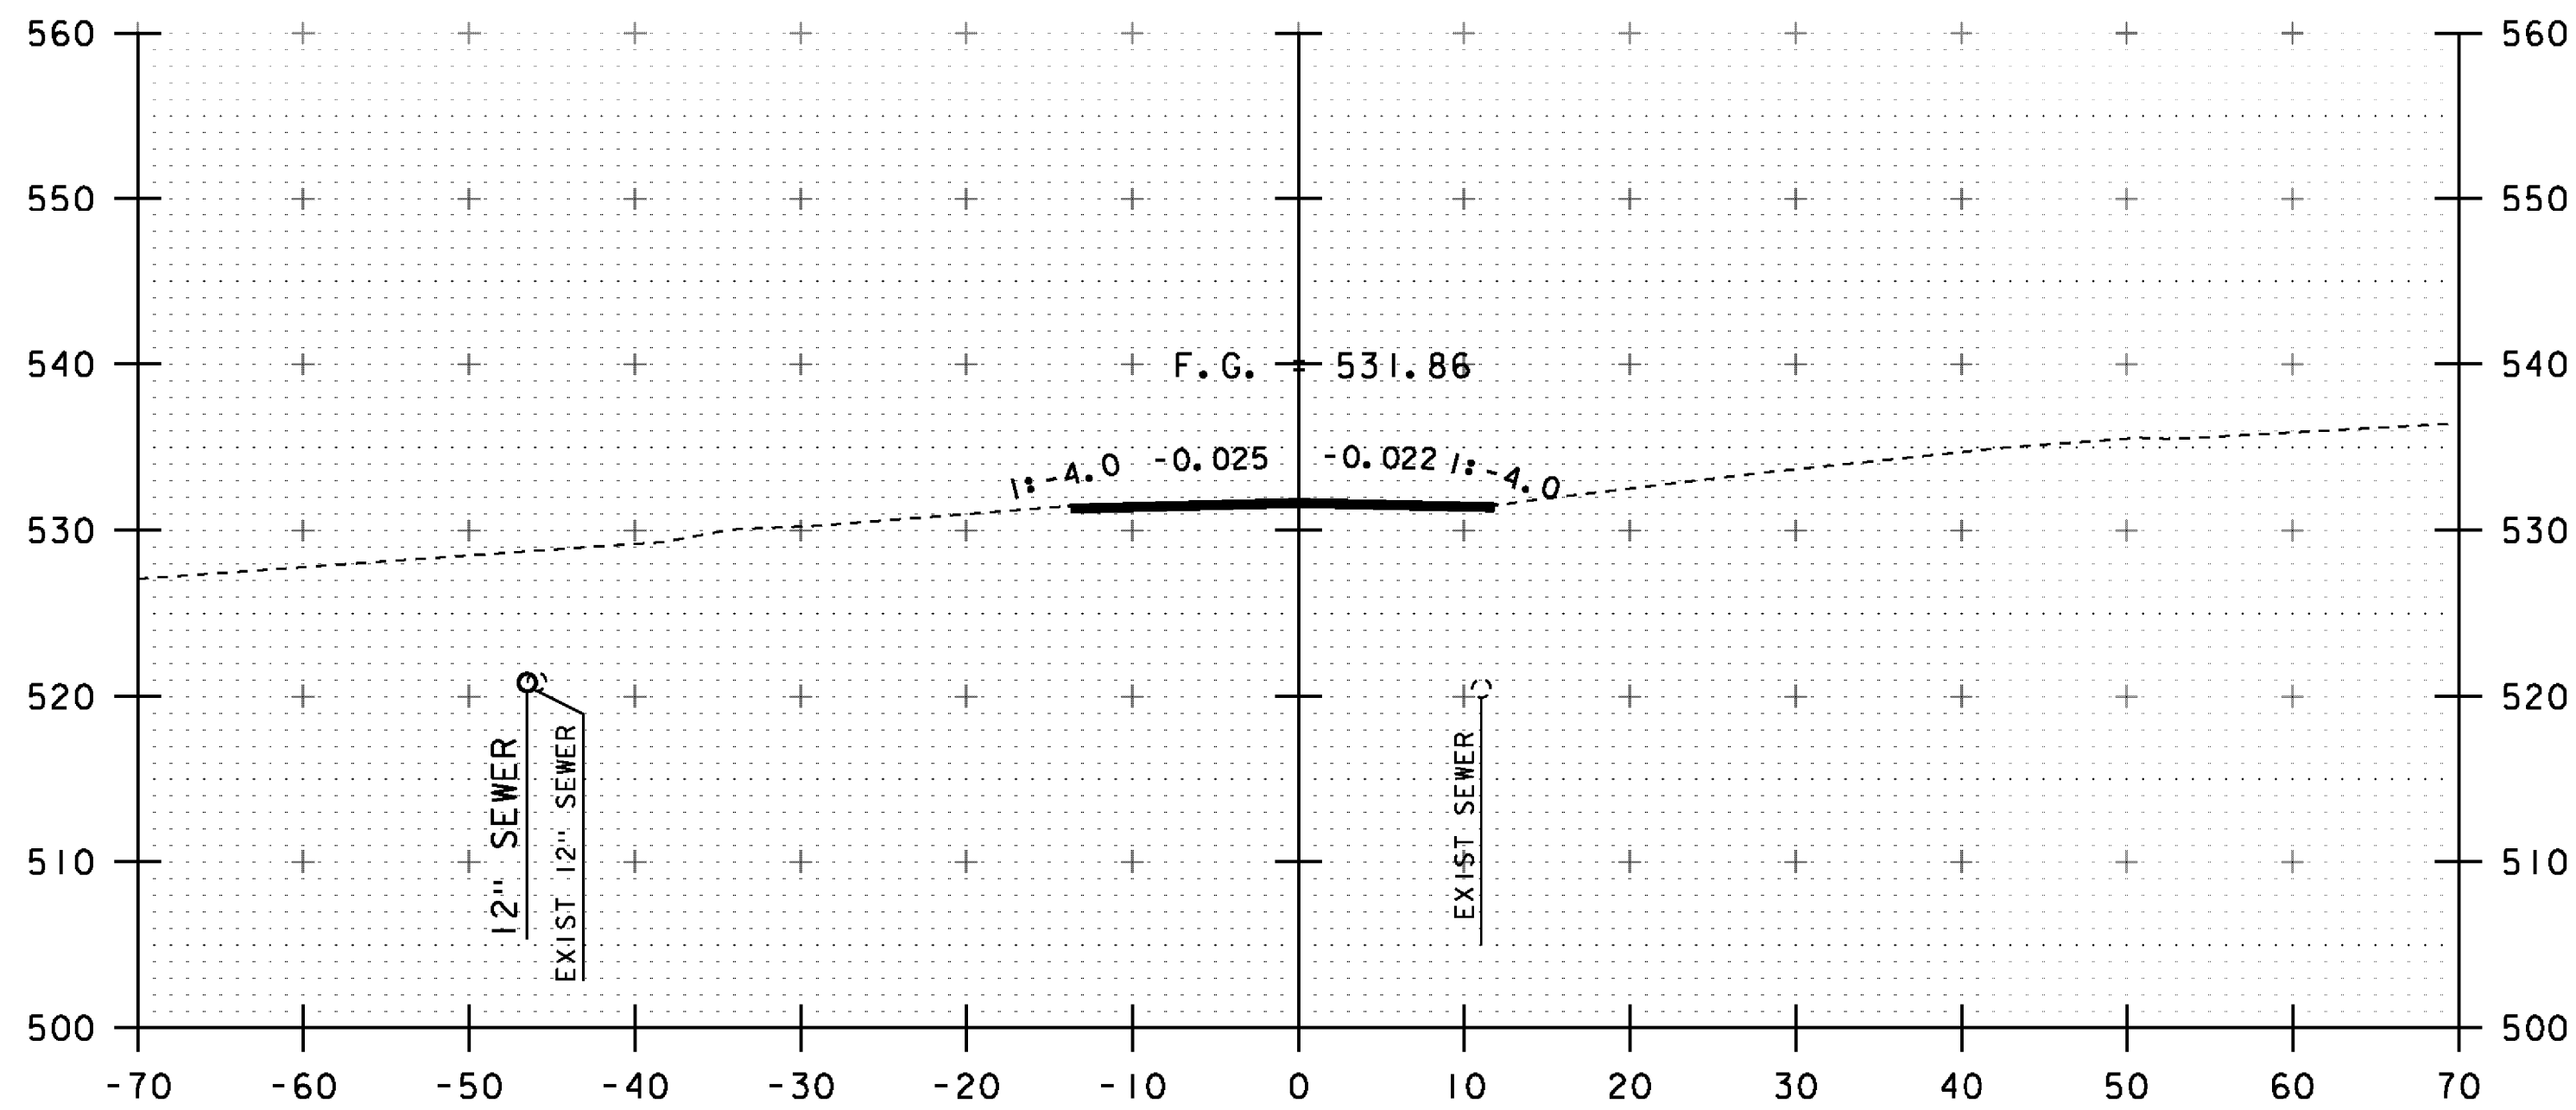

5+25

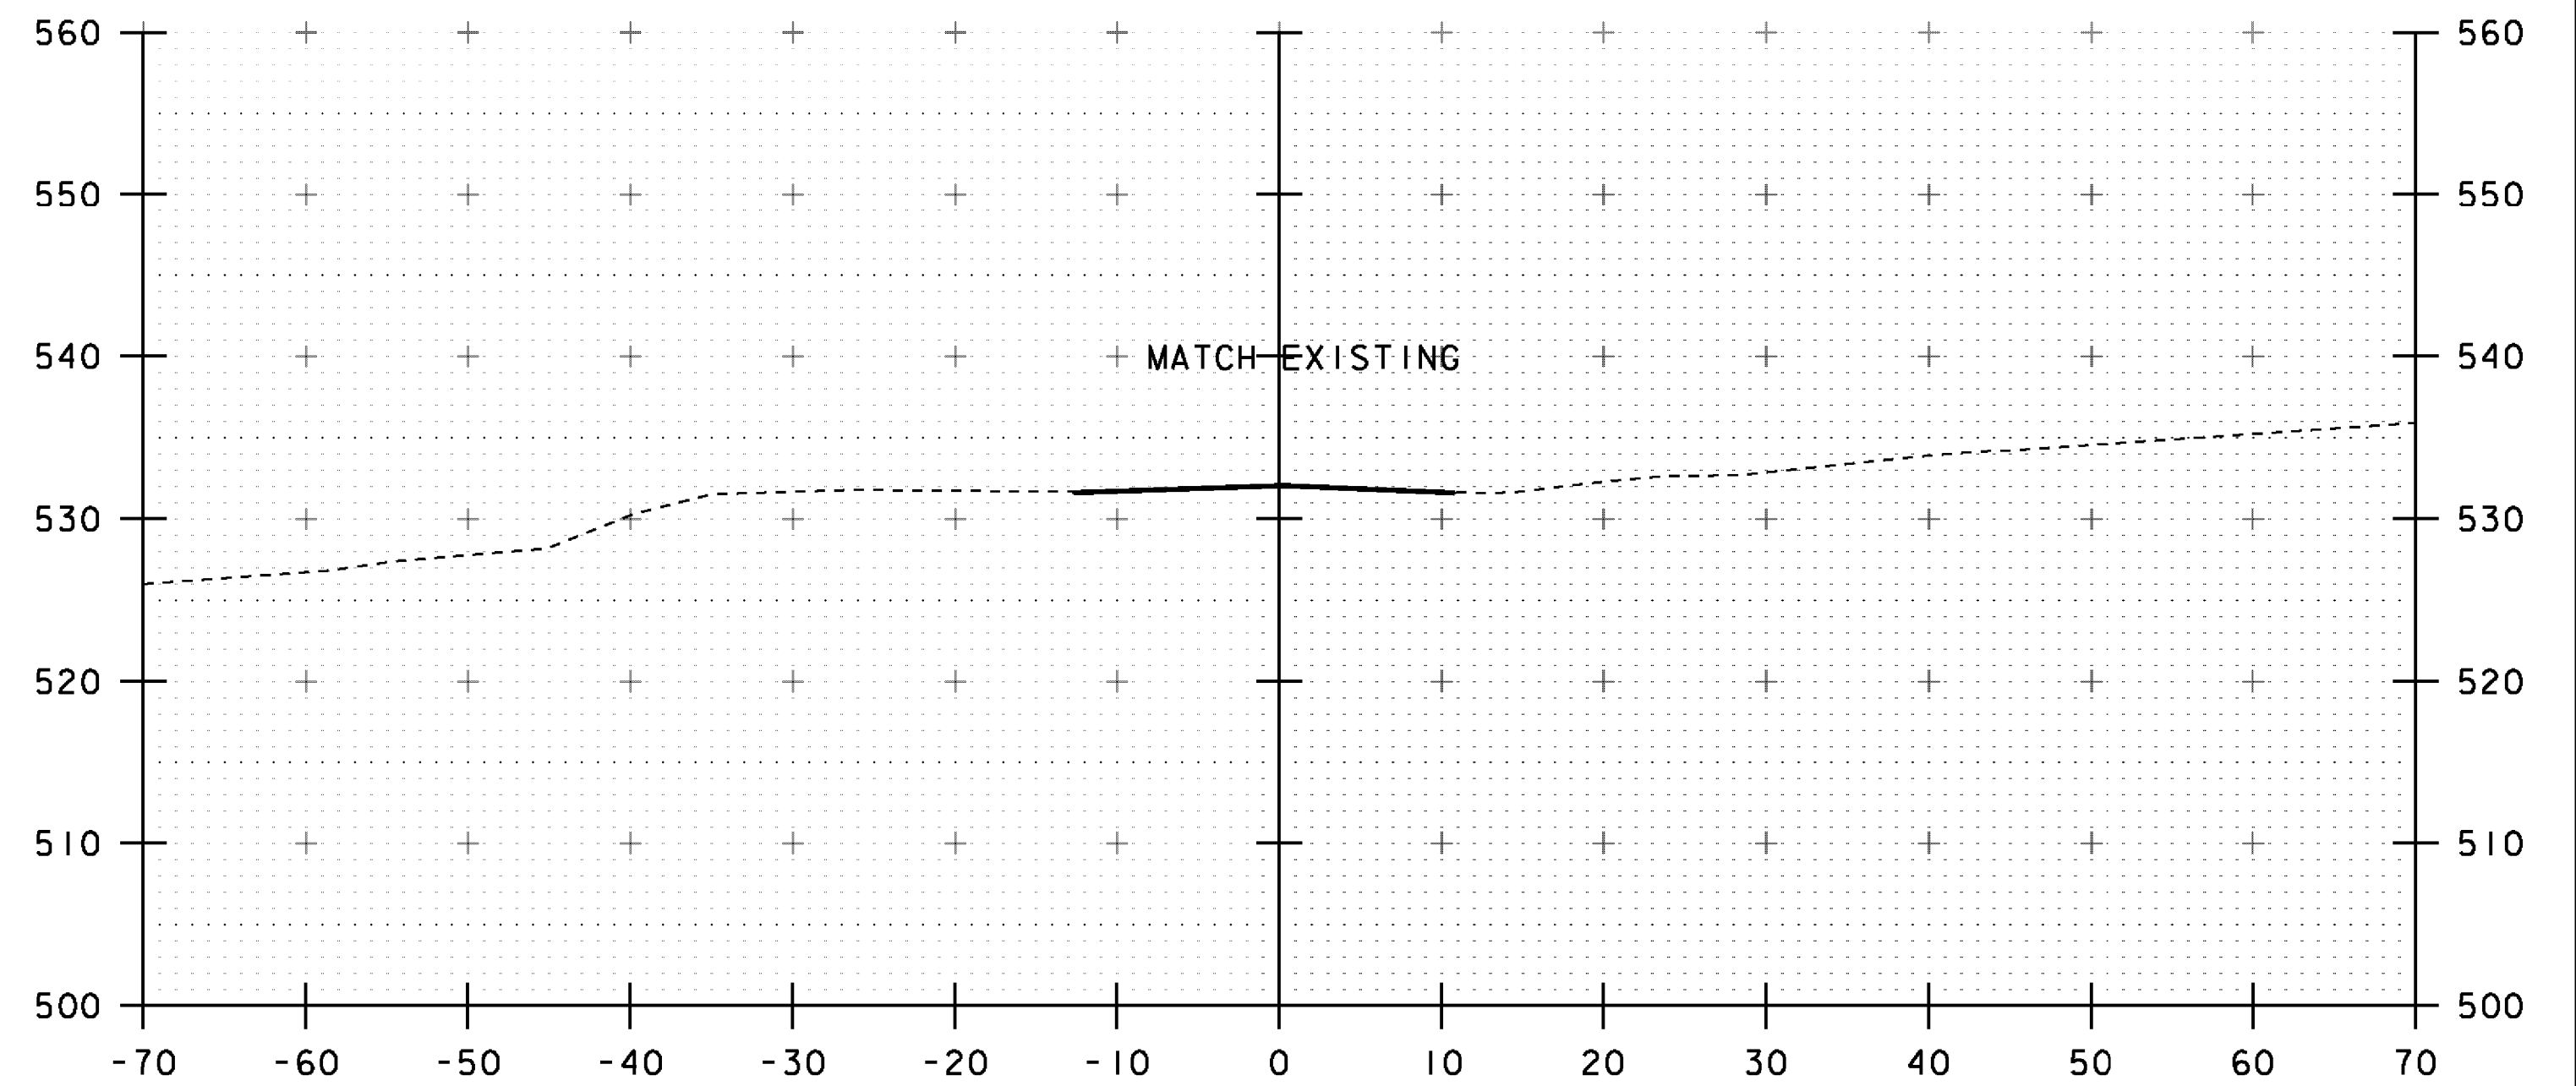

5+75

STA 5+75
END APPROACH
RESUME NON-PARTICIPATING PAVING

STA. 5+25 TO STA. 6+00

PROJECT NAME:	RUTLAND CITY	PLOT DATE:	28-FEB-2014
PROJECT NUMBER:	BRF 3000(18)	DRAWN BY:	R. PELLETT
FILE NAME:	s96j244xs.dgn	DESIGNED BY:	M. EVANS-MONGEON
PROJECT LEADER:	C. CARLSON	CHECKED BY:	M. E-M
DESIGNED BY:	M. EVANS-MONGEON	MAINLINE CROSS SECTIONS	5
CHECKED BY:	M. E-M	SHEET	31 OF 44