


**BANKING DIAGRAM**  
 HORIZONTAL SCALE 1" = 30'-0"  
 NO VERTICAL SCALE

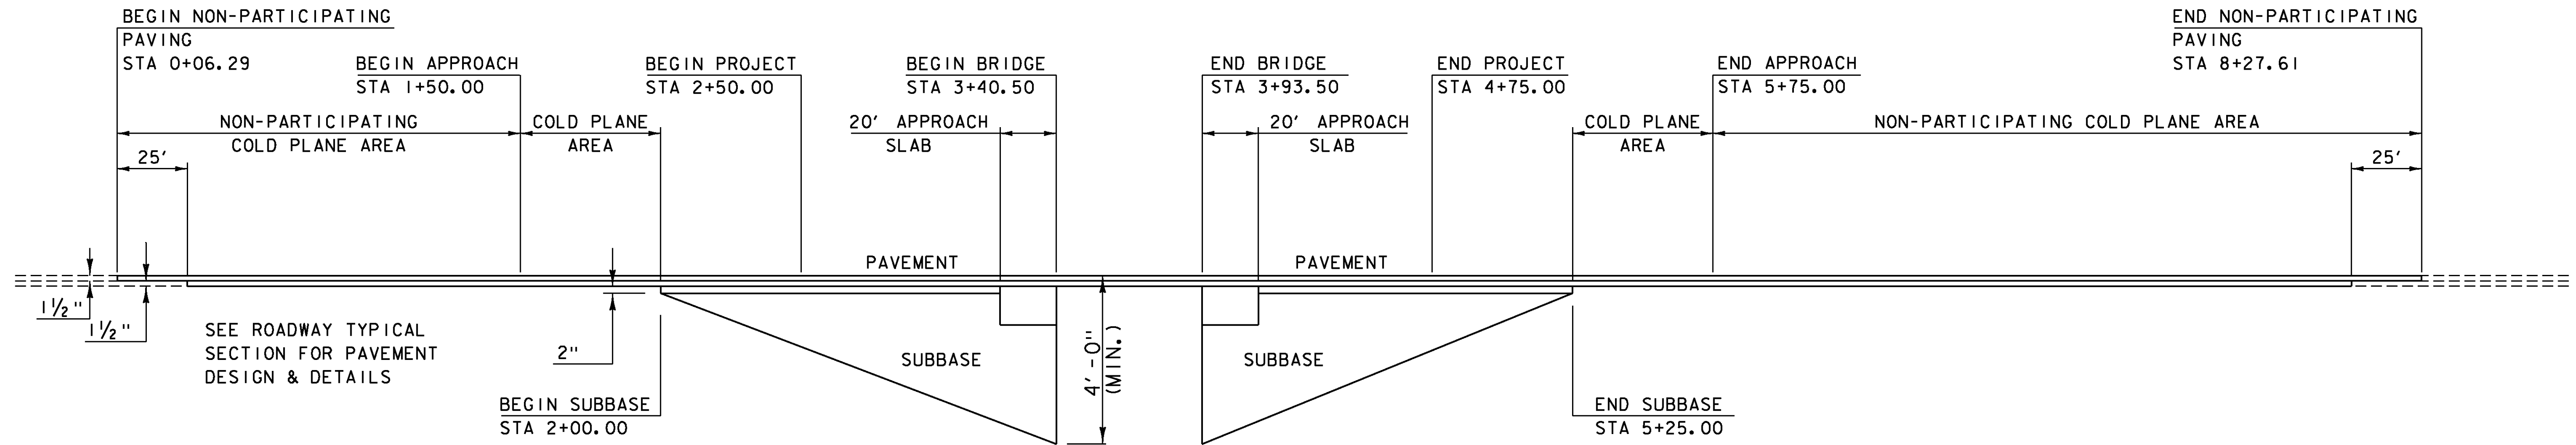

**MATERIAL TRANSITION**  
 HORIZONTAL SCALE 1" = 30'-0"  
 NO VERTICAL SCALE

PROJECT NAME: RUTLAND CITY	PLOT DATE: 28-FEB-2014
PROJECT NUMBER: BRF 3000(18)	DRAWN BY: R. PELLETT
FILE NAME: s96j244xs.dgn	CHECKED BY: M. E-M
PROJECT LEADER: C. CARLSON	SHEET 35 OF 44
DESIGNED BY: M. EVANS-MONGEON	
BANKING / MATERIAL TRANSITION	