



FOR SMH-1
CONFIGURATION, SEE
DETAIL ON SHEET 4

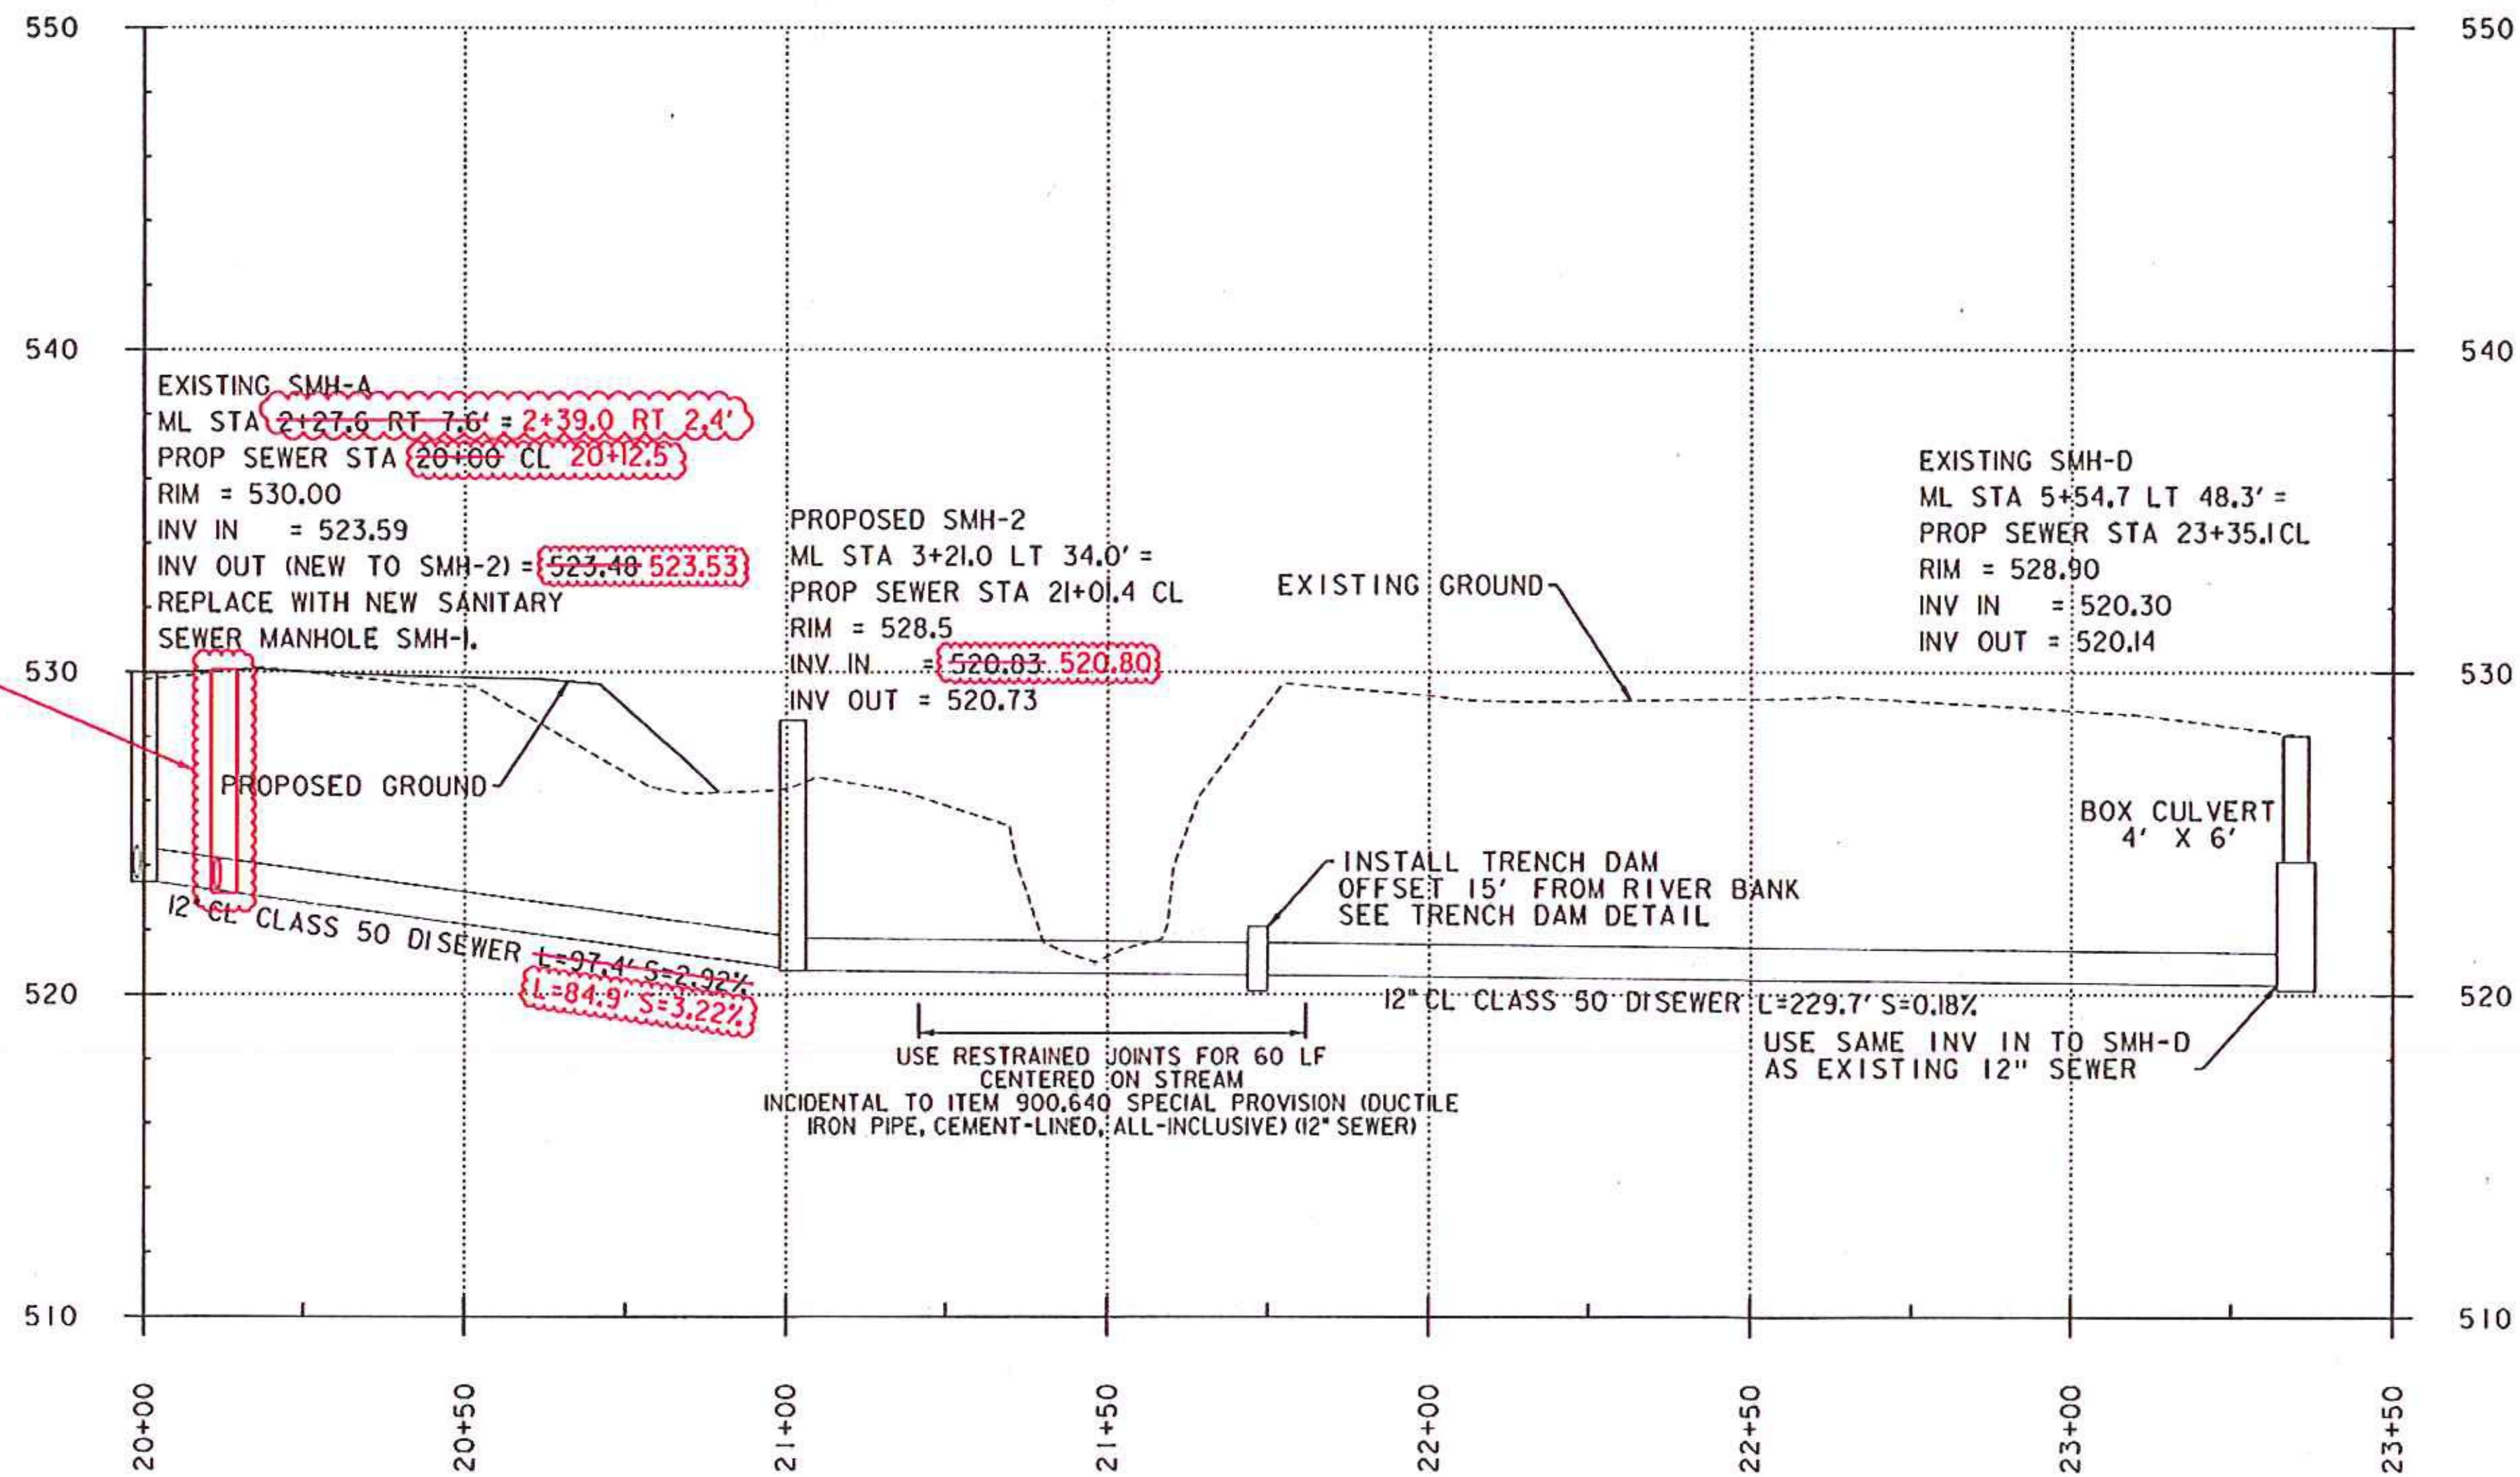

SEWER STATION

HOR. SCALE 1" = 20' -0"
VER. SCALE 1" = 4' -0"

- ② RECORD CHANGES **CLOUD**
 - ① PLAN REVISIONS
- 1/16/14: RESTRAINED JOINTS SHALL BE MEGALUGS OR APPROVED EQUAL AND CORRECTED SCALE (PER DEC).

 <small>540 Commercial Street, Manchester, NH 03101 (603) 668-8223 • Fax: (603) 668-8902 clde@cldeengineers.com • www.cldeengineers.com Maine • New Hampshire • Vermont</small>	WATER AND SEWER PLANS PROJECT NAME: RUTLAND CITY PROJECT NUMBER: BRF 3000(18)	FILE NAME: \$FILEABBREV\$ PROJECT LEADER: C. BEAN DESIGNED BY: D. LEWIS SEWER PROFILE	PLOT DATE: 3/5/2014 DRAWN BY: W. GORDON CHECKED BY: S. REICHERT SHEET 6 OF 7