


1 VOIDED SLAB TRANSVERSE SECTION
 F4
 1/2" = 1'-0"

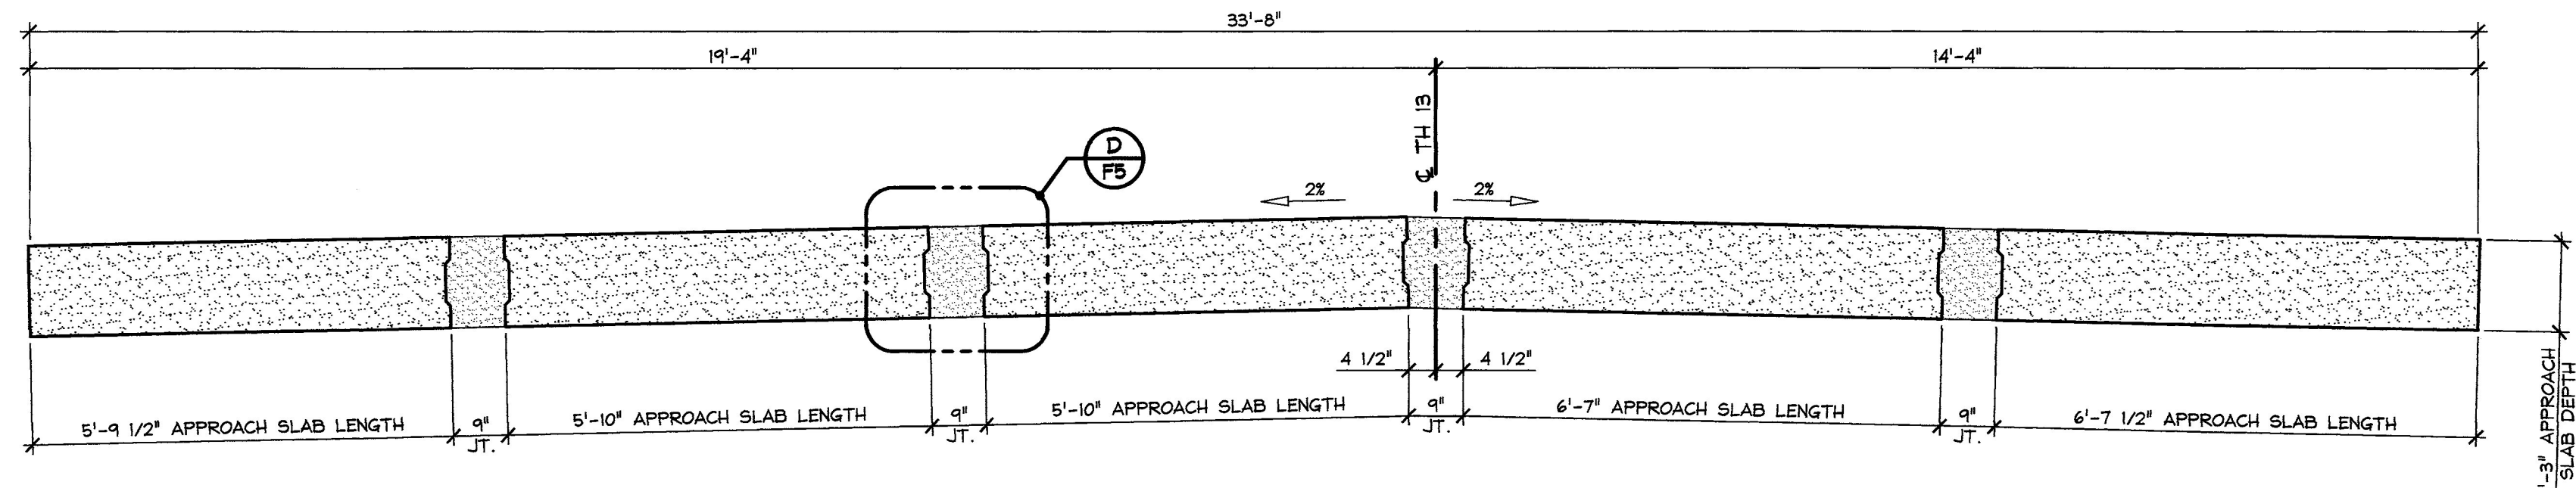

2 APPROACH SLAB TRANSVERSE SECTION
 F4
 1/2" = 1'-0"

Vermont Agency of Transportation
RECEIVED

CK'D BY M. Umberger OK'D BY C. Carlson

July 1, 2014

RESUBMIT No Approved
 BY C. Carlson DATE 07/08/2014

APPROVAL STAMP:	J.P. CARRARA & SONS INC. Precast & Prestress Manufacturer 264 OSE ST., MIDDLEBURY, VERMONT 05753 Phone: (802)388-6361 Fax: (802)388-9010	THE BELDEN COMPANY, INC. CONTRACTOR RUTLAND, VERMONT
	STATE OF VERMONT AGENCY OF TRANSPORTATION COUNTY OF RUTLAND	DATE: APR. 25, 2014 SCALE: NOTED
	CITY OF RUTLAND ROUTE NO.: TH 1B (FOREST STREET) - URBAN COLLECTOR BRIDGE NO.: 14 PROJECT NO.: BRP 3000(1B)	CHKD: M.D. DFTM: B.L. JOB NO: 23430-014
	PRESTRESSED VOIDED SLAB & PRECAST APPROACH SLAB SECTIONS	DWG. NO: F4