
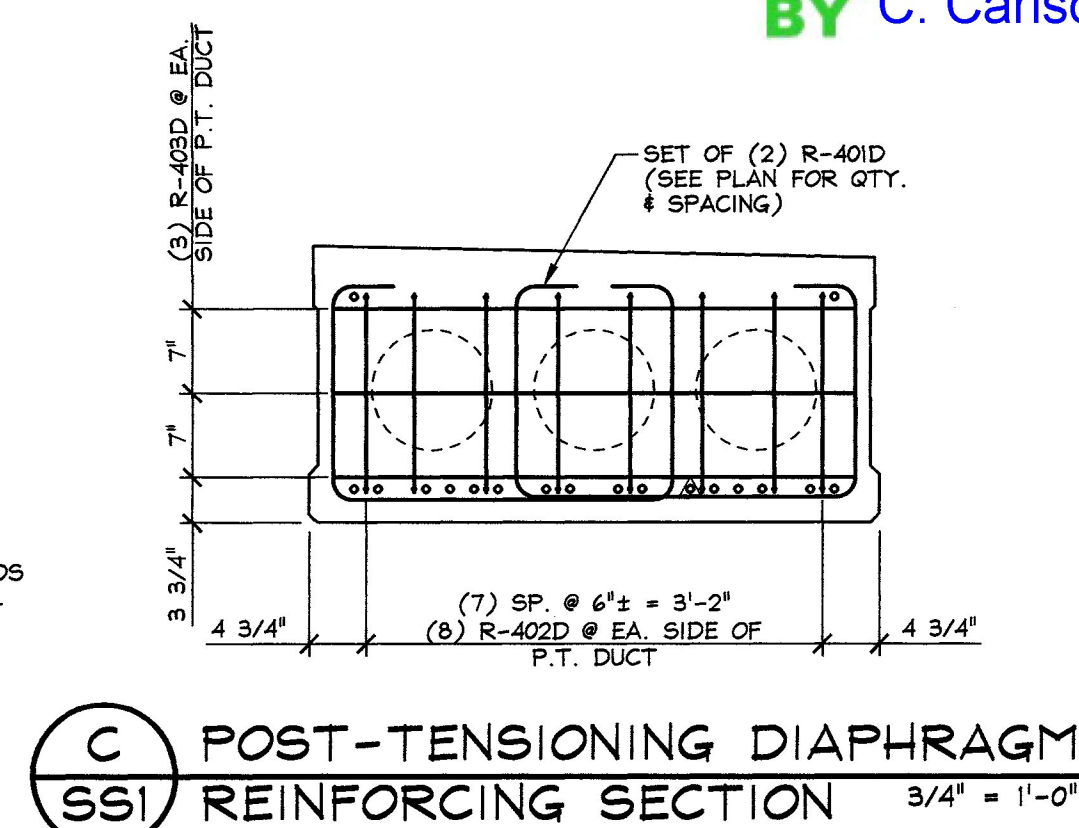
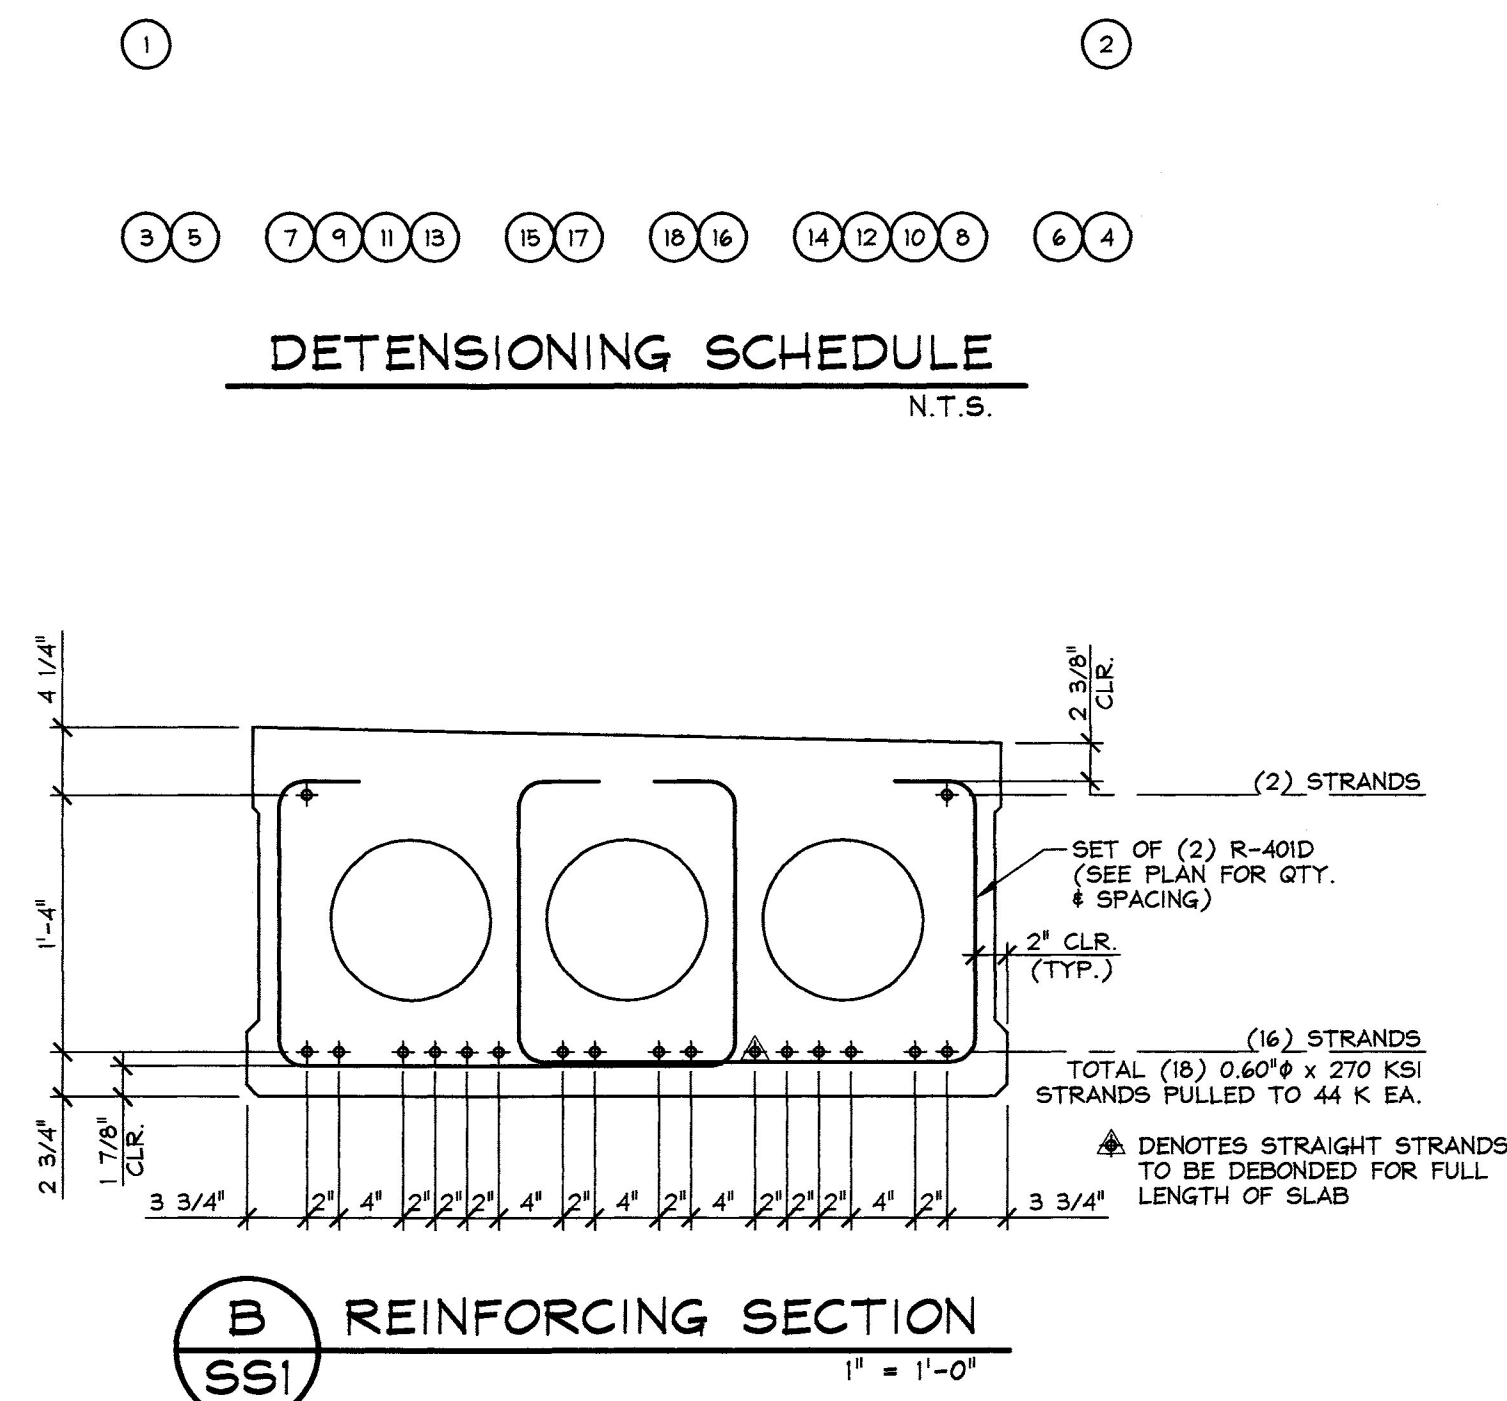
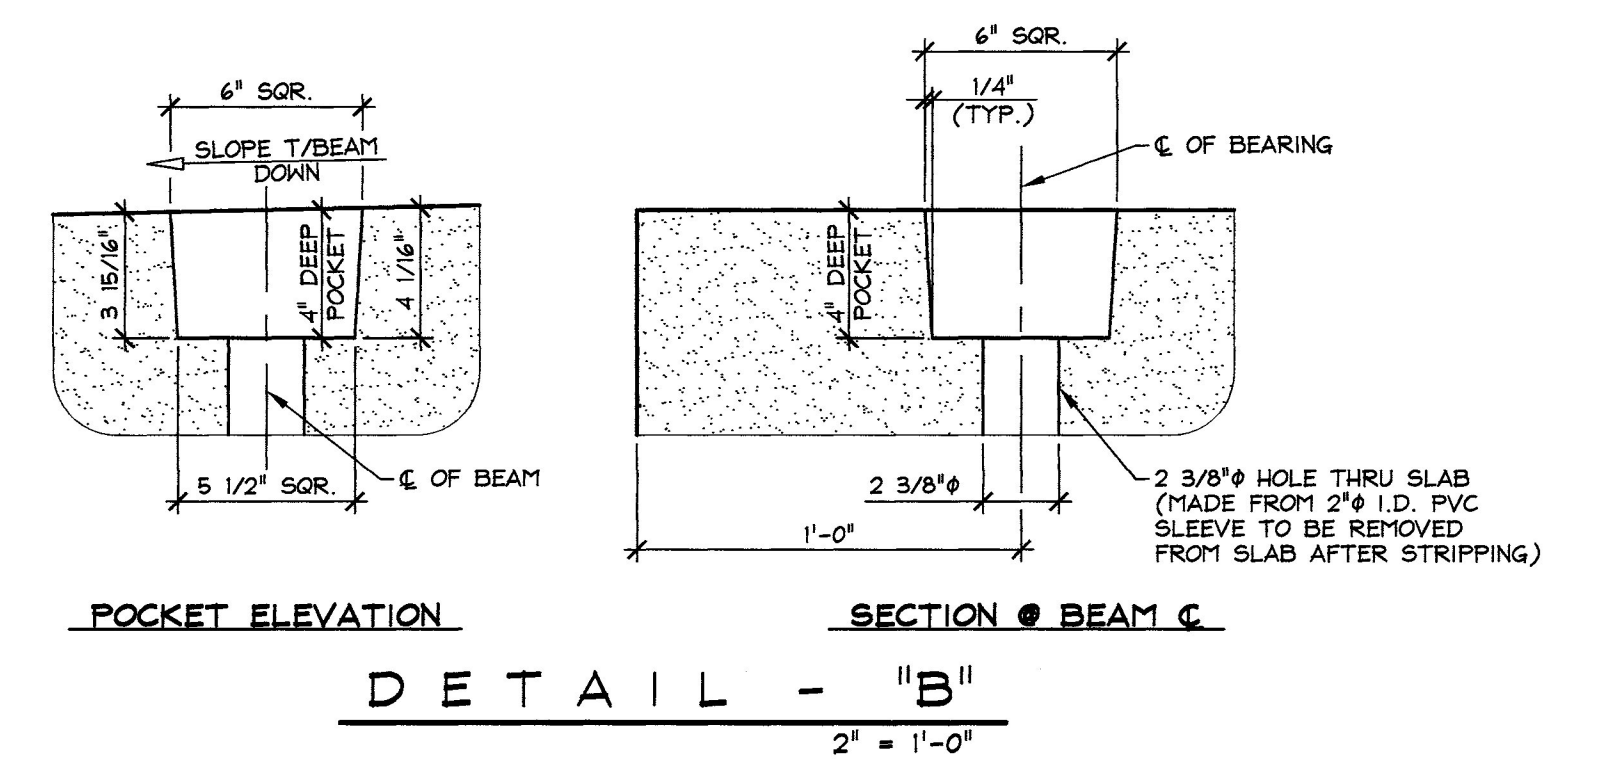


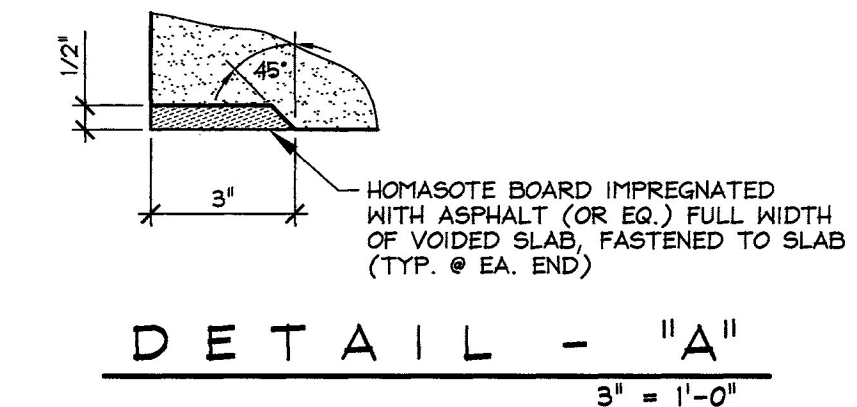

RESUBMIT No **Approved** _____
BY C. Carlson **DATE** 07/08/2014

MARK:	R-SS3	QTY.: 1	WT.: 23.22 T	VOL.: 11.47 cy
MATERIAL LIST / VOIDED SLAB				
ITEM	MARK	DESCRIPTION	QTY.	
1	R-401D	#4 BENT BAR (LEVEL II, DUAL COATED)	120	
2	R-402D	#4 BENT BAR (LEVEL II, DUAL COATED)	64	
3	R-403D	#4 x 3'-7 1/2" (LEVEL II, DUAL COATED)	24	
4				
5				
6				
7				
8				
9				
10				
11		3/4"φ x 6" NON-FERROUS VOID DRAIN	24	
12		10"φ x 9'-10" VOID	6	
13		10"φ x 10'-10" VOID	6	
14		SET OF TRIPLE 0.60"φ STRAND LIFTING LOOPS	4	
15				

APPROVAL STAMP:

J.P. CARRARA & SONS INC.
Precast & Prestress Manufacturer
2464 CASE STR., MIDDLEBURY, VERMONT 05753 Phone:(802)388-6361 Fax:(802)388-9010

THE BELDEN COMPANY, INC.
CONTRACTOR
RUTLAND, VERMONT

STATE OF VERMONT AGENCY OF TRANSPORTATION
COUNTY OF RUTLAND

DATE: APR. 25, 2014

CITY OF RUTLAND		
ROUTE NO.: TH 13 (FOREST STREET) - URBAN COLLECTOR		(
BRIDGE NO.: 14	PROJECT NO.: BRF 3000(18)	4

CHKD: M.D.	DFTM: B.L.
------------	------------

PRESTRESSED VOIDED SLAB DETAILS

DWG. NO: SS1