




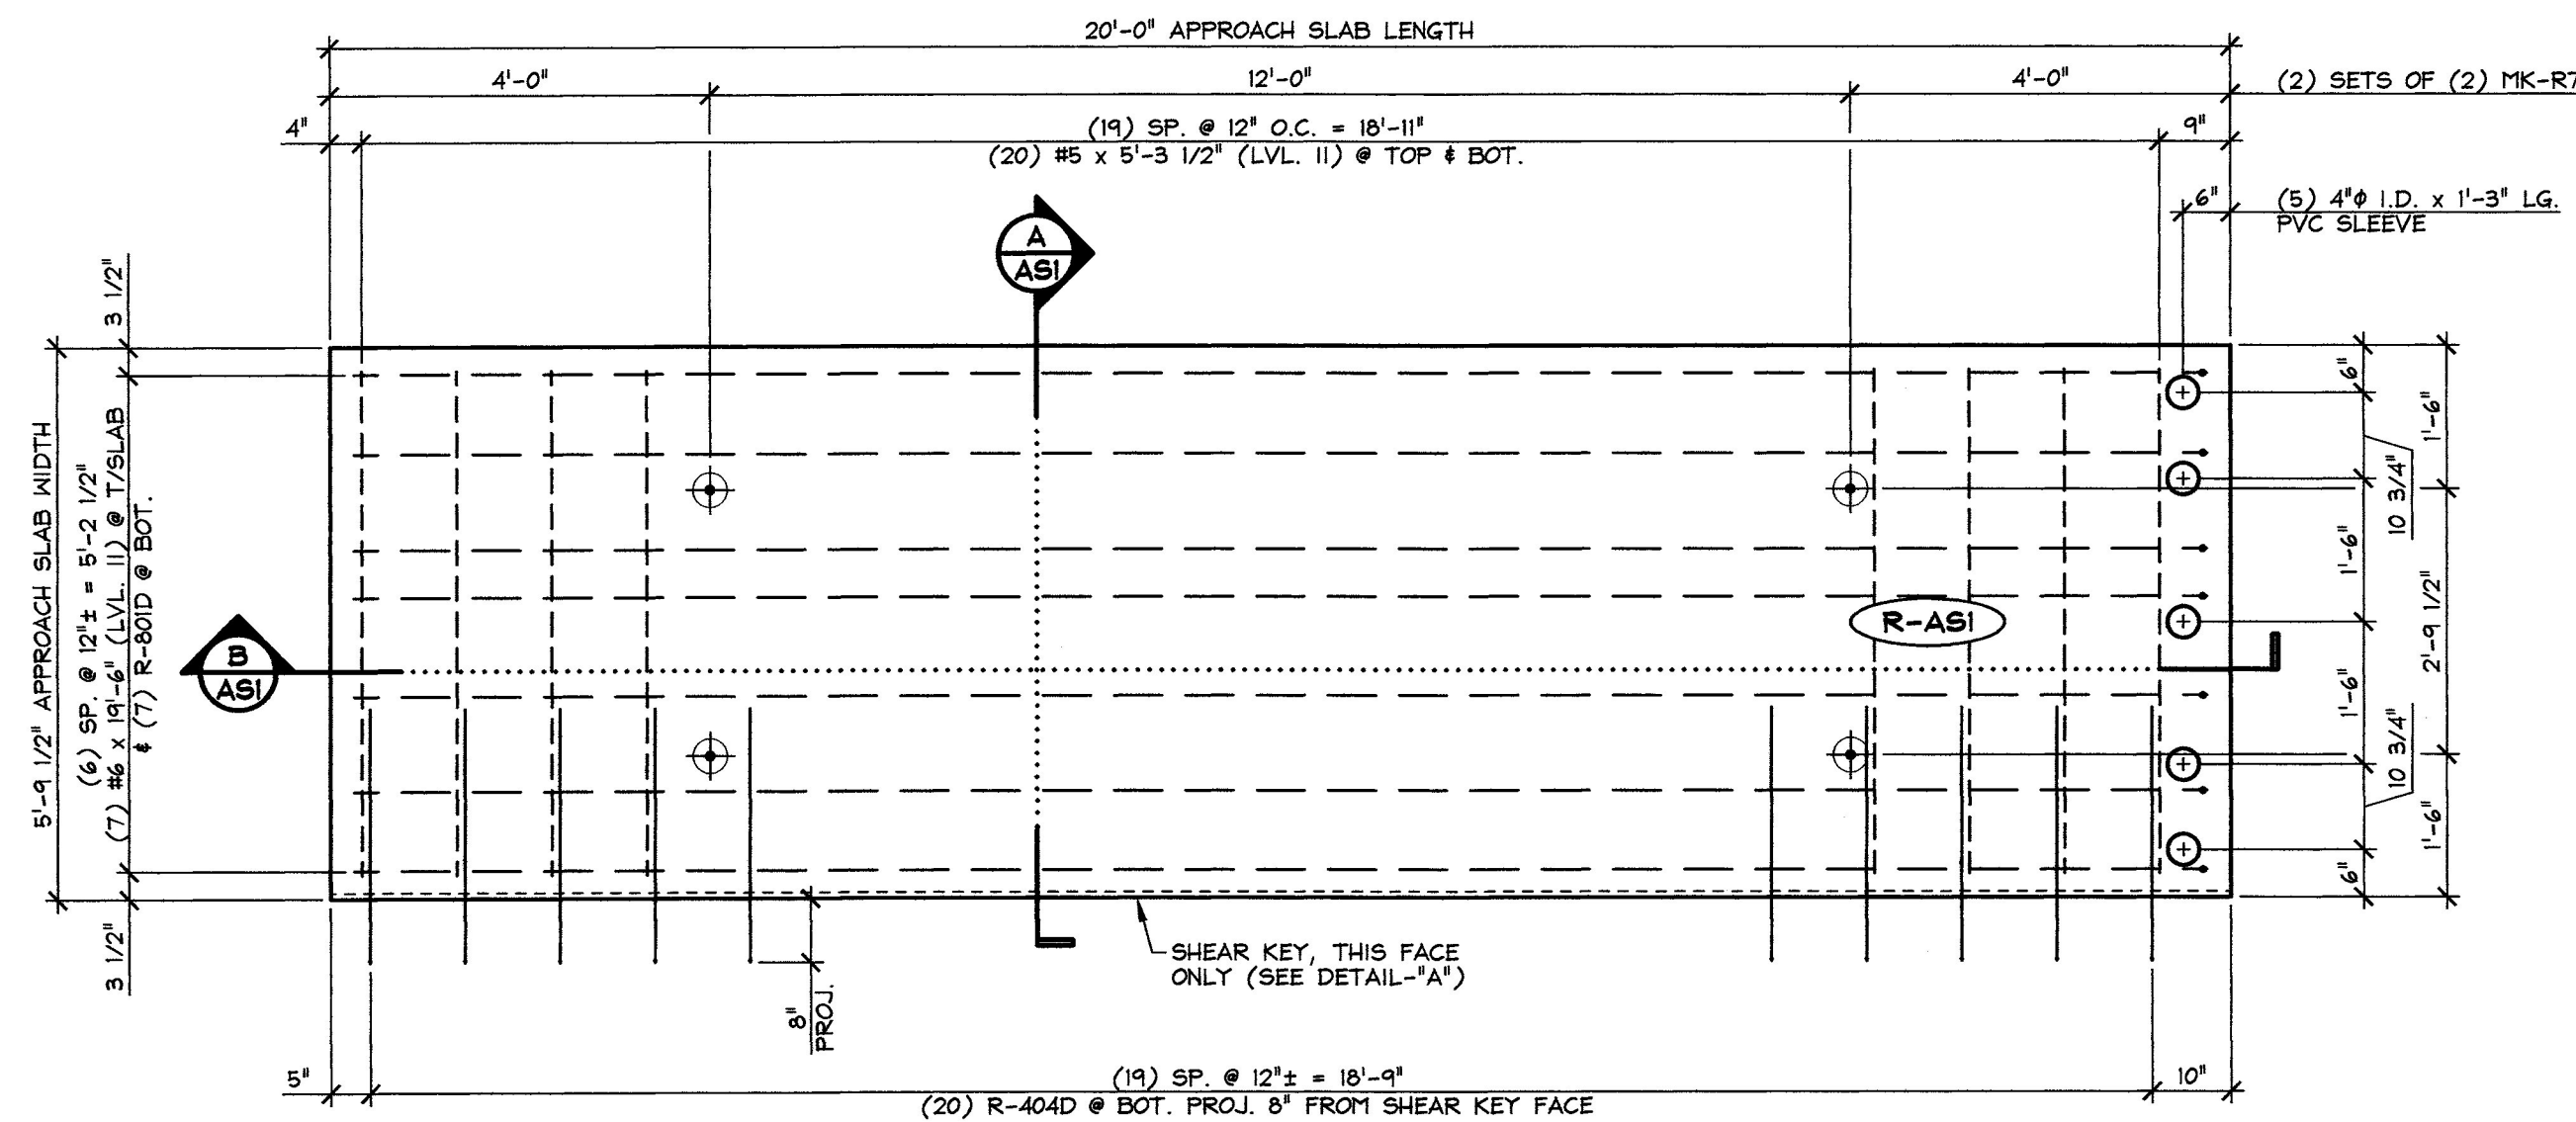

1 APPROACH SLAB PLAN VIEW IN FORM
ASI 1/2" = 1'-0"

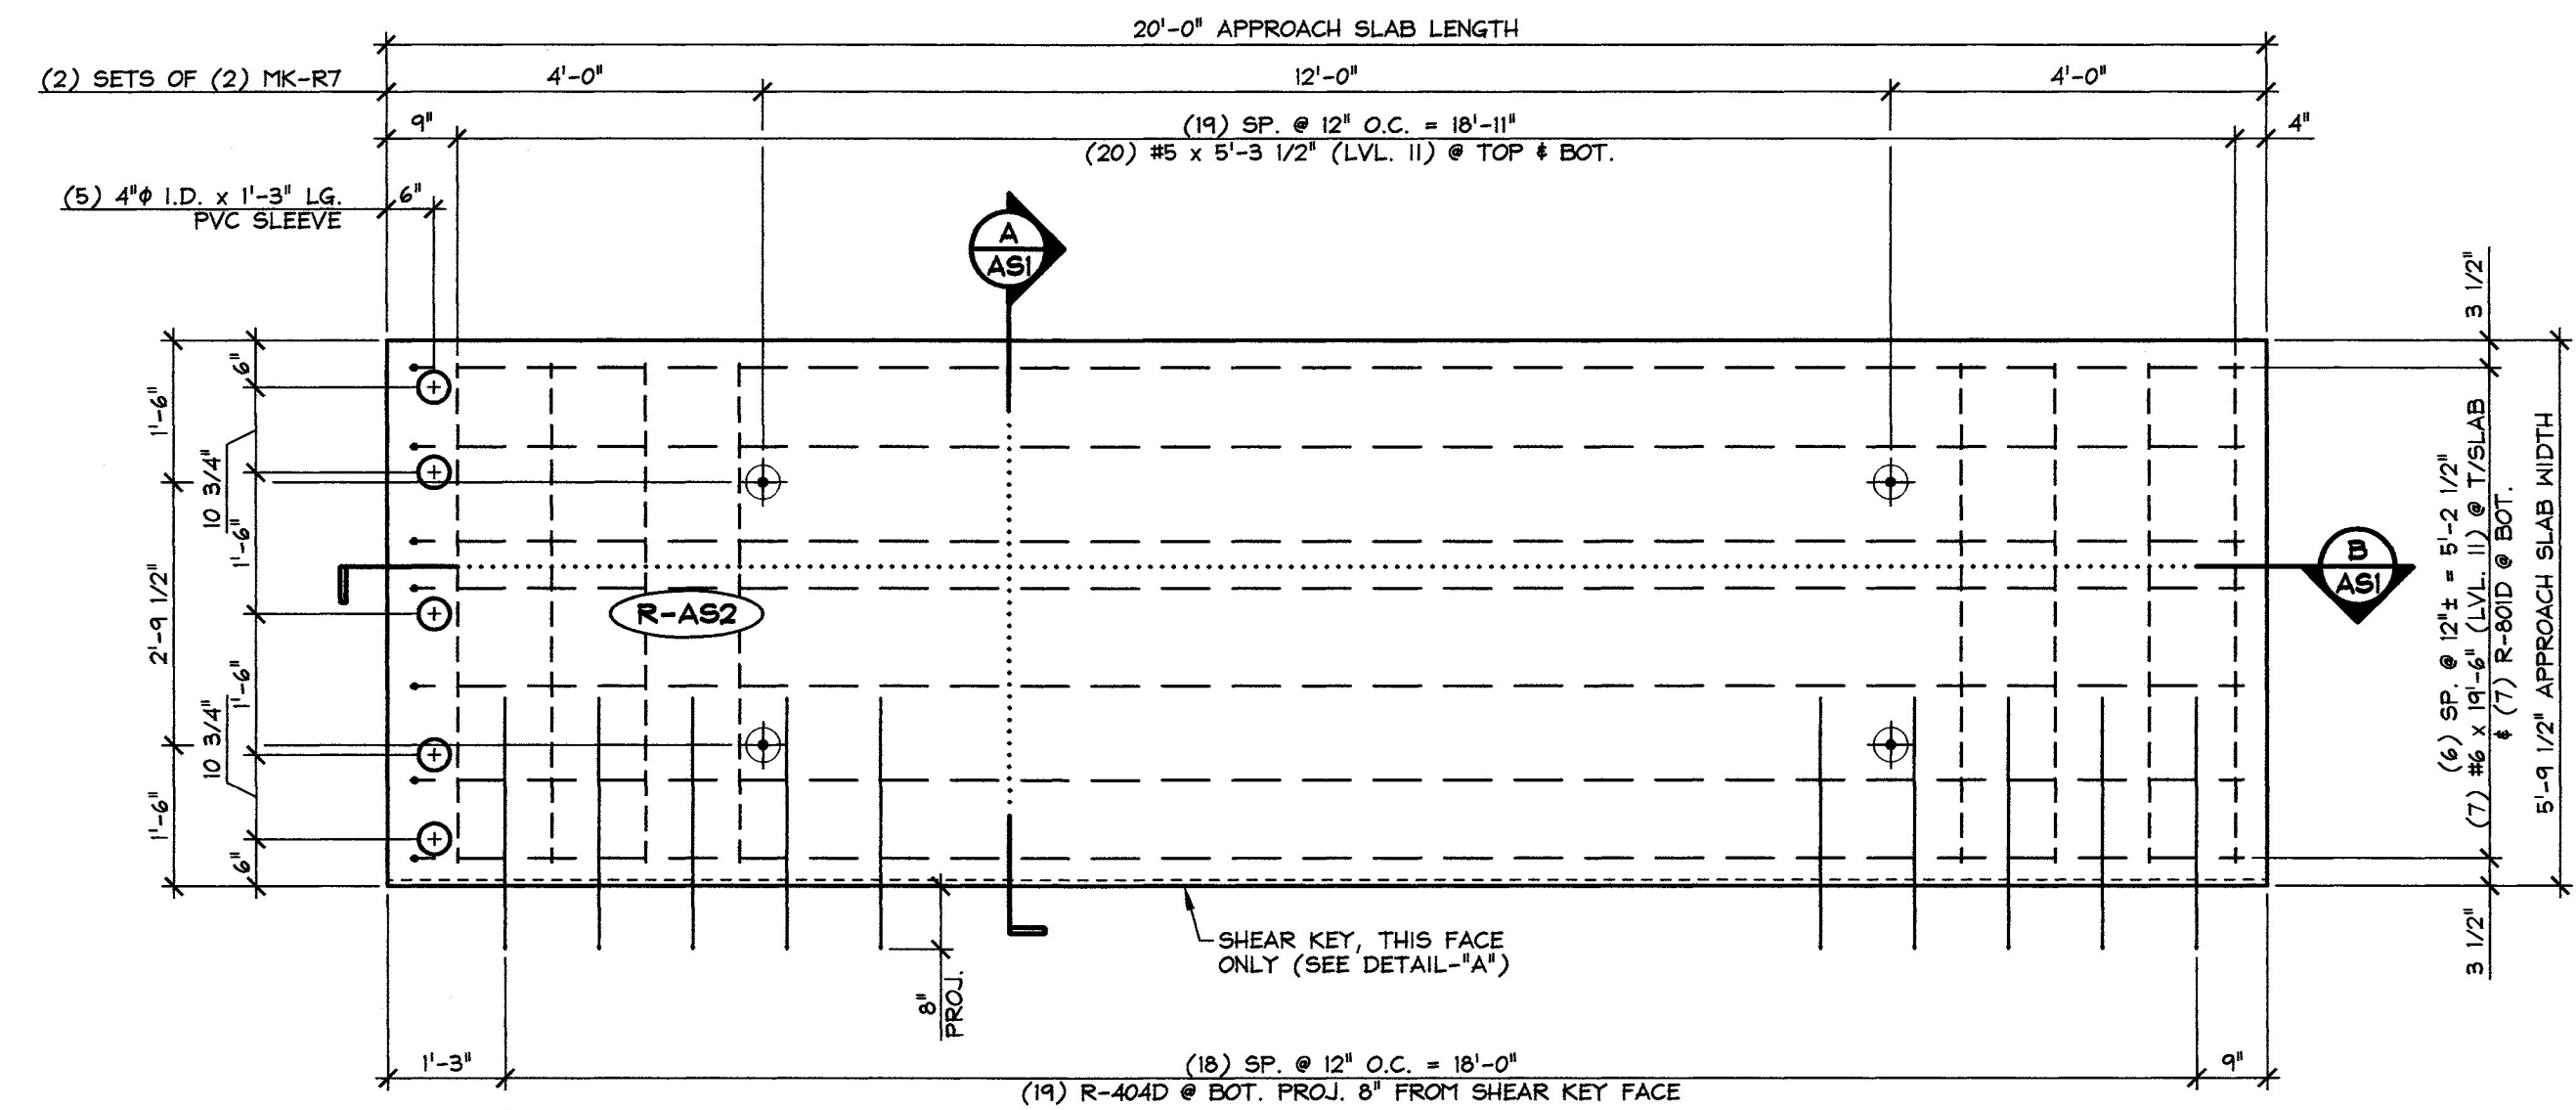


2 APPROACH SLAB PLAN VIEW IN FORM
ASI 1/2" = 1'-0"

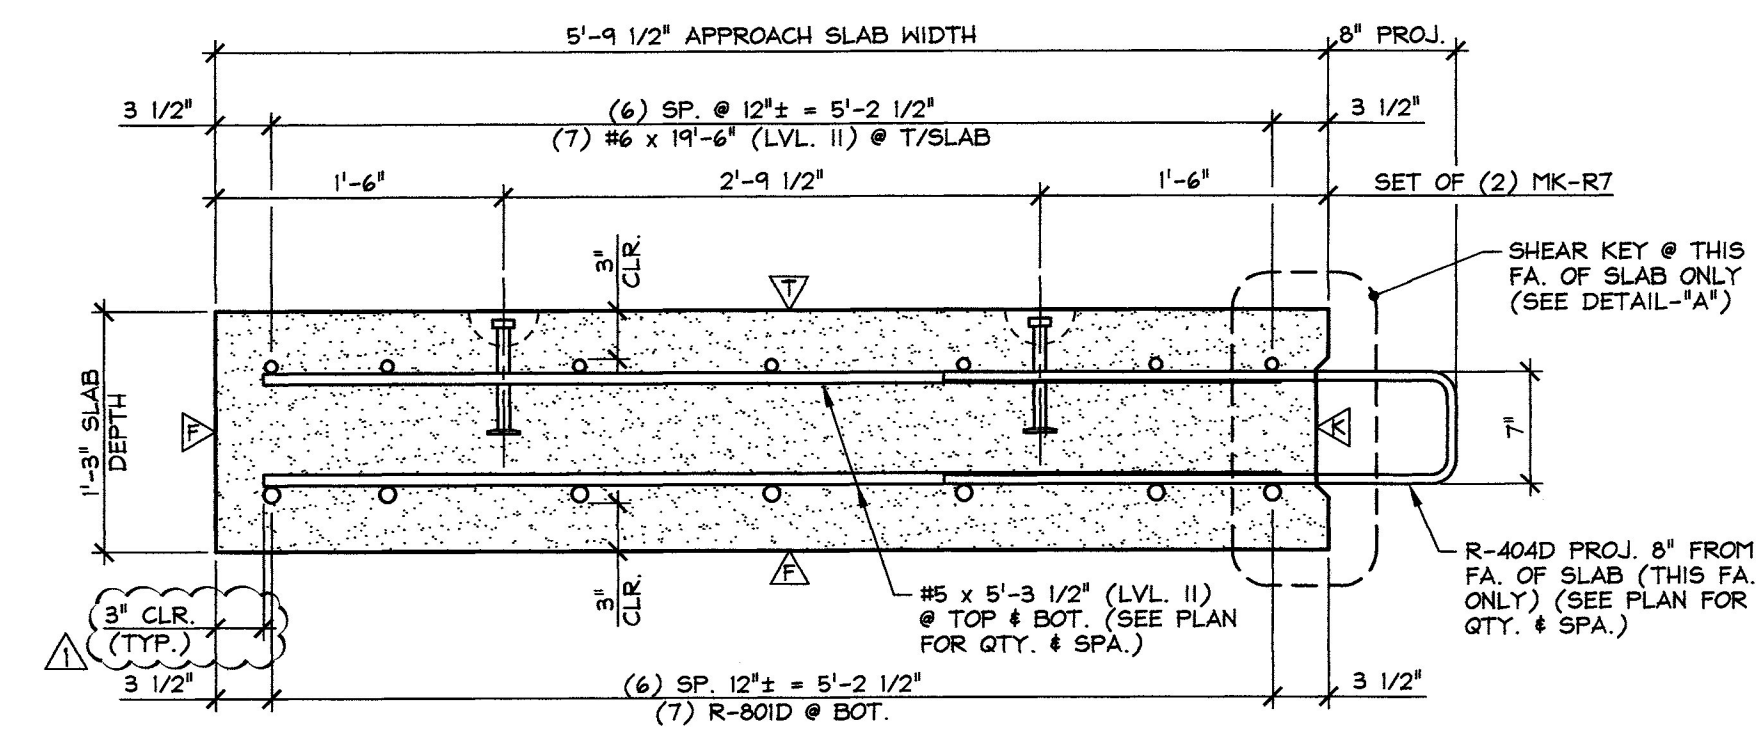


A TRANSVERSE SECTION
ASI 1" = 1'-0"

△ DENOTES FORM FINISH
△ DENOTES FLOAT FINISH
△ DENOTES ROUGHENED FINISH

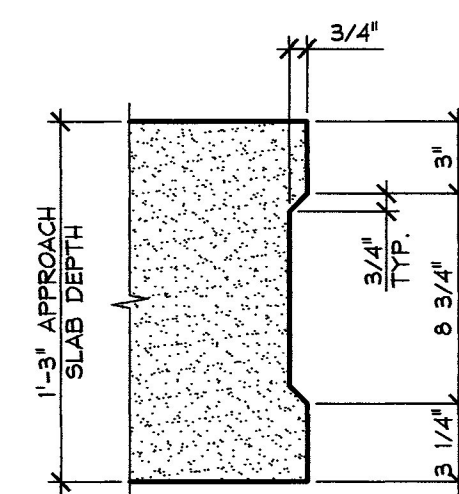

DETAIL - "A"
1 1/2" = 1'-0"

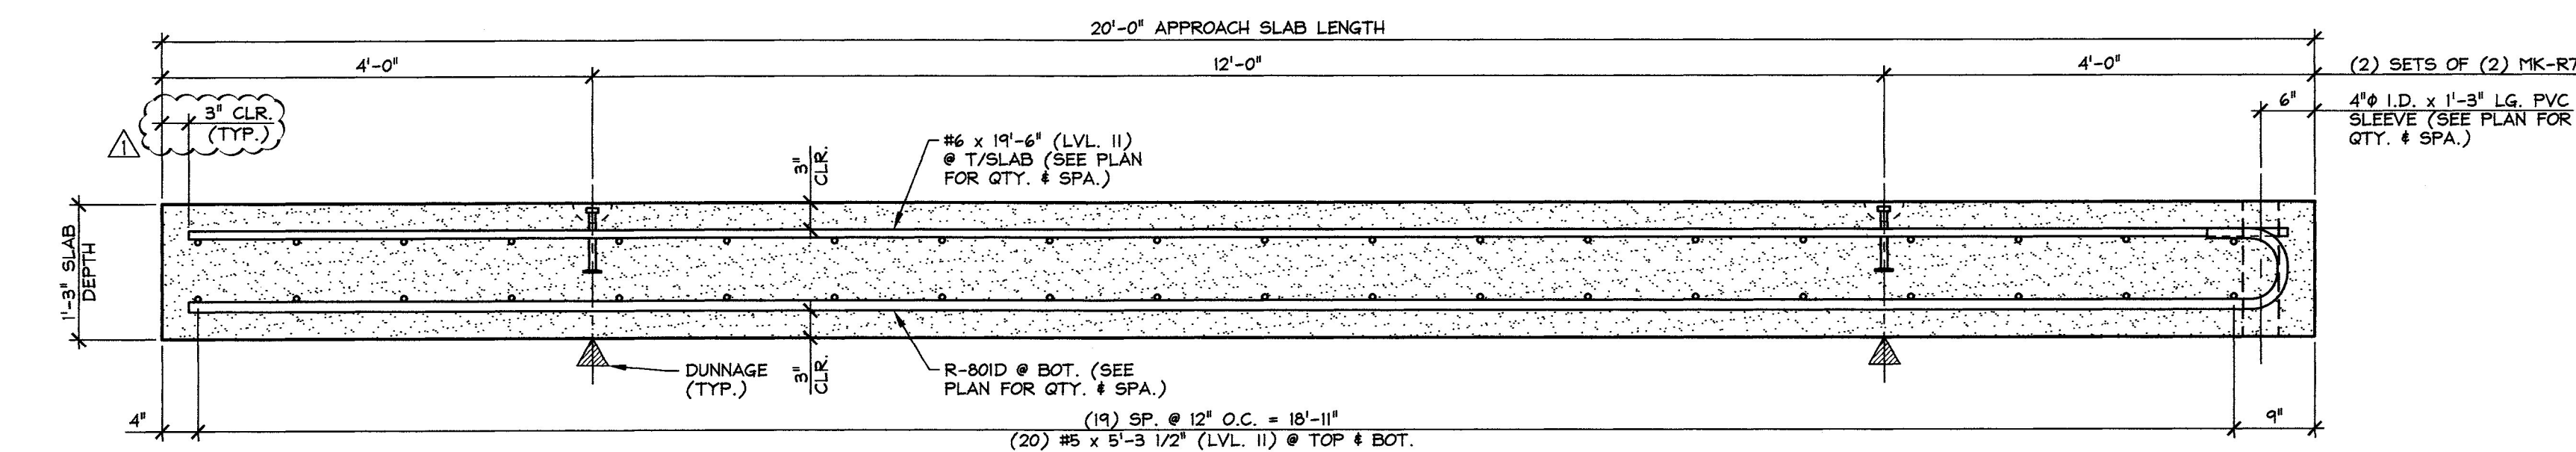

B LONGITUDINAL SECTION
ASI 3/4" = 1'-0"

Vermont Agency of Transportation
RECEIVED

CK'D BY M. Umberger OK'D BY C. Carlson

July 1, 2014

RESUBMIT No Approved
BY C. Carlson DATE 07/08/2014

MARK:	R-ASI	QTY.:	1	WT.:	10.8 T	VOL.:	5.3 cy
MARK:	R-AS2	QTY.:	1	WT.:	10.8 T	VOL.:	5.3 cy
MATERIAL LIST / APPROACH SLAB							
ITEM	MARK	DESCRIPTION	QTY./SLAB				
			R-ASI	R-AS2			
1	R-404D	#4 BENT BAR (LEVEL II, DUAL COATED)	20	19			
2							
3		#5 x 5'-3 1/2" (LEVEL II, DUAL COATED)	40	40			
4							
5		#6 x 19'-6" (LEVEL II, DUAL COATED)	7	7			
6							
7	R-B01D	#8 BENT BAR (LEVEL II, DUAL COATED)	7	7			
8							
9	MK-R7	4T x 7 1/8" SHIFT LIFT LIFTER (GALVANIZE)	4	4			
10		4" I.D. x 1'-3" PVC SLEEVE	5	5			

7-1-14 REVISED AS NOTED

APPROVAL STAMP:

J.P. CARRARA & SONS INC.
Precast & Prestress Manufacturer
2464 OSE ST., MIDDLEBURY, VERMONT 05753 Phone: (802) 388-6361 Fax: (802) 388-9010

THE BELDEN COMPANY, INC.
CONTRACTOR
RUTLAND, VERMONT

STATE OF VERMONT AGENCY OF TRANSPORTATION
COUNTY OF RUTLAND

DATE: APR. 25, 2014

CITY OF RUTLAND
ROUTE NO.: TH 13 (FOREST STREET) - URBAN COLLECTOR
BRIDGE NO.: 14 PROJECT NO.: BRF 3000(18)

SCALE: NOTED

CHKD: M.D. DFTM: B.L.

JOB NO: 23430-014

PRECAST APPROACH SLAB DETAILS

DWG. NO: ASI