




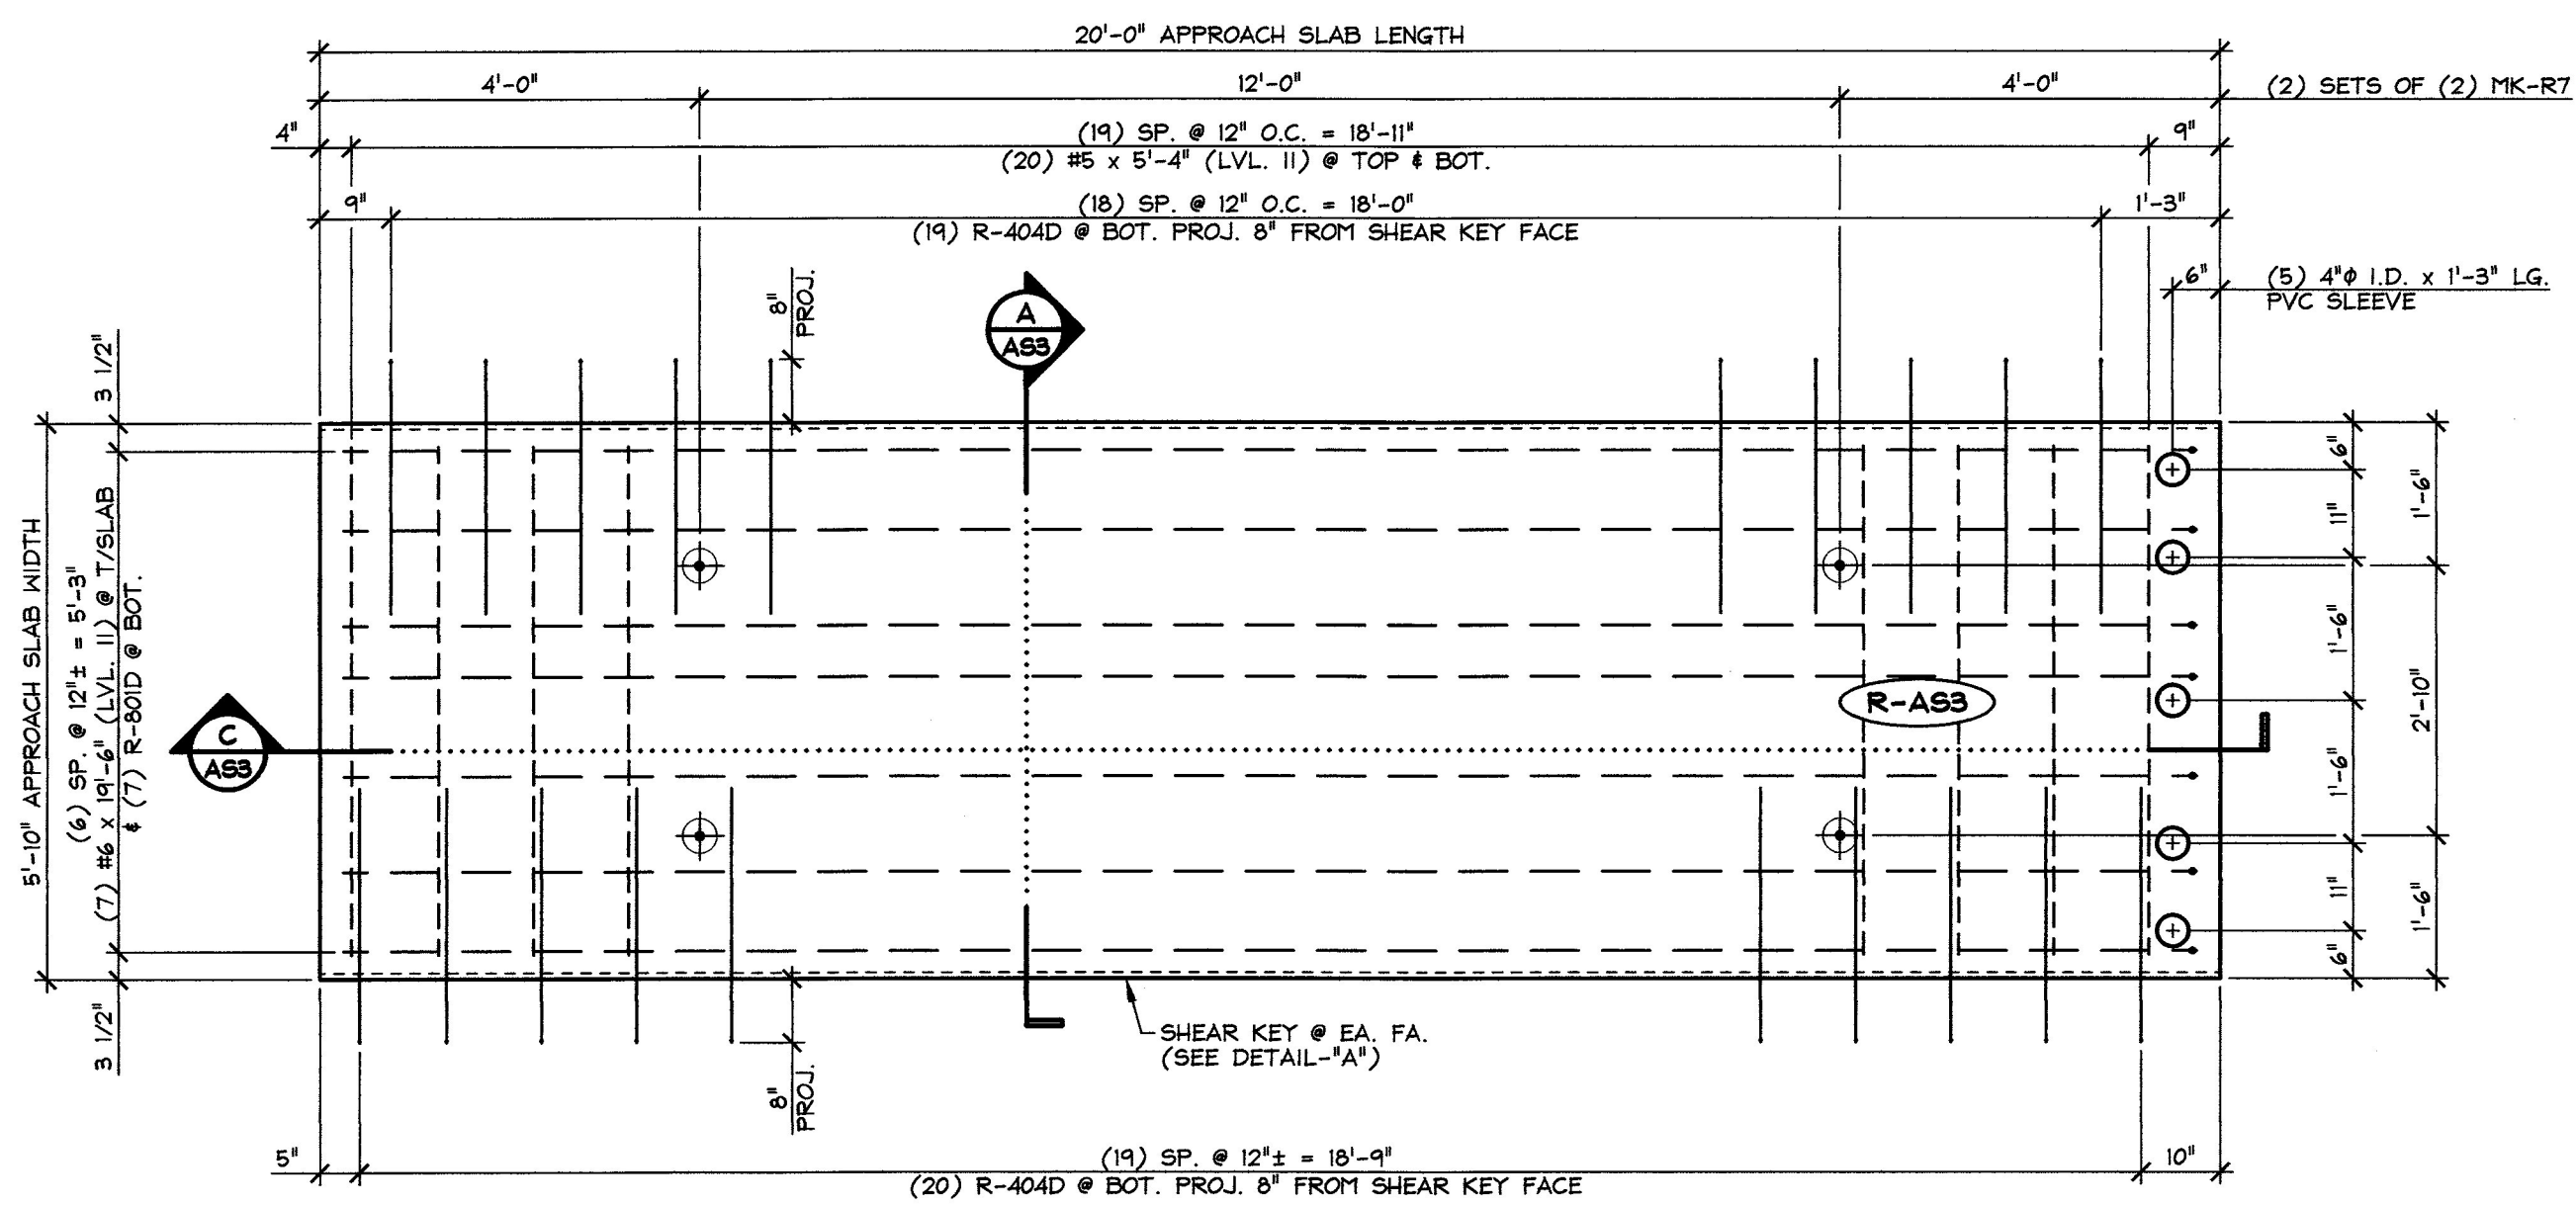

1 APPROACH SLAB PLAN VIEW IN FORM
AS3
1/2" = 1'-0"

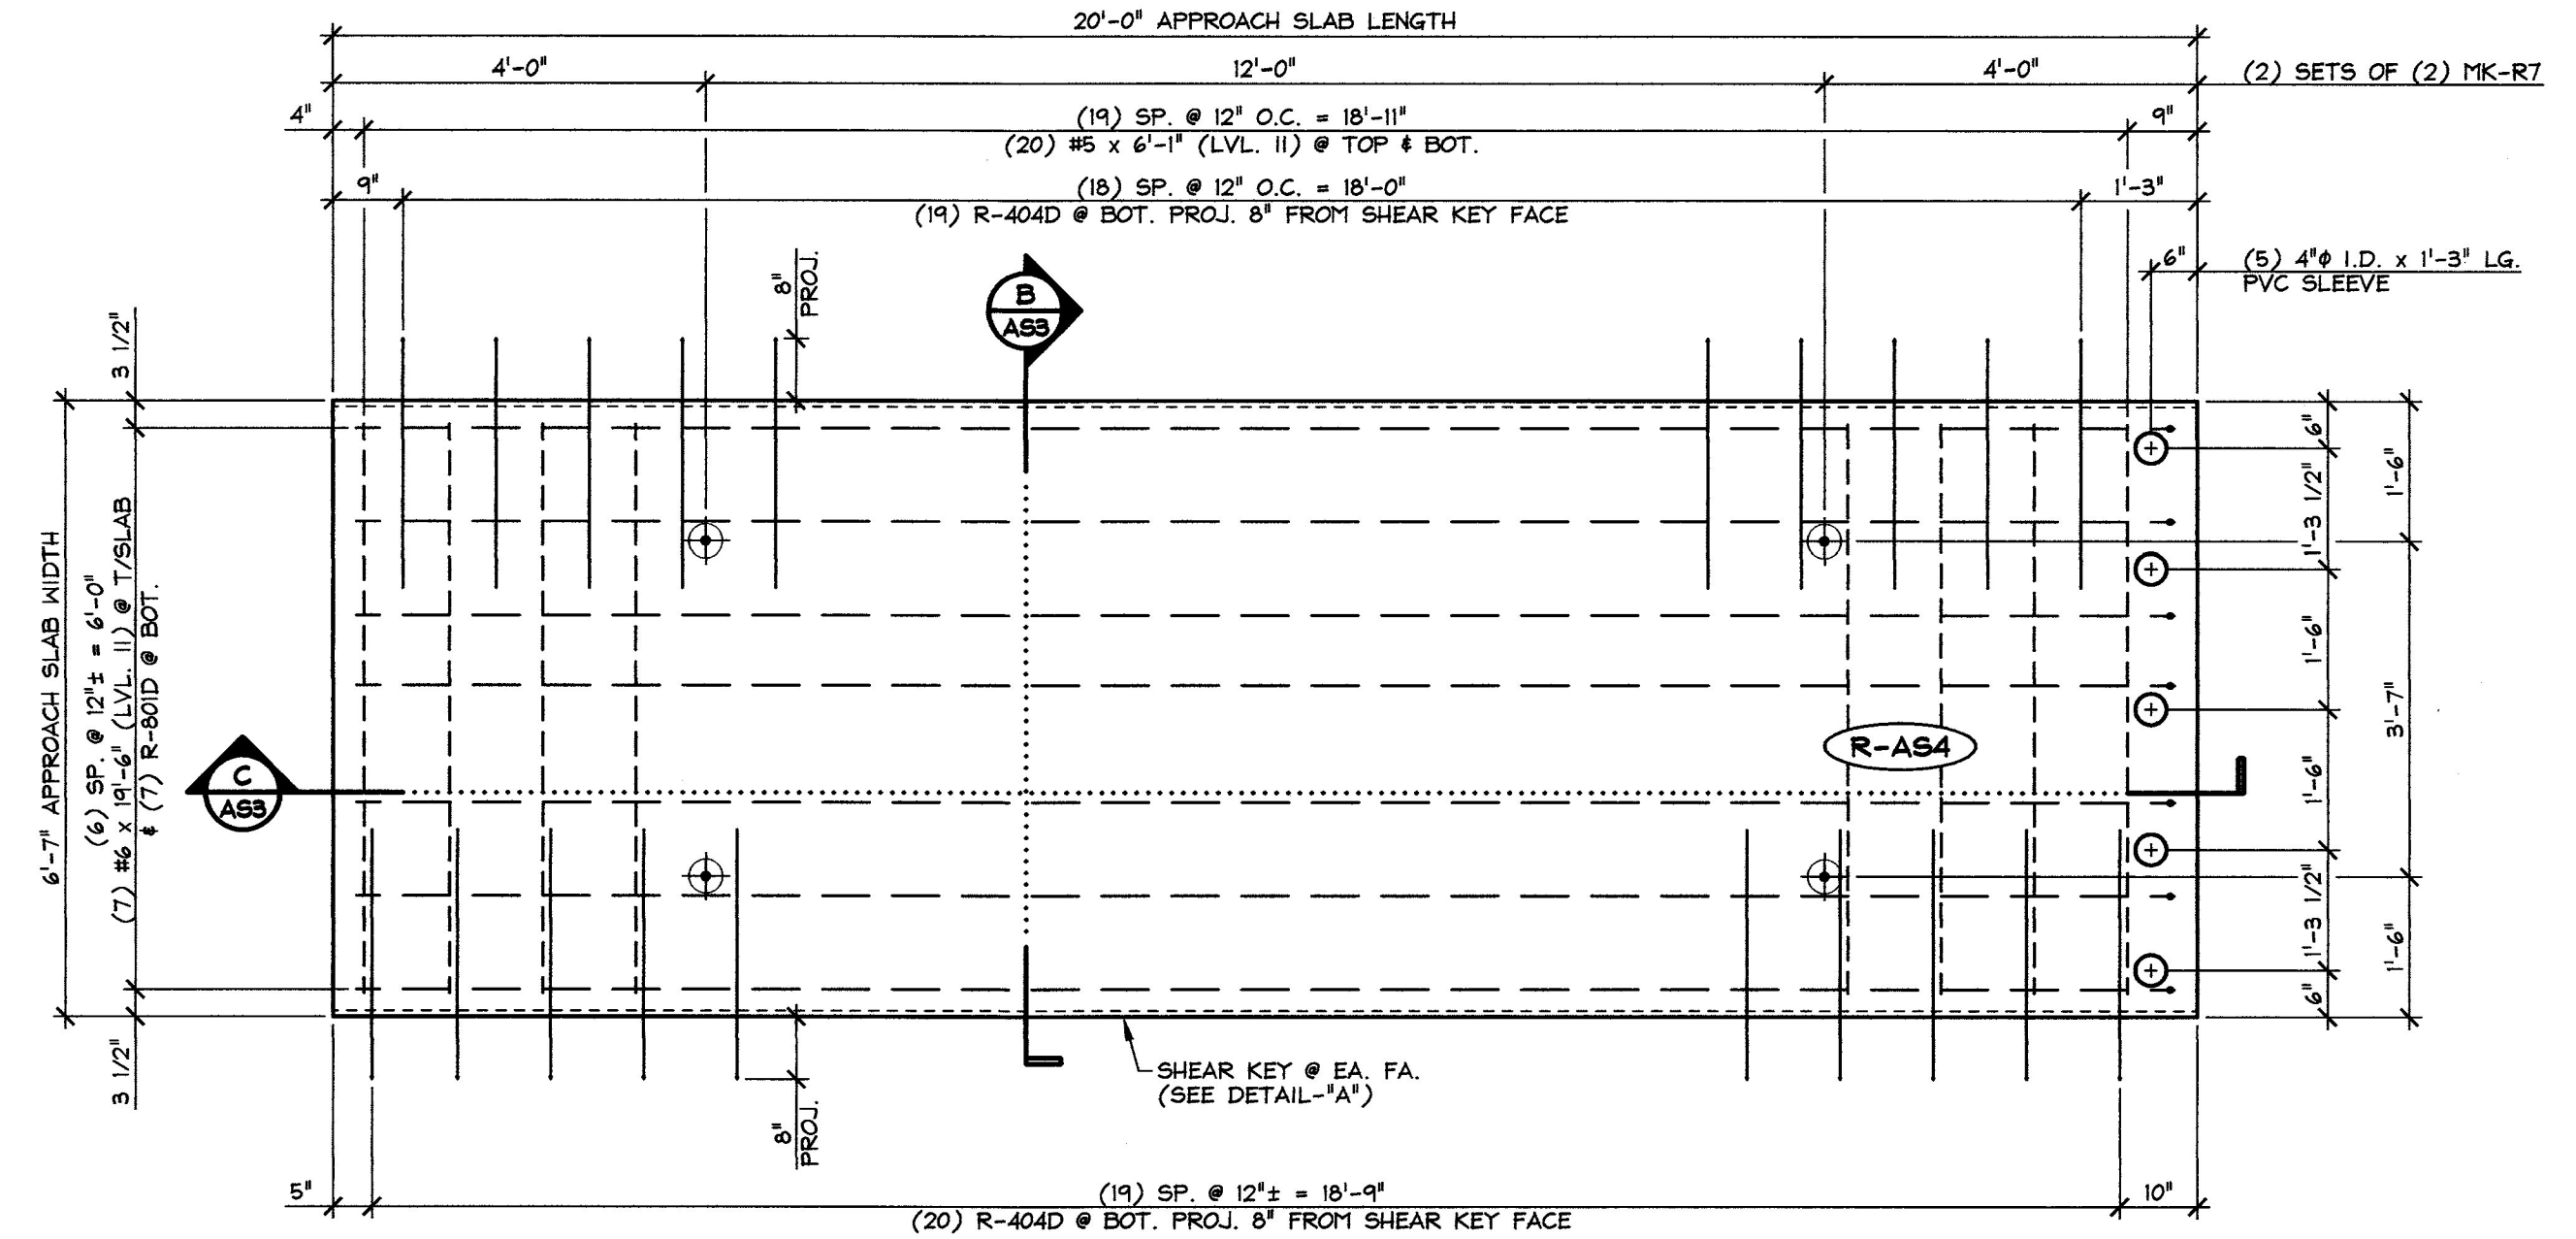


2 APPROACH SLAB PLAN VIEW IN FORM
AS3
1/2" = 1'-0"

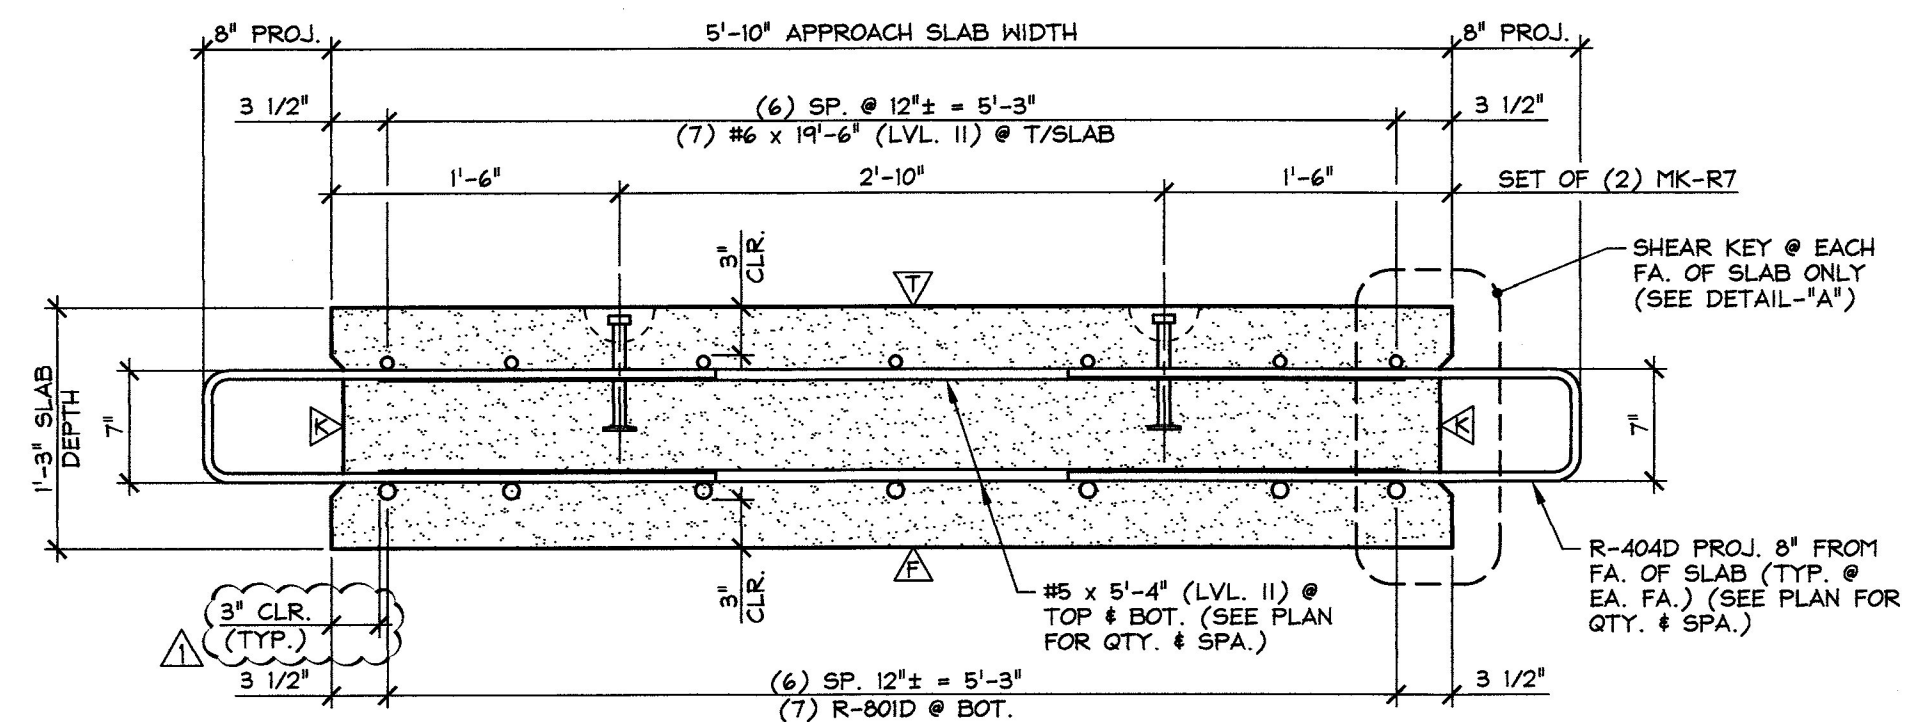


A TRANSVERSE SECTION
AS3
1" = 1'-0"

△ DENOTES FORM FINISH
△ DENOTES FLOAT FINISH
△ DENOTES ROUGHENED FINISH

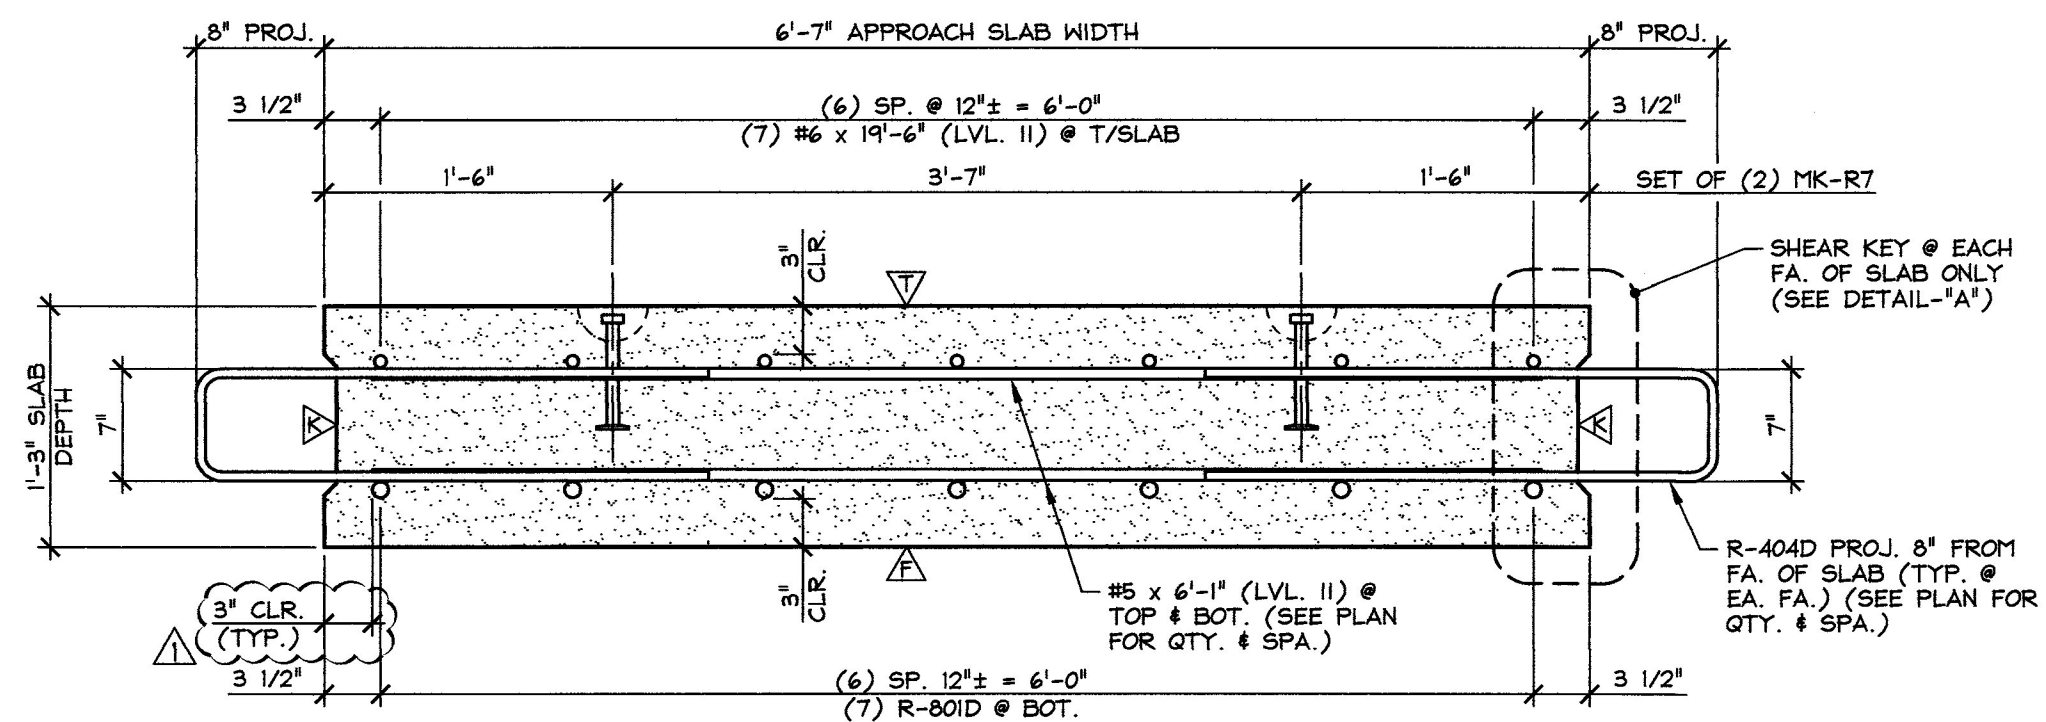


B TRANSVERSE SECTION
AS3
1" = 1'-0"

△ DENOTES FORM FINISH
△ DENOTES FLOAT FINISH
△ DENOTES ROUGHENED FINISH

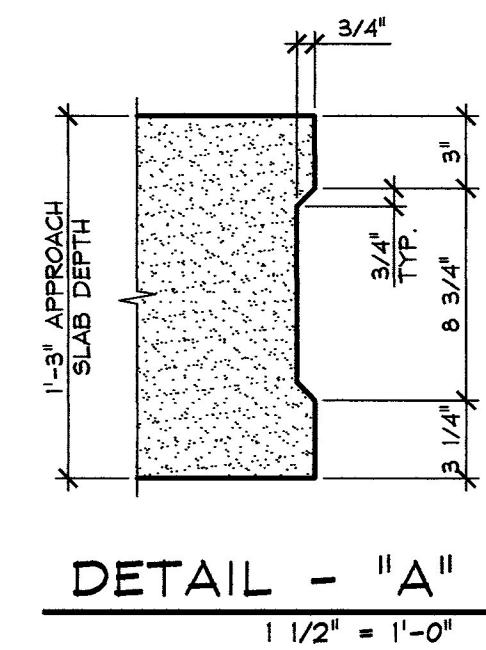

DETAIL - "A"
1 1/2" = 1'-0"

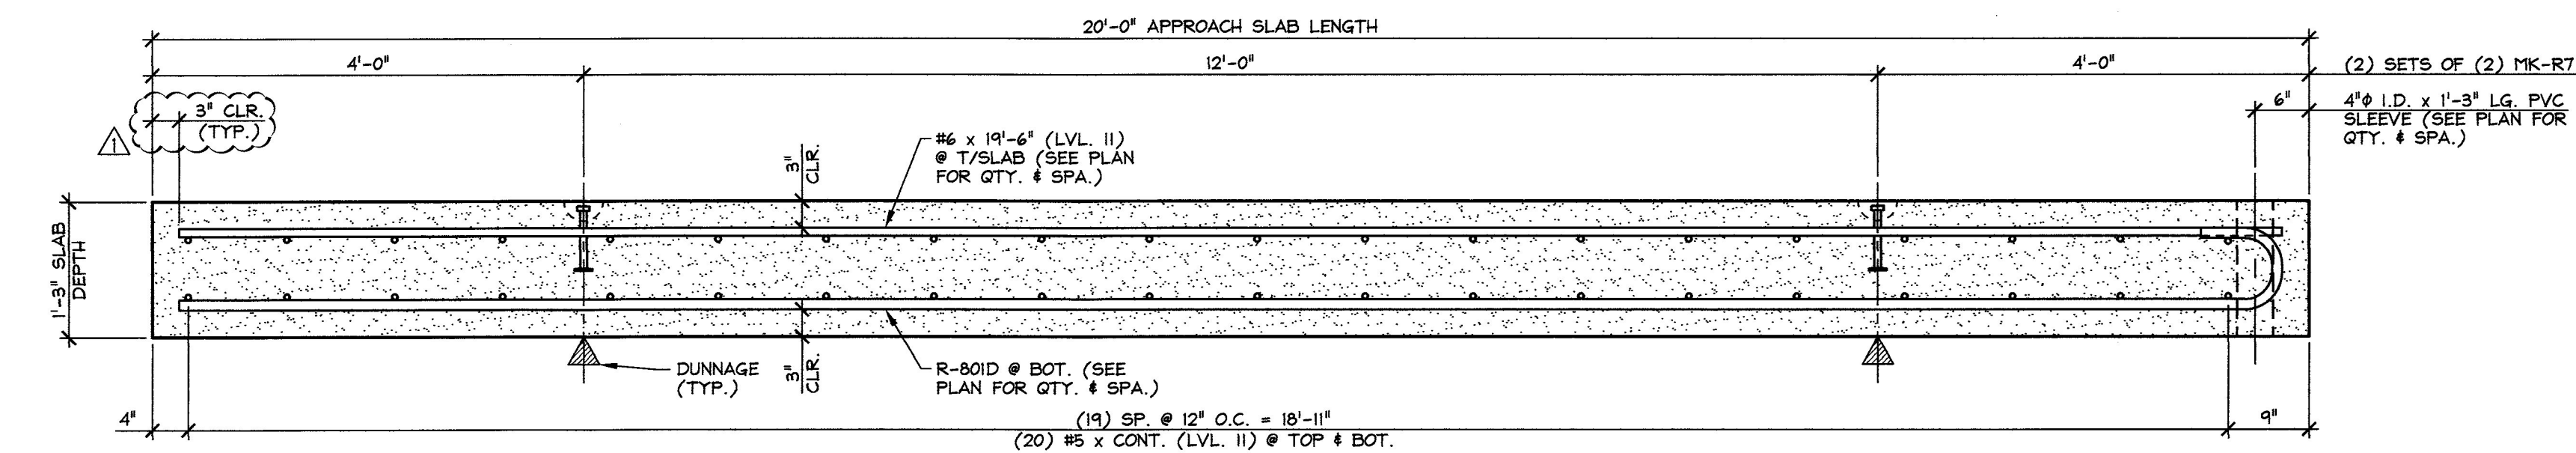

C LONGITUDINAL SECTION
AS3
3/4" = 1'-0"

Vermont Agency of Transportation
RECEIVED
CK'D BY M. Umberger OK'D BY C. Carlson
July 1, 2014
RESUBMIT No Approved
BY C. Carlson DATE 07/08/2014

MARK:	R-AS3	QTY.:	4	WT.:	10.8 T	VOL.:	5.3 cy
MARK:	R-AS4	QTY.:	2	WT.:	12.2 T	VOL.:	6.0 cy
MATERIAL LIST / APPROACH SLAB							
ITEM	MARK	DESCRIPTION	QTY./SLAB				
			R-AS3	R-AS4			
1	R-404D	#4 BENT BAR (LEVEL II, DUAL COATED)	39	39			
2		#5 x 5'-4" (LEVEL II, DUAL COATED)	40				
3		#5 x 6'-1" (LEVEL II, DUAL COATED)		40			
4							
5		#6 x 19'-6" (LEVEL II, DUAL COATED)	7	7			
6							
7	R-801D	#8 BENT BAR (LEVEL II, DUAL COATED)	7	7			
8							
9	MK-R7	4T x 7 1/8" SHIFT LIFT LIFTER (GALVANIZE)	4	4			
10		4" I.D. x 1'-3" PVC SLEEVE	5	5			

7-1-14 REVISED AS NOTED

APPROVAL STAMP:

J.P. CARRARA & SONS INC. Precast & Prestress Manufacturer 2464 GSE STR., MIDDLEBURY, VERMONT 05753 Phone: (802) 388-6381 Fax: (802) 388-9010		THE BELDEN COMPANY, INC. CONTRACTOR RUTLAND, VERMONT	
STATE OF VERMONT AGENCY OF TRANSPORTATION COUNTY OF RUTLAND		DATE: APR. 25, 2014	
CITY OF RUTLAND ROUTE NO.: TH 13 (FOREST STREET) - URBAN COLLECTOR BRIDGE NO.: 14 PROJECT NO.: BRP 3000(18)		SCALE: NOTED	
PRECAST APPROACH SLAB DETAILS		CHKD: M.D. DFTM: B.L.	
		JOB NO: 23430-014	
		DWG. NO: AS3	