




1 ABUTMENT DIMENSIONAL DETAILS 3/8" = 1'-0"

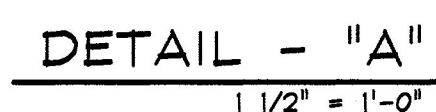

2 ABUTMENT REINFORCING DETAILS 3/8" = 1'-0"

MATERIAL LIST / ABUTMENT			
ITEM	MARK	DESCRIPTION	QTY.
1	R-505D	#5 BENT BAR (LEVEL II, DUAL COATED)	8
2	R-506D	#5 BENT BAR (LEVEL II, DUAL COATED)	22
3	R-507D	#5 BENT BAR (LEVEL II, DUAL COATED)	14
4	R-508D	#5 HAIRPIN (LEVEL II, DUAL COATED)	16
5		#5 x 7'-6" (LEVEL II, DUAL COATED)	8
6		#5 x 17'-11" (LEVEL II, DUAL COATED)	12
7		#5 x 2'-11 3/4" (LEVEL II, DUAL COATED)	6
8			
9	R-601D	#6 BENT BAR (LEVEL II, DUAL COATED)	8
10			
11		#8 x 4'-0" (LEVEL II, DUAL COATED)	11
12			
13		2'-0" x 5'-7 3/16" CORRUGATED STEEL PIPE (GALV.)	2
14	MK-R8	20T x 19 3/4" SWIFT LIFT LIFTER (GALV.)	2
15			

RECEIVED

July 1, 2014

RESUBMIT No **Approved** _____
BY C. Carlson **DATE** 07/08/2014

7-1-14 REVISED AS NOTED

APPROVAL STAMP:

J.P. CARRARA & SONS INC.

Precast & Prestress Manufacturers
2464 CASE STR., MIDDLEBURY, VERMONT 05753 Phone:(802)388-6361 Fax:

THE BELDEN COMPANY, INC.
CONTRACTOR
RUTLAND, VERMONT

STATE OF VERMONT AGENCY OF TRANSPORTATION
COUNTY OF RUTLAND

DATE: APR. 25, 2014

CITY OF RUTLAND
ROUTE NO.: TH 13 (FOREST STREET) - URBAN COLLECTOR
BRIDGE NO.: 14 PROJECT NO.: BRP 3000(18)

N	DATE: APR. 25, 2014
	SCALE: NOTED

CHKD: M.D.	DFTM: B.L
JOB NO: 23430-014	

PRECAST ABUTMENT DETAILS

DWG. NO: AB2