



NOTE: GRADES SHOWN TO THE NEAREST TENTH ARE EXISTING GROUND ALONG CENTERLINE.
 GRADES SHOWN TO THE NEAREST HUNDRETH ARE FINISH GRADES ALONG CENTERLINE.

Profile Along Centerline of Route 132 (T.H. 3)

SCALE: HORIZ. 1" = 20'-0"
 VERT. 1" = 10'-0"

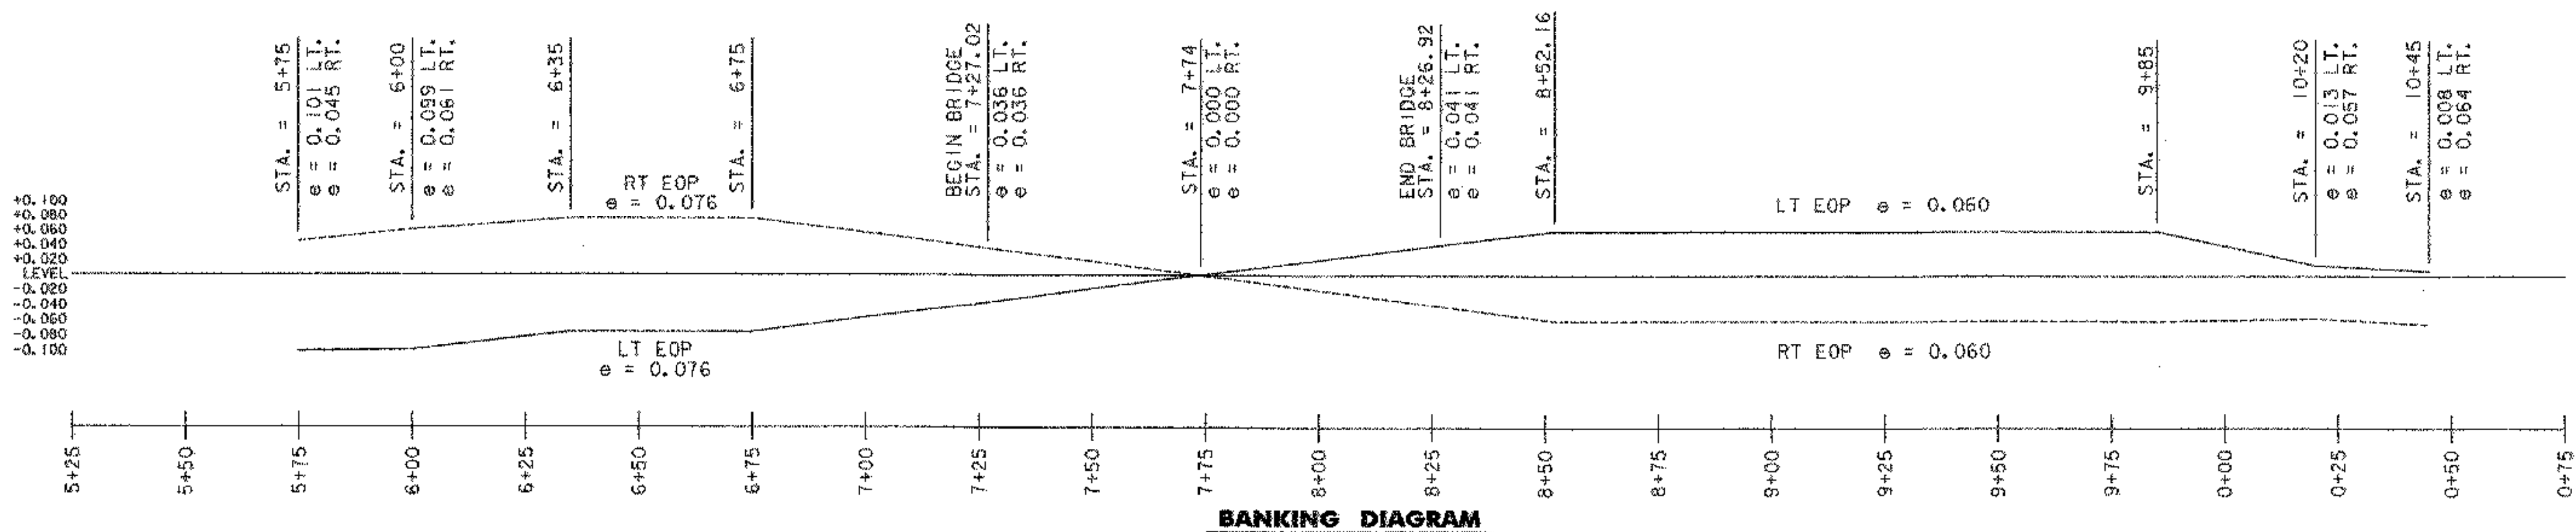

BANKING DIAGRAM

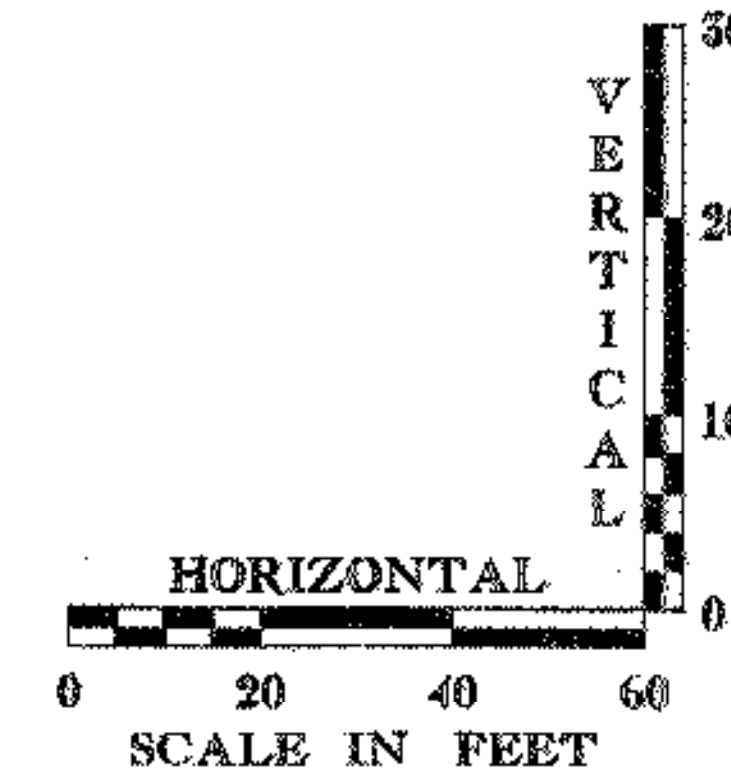

PROJECT NAME: NORWICH
 PROJECT NUMBER: TH2-9625
 FILE NAME: \\Norw-prof.dgn
 PROJECT LEADER: M. CHENETTE
 DESIGNED BY: S. BURBANK
 PROFILE SHEET

PLOT DATE: 03/31/2004
 DRAWN BY: S. BURBANK
 CHECKED BY: M. CHENETTE
 SHEET 8 OF 40