


PLAN LEGEND
 --- LIMITS OF ORDINARY HIGH WATER

PLAN
 SCALE 1" = 10'-0"

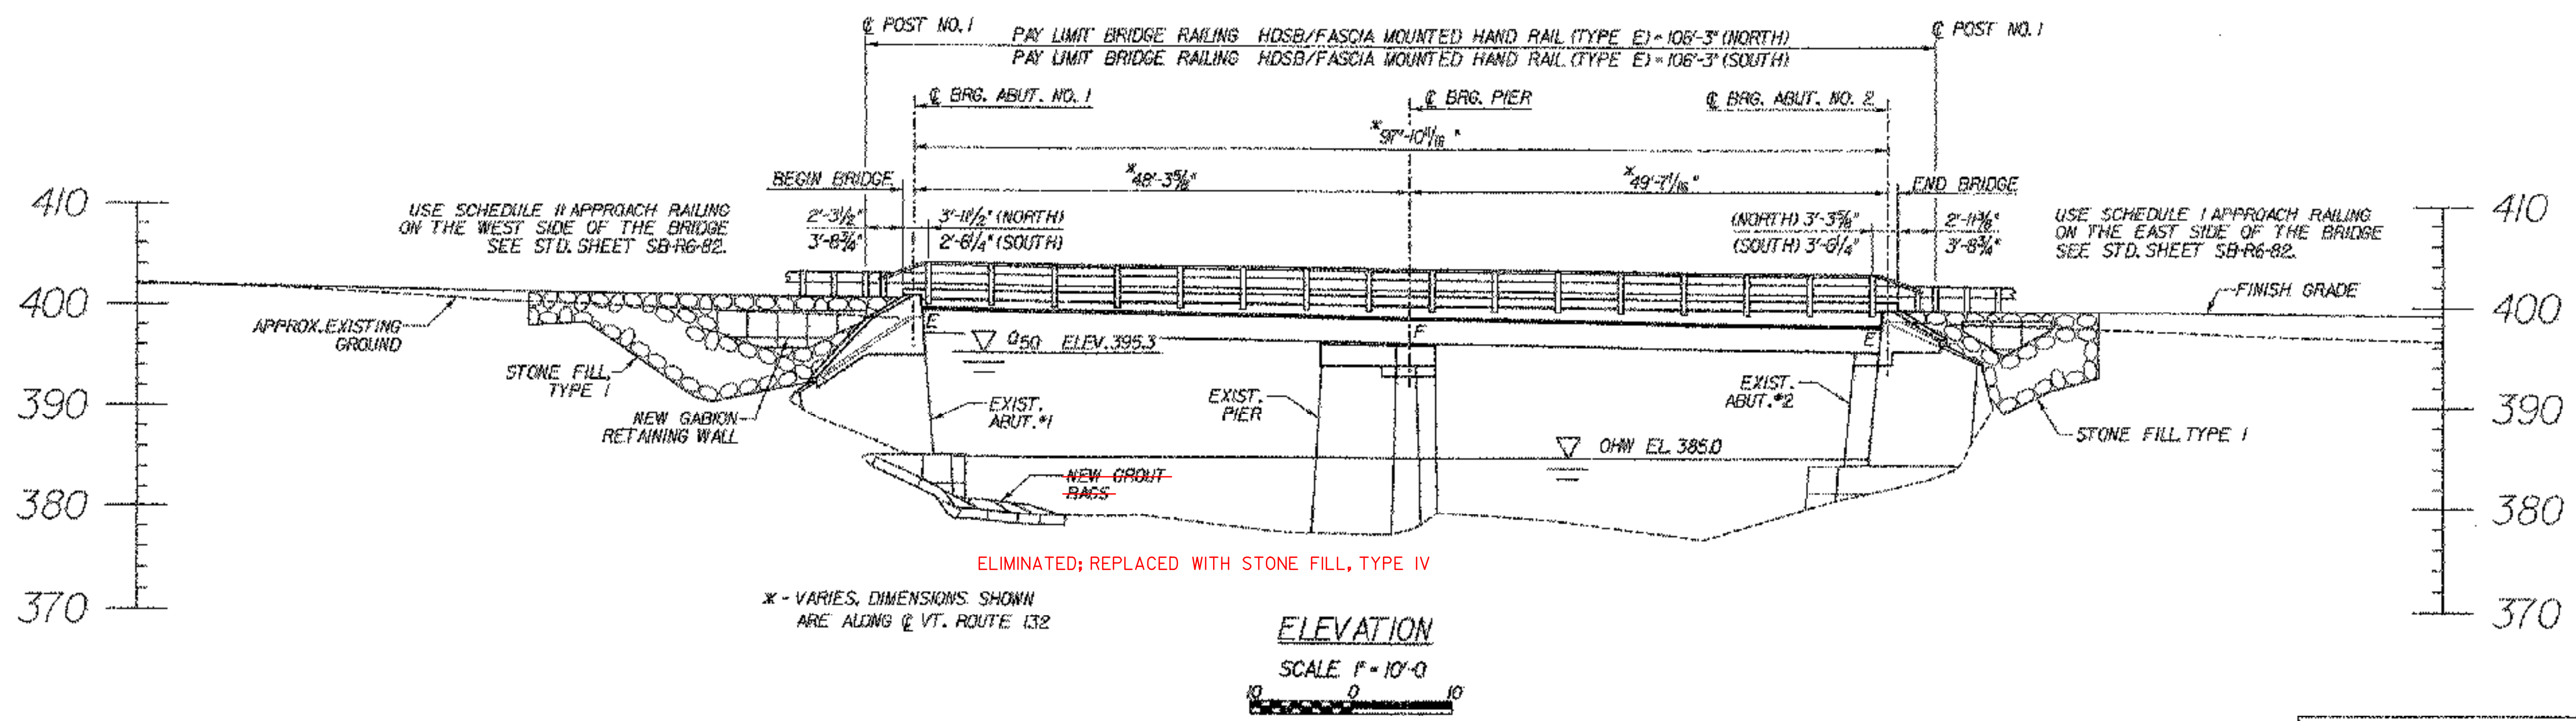

ELEVATION
 SCALE 1" = 10'-0"

STATE OF VERMONT		AGENCY OF TRANSPORTATION	
Town Of	NORWICH	Bridge No.	46
Highway No.	T.H. 3	Log Sta.	
		Surv. Sta.	
TOWN HIGHWAY NO. 3 OVER OMPOMPANOOSUC RIVER			
PLAN AND ELEVATION			
Designed By	S. BURBANK	Drawn By	S. BURBANK
Checked By	M. CHENETTE	Date	12/03
		Bridge Design Supervisor	M. CHENETTE
		Date	12/03
PROJECT	NORWICH	PROJECT NO.	TH2-9625
DH CAD Filename:	...Norw-plan.dgn	Plot Date:	03/31/2004
Bridge Sheet No.		Sheet	15 of 40

