



NOTE: SEE LAYOUT SHEET FOR DIRECTION OF CROSS SECTION

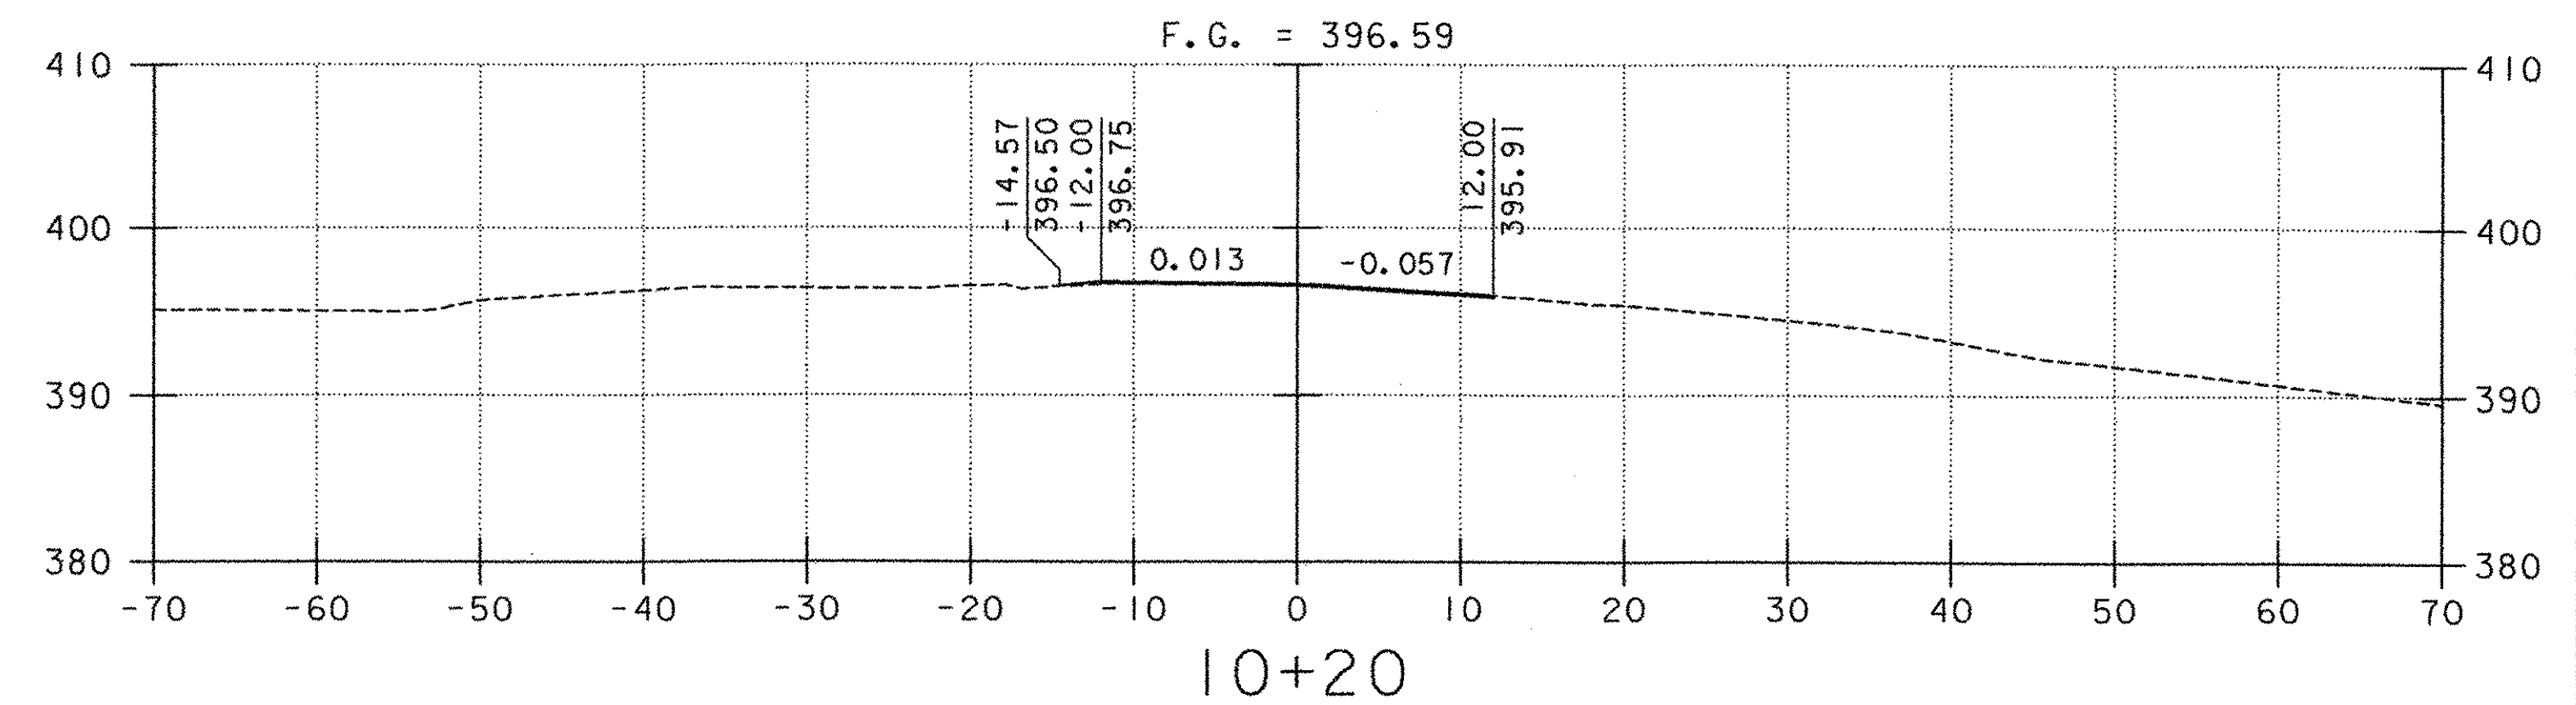

SCALE 1" = 10'-0"

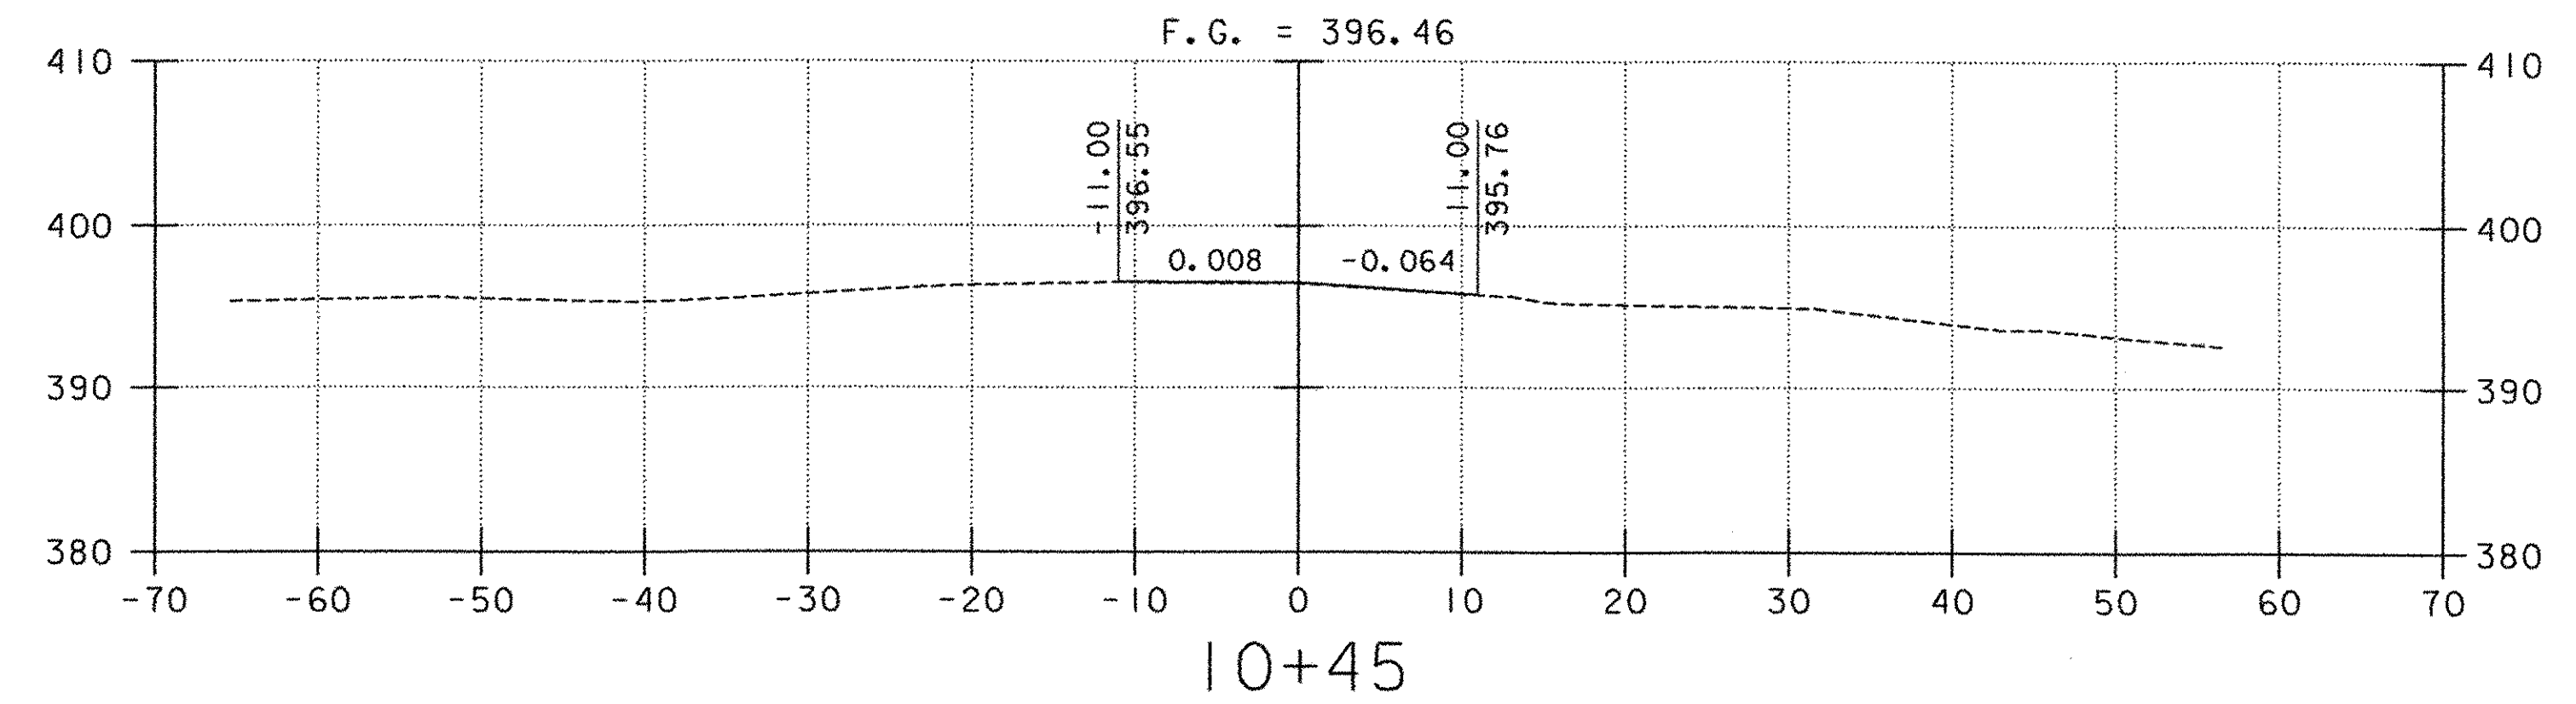

PROJECT NAME: NORWICH
PROJECT NUMBER: TH2-9625

FILE NAME: ...Norw-xs.dgn
PROJECT LEADER: M. CHENETTE
DESIGNED BY: S. BURBANK
ROADWAY CROSS SECTIONS

PLOT DATE: 03/31/2004
DRAWN BY: S. BURBANK
CHECKED BY: M. CHENETTE
SHEET 37 OF 40