



STA. 1+06.00 RT.
BEGIN UNCLASSIFIED CHANNEL EXCAVATION
RIPRAP, HEAVY TYPE (MOD. GROUT BAGS)

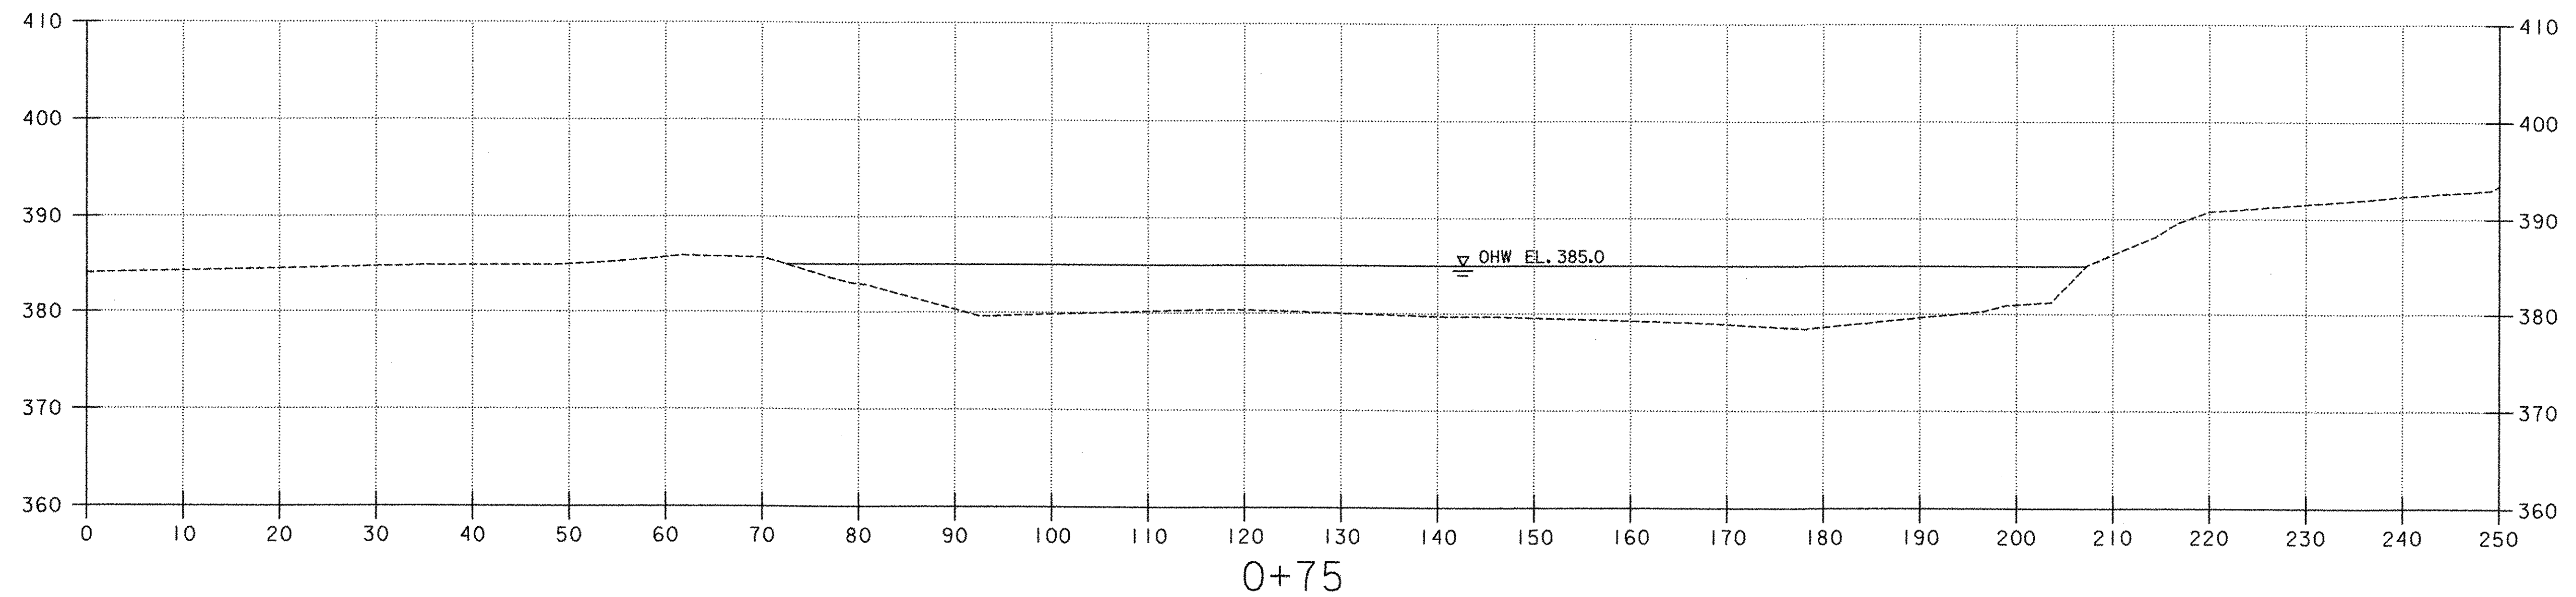

SCALE 1" = 10'-0"
10 0 10

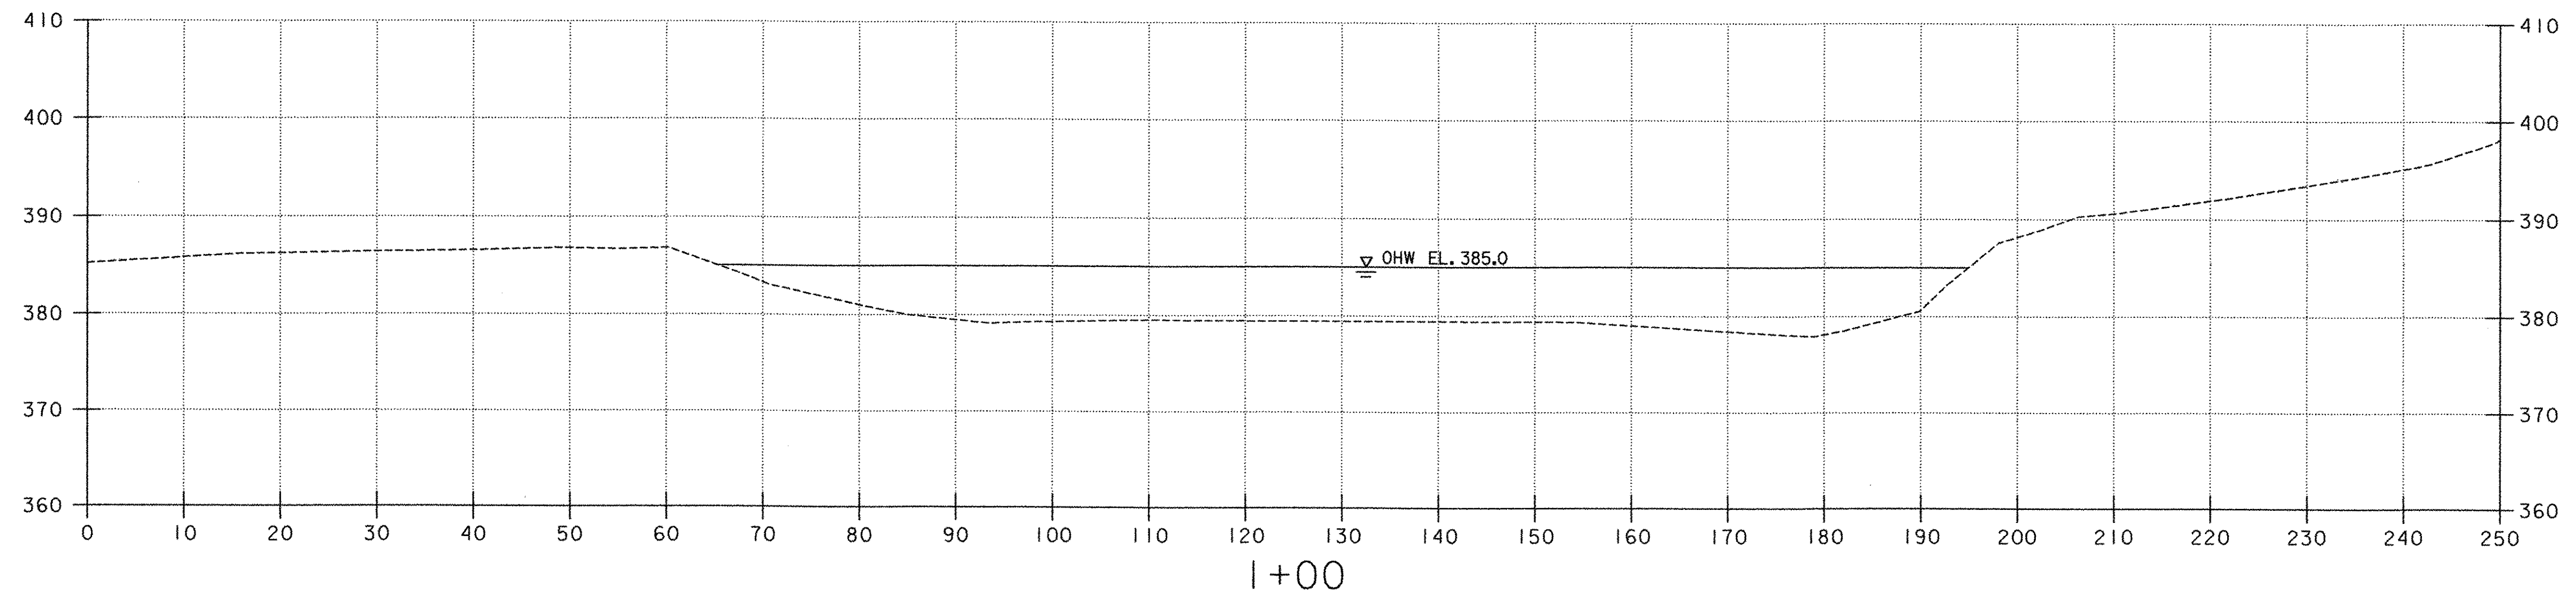

PROJECT NAME: NORWICH
PROJECT NUMBER: TH2-9625

FILE NAME: ...Norw-xs.dgn
PROJECT LEADER: M. CHENETTE
DESIGNED BY: S. BURBANK

CHANNEL CROSS SECTIONS

PLOT DATE: 03/31/2004
DRAWN BY: S. BURBANK
CHECKED BY: M. CHENETTE
SHEET 38 OF 40

\\STCFILES\DESIGN\TH2-9625\03-31-2004 03:28 PM