


HSS 8 X 8 X 1/4

Pl - pb1
ns/fs

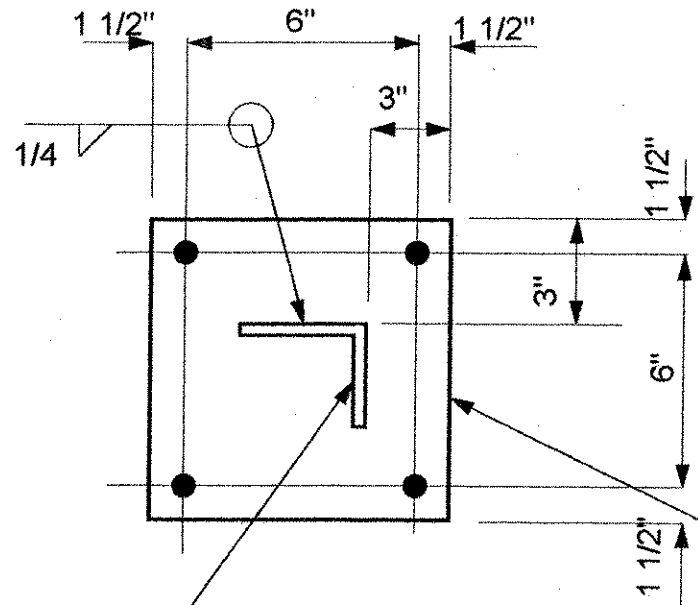

1 - L3 x3 x3/8x1'02" - Ka1 (NS)

PL3/8X9X0'-9"

2 - Brackets - M1B

1' - 2"

8"

SECTION "A"