



PROFILE - TAFTSVILLE COVERED BRIDGE ROAD

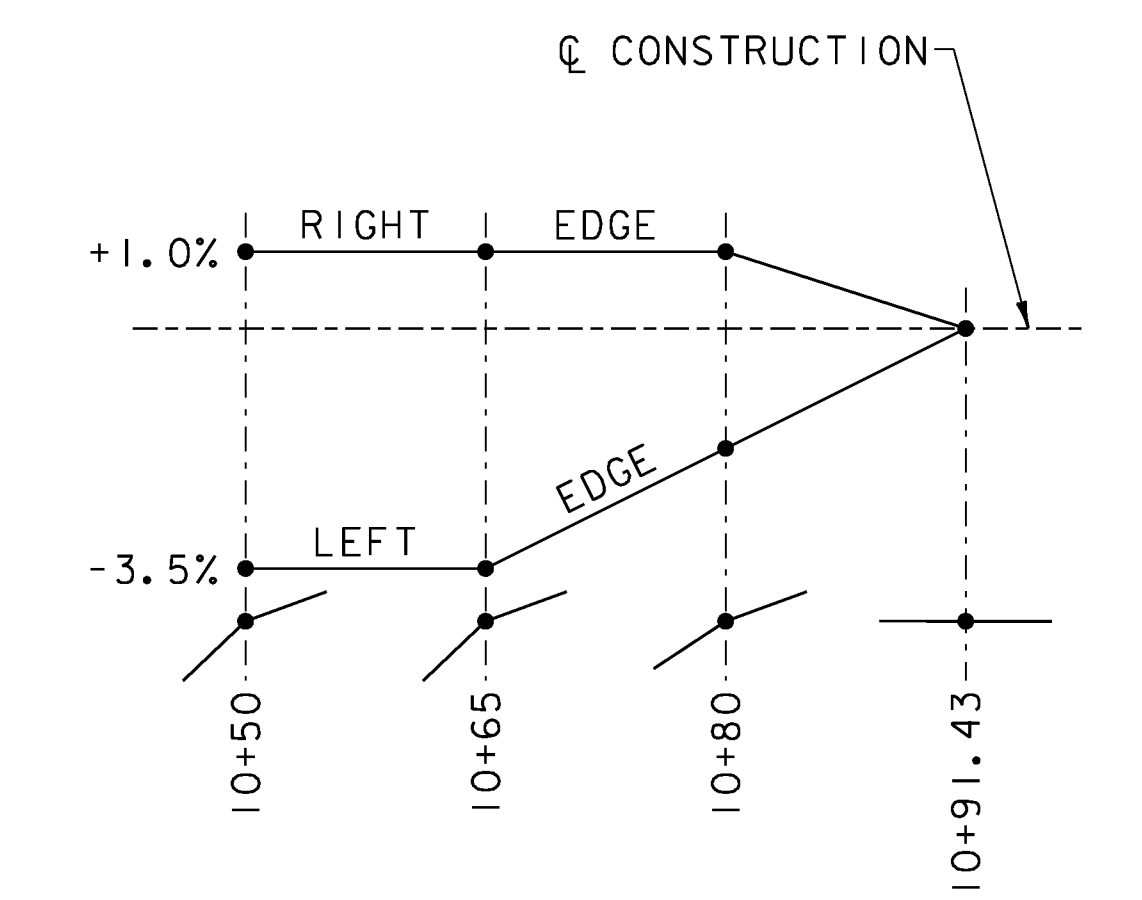

PROPOSED BANKING DIAGRAM
NOT TO SCALE

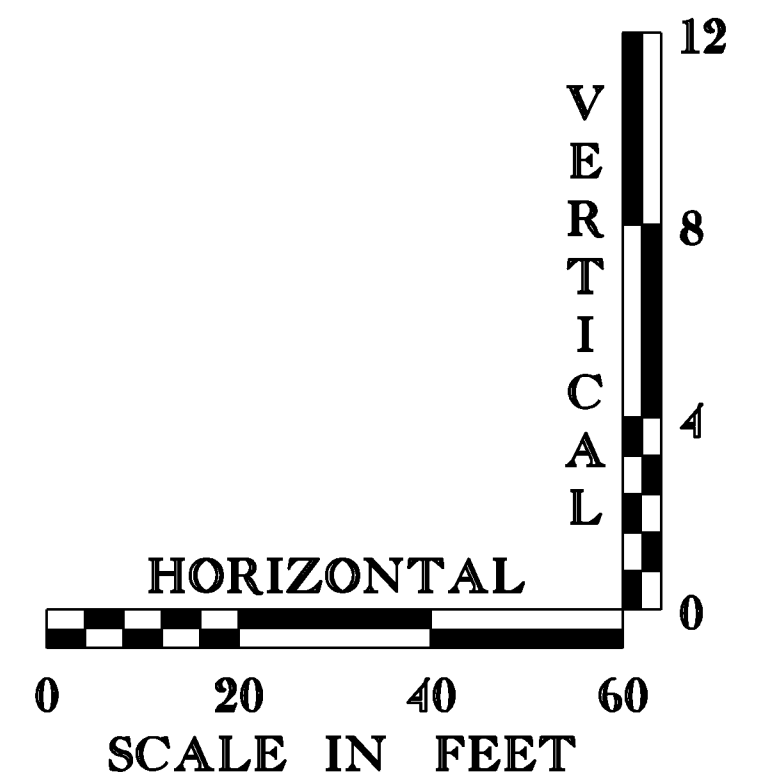

NOTES

1. ELEVATIONS SHOWN TO THE NEAREST TENTH ARE EXISTING GROUND ALONG THE PROPOSED ALIGNMENT PRIOR TO FLOODING. ELEVATIONS SHOWN TO THE NEAREST HUNDREDTH ARE FINISH GRADE ELEVATIONS ALONG THE PROPOSED ALIGNMENT.
2. THE BOLD DASHED LINES REPRESENT THE FINDINGS OF A PARTIAL POST-FLOOD SURVEY OF EXISTING CONDITIONS CONDUCTED IN JANUARY 2012.

PROJECT NAME:	WOODSTOCK	WOODSTOCK	
PROJECT NUMBER:	BHO 1444(52)	ST 1444(58)	
FILE NAME:	z96j262pro.dgn	PLOT DATE:	29-JUN-2012
PROJECT LEADER:	M. Sargent	DRAWN BY:	P. Dustin
DESIGNED BY:	P. Dustin	CHECKED BY:	R. Joy
PROFILE SHEET		SHEET	9 OF 68

