

FINAL CONDITIONS LAYOUT



SCALE: 1" = 20'

LEGEND

- AER E&T — AERIAL ELECTRIC & TELEPHONE
- AER E — AERIAL ELECTRIC
- OHW — ORDINARY HIGH WATER LIMIT
- FLOODPLAIN
- RIPARIAN BUFFER ZONE
- ▨ GRUBBING MATERIAL

NOTE

1. FOR FINAL GRADE INFORMATION, REFER TO ROADWAY CROSS SECTIONS, SHEETS 64 AND 65.

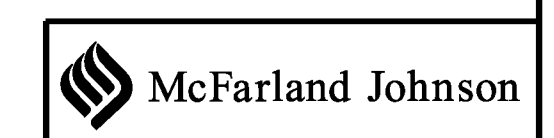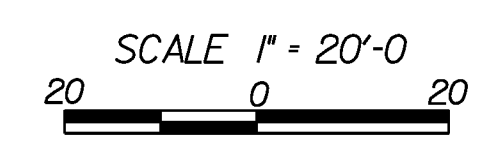

PROJECT NAME:	WOODSTOCK	WOODSTOCK
PROJECT NUMBER:	BHO 1444(52)	ST 1444(58)
FILE NAME:	z96j262fcp.dgn	PLOT DATE: 29-JUN-2012
PROJECT LEADER:	M. Sargent	DRAWN BY: P. Dustin
DESIGNED BY:	W. Durack	CHECKED BY: R. Joy
EPSC FINAL CONDITIONS SITE PLAN		SHEET 14 OF 68