

EXISTING SOUTH TRUSS/ARCH INTERIOR ELEVATION - SPAN 2

(LOOKING SOUTH)
SCALE: 1/4" = 1'-0"

MEMBER REPLACED

EXISTING DISTRIBUTION BEAMS
NOT SHOWN FOR CLARITY.

- ① REPLACE ROOF WITH NEW STANDING SEAM METAL ROOF
- ② ADJUST ROOF PROFILE
- ③ REPLACE ROOF SHEATHING AND RAFTERS (TYP.)
- ④ REPLACE ALL CROSS TIES (TYP.) (SEE SHEET 30)
- ⑤ REPLACE KNEE BRACE WITH TIMBER/TIE ROD KNEE BRACE (TYP.) (SEE SHEET 35)
- ⑥ REPLACE FLOOR SYSTEM WITH NAIL LAMINATED DECK, RUNNING PLANKS AND CURBING (SEE SHEET 33)
- ⑦ REPLACE ALL TRUSS DOUBLE TENSION RODS (TYP.) (SEE SHEET 43)
- ⑧ REPLACE ALL ARCH TENSION RODS (TYP.) (SEE SHEET 43)
- ⑨ REPLACE DESIGNATED TRUSS MEMBER
- ⑩ EXISTING FLOORBEAMS ARE SHOWN. NEW FLOORBEAM LAYOUT INVOLVES RETAINING A PORTION OF THE EXISTING FLOORBEAMS AND INCORPORATING NEW FLOORBEAMS. SEE SHEET 29 FOR FLOOR FRAMING PLAN
- ⑪ REPLACE ABOVE DECK ARCH BLOCKS (SEE SHEET 44)
- ⑫ REMOVE INSIDE PLANK ONLY

- ⑬ REPLACE BOLSTER BEAM AND BLOCKING (SEE SHEET 46)
- ⑭ REPLACE PIER CRIBBING SYSTEM WITH CONCRETE SEAT AND PEDESTALS (SEE SHEET 54)
- ⑮ REPLACE LOWER CHORD BLOCKING (SEE SHEET 41)
- ⑯ REPLACE ARCH BRACING (TYP.) (SEE SHEET 44)
- ⑰ REPLACE ARCH/FLOORBEAM CONNECTION ANGLES (TYP.) (SEE SHEET 43)
- ⑱ ADD NEW ARCH CONNECTION (SEE SHEET 45)
- ⑲ REPAIR MASONRY ABUTMENT (SEE SHEET 53)
- ⑳ REPAIR MASONRY PIER (SEE SHEETS 54 & 55)
- ㉑ ELIMINATE SAG IN SPAN 2 (SEE SUPERSTRUCTURE NOTE 11 ON SHEET 23)
- ㉒ STRENGTHEN LOWER CHORD (SEE SHEETS 37 & 38)
- ㉓ REPLACE LOWER CHORD TENSION SPLICE (SEE SHEET 39)
- ㉔ REPLACE END PORTAL FRAMING (SEE SHEET 32)
- ㉕ ADD UPPER CHORD EXTENSION (SEE SHEET 30)

TRUSS JOINTS


- ⓐ SEE SHEET 40
- ⓑ SEE SHEET 40
- ⓒ SEE SHEET 40
- ⓓ SEE SHEET 40
- ⓔ SEE SHEET 40
- ⓕ SEE SHEET 41
- ⓖ SEE SHEET 41
- ⓗ SEE SHEET 41
- ⓘ SEE SHEET 41
- ⓙ SEE SHEET 41
- ⓚ SEE SHEET 41

LEGEND

- A EXISTING FLOORBEAM SET AT EXISTING LOCATION
- B EXISTING FLOORBEAM TO BE SLIGHTLY SHIFTED FROM ITS EXISTING LOCATION
- C NEW FLOORBEAM SET AT EXISTING LOCATION
- TRUSS MEMBERS TO BE REPLACED
- PI2S TRUSS POST DESIGNATION
- J1 TRUSS JOINT DETAIL DESIGNATION

NOTES

1. FOR FLOORBEAM REFERENCE TABLE, SEE SHEET 56.

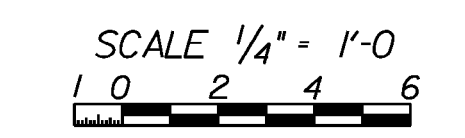

PROJECT NAME:	WOODSTOCK	WOODSTOCK
PROJECT NUMBER:	BHO 1444(52)	ST 1444(58)
FILE NAME:	z96j262tr2.dgn	PLOT DATE: 29-JUN-2012
PROJECT LEADER:	M. Sargent	DRAWN BY: P. Dustin
DESIGNED BY:	P. Dustin	CHECKED BY: R. Joy
TRUSS/ARCH ELEVATION (3 OF 4)		SHEET 27 OF 68