


FLOOR FRAMING PLAN - SPAN 1

SCALE: 1/4" = 1'-0"

MEMBER REPLACED

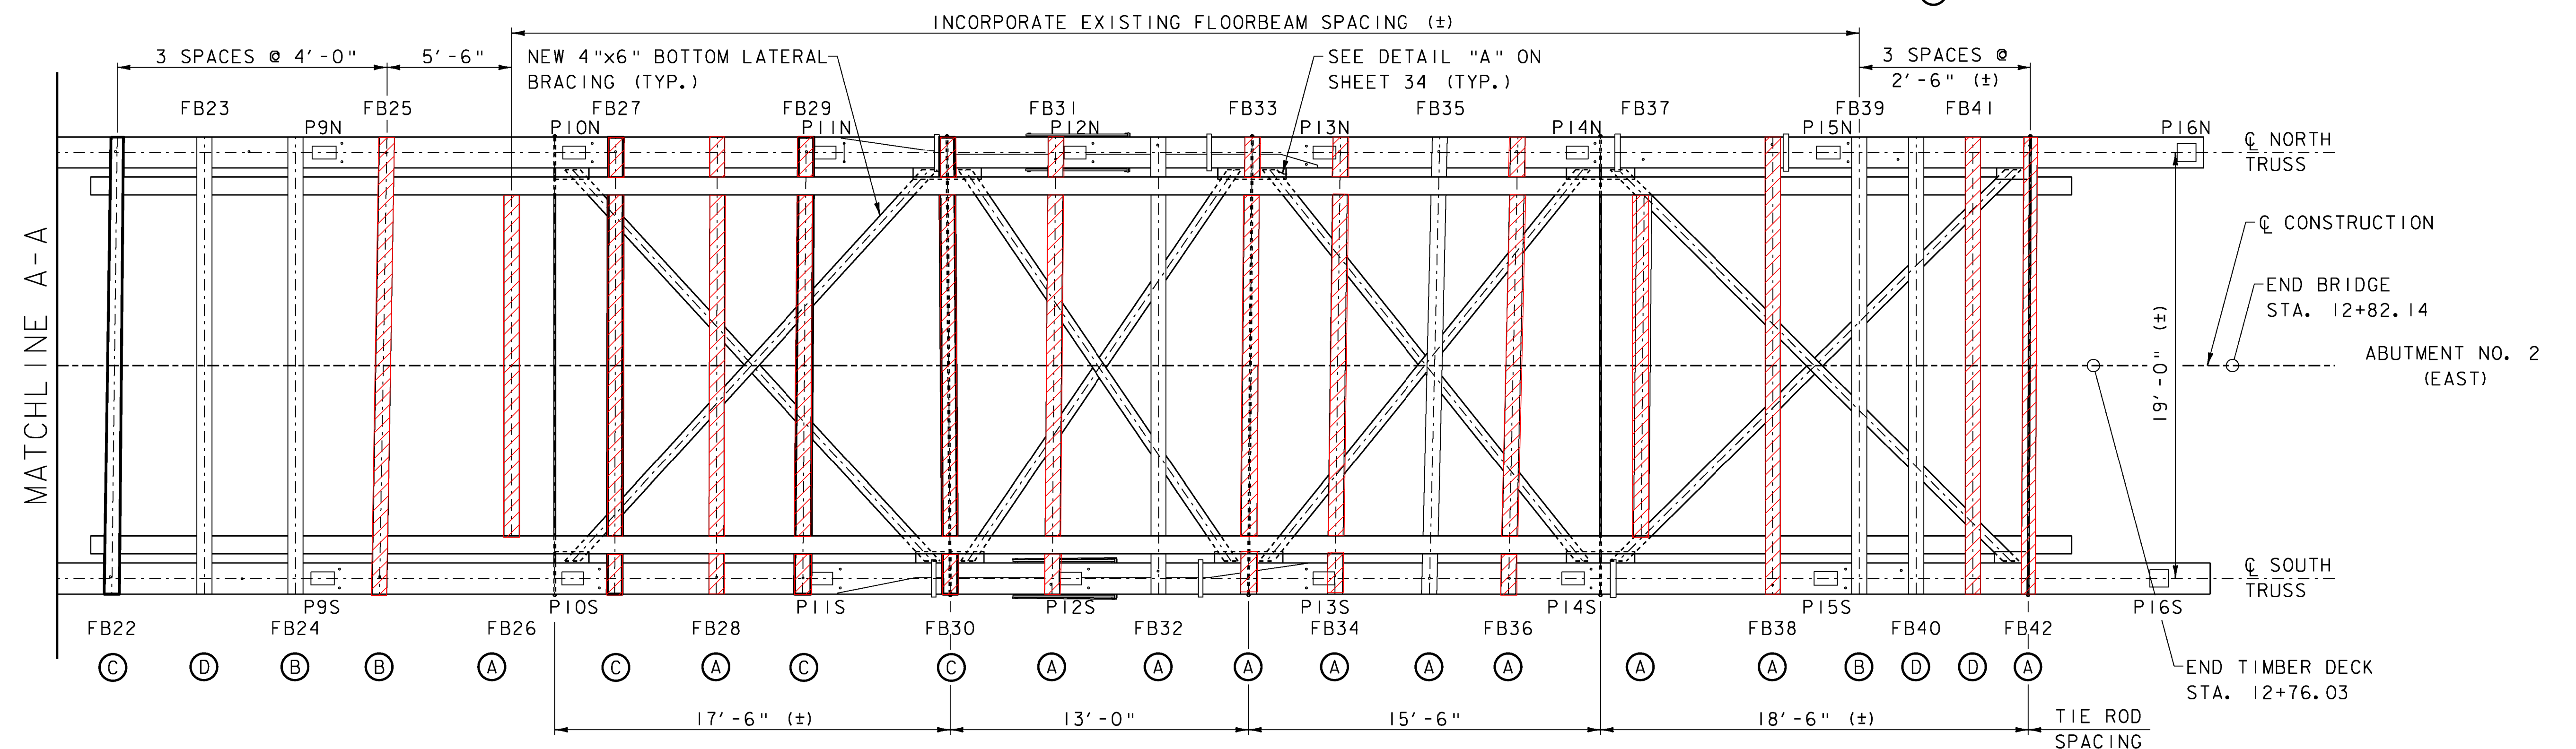

FLOOR FRAMING PLAN - SPAN 2

SCALE: 1/4" = 1'-0"

SCALE 1/4" = 1'-0"
1 0 2 4 6

LEGEND

FB FLOORBEAM
P POST

NOTES

- LAG LATERAL BRACING FROM UNDERNEATH TO FLOORBEAMS AT FB5, FB6, FB9, FB11, FB12, FB14, FB15, FB28, FB29, FB31, FB32, FB34, FB36, FB38 AND FB40 AT BRACING/FLOORBEAM CROSSINGS (2 PER FLOORBEAM) WITH 3/4" DIA. HEX HEADED LAG SCREWS. SEE DETAIL "C" ON SHEET 34.
- FOR FLOORBEAM REFERENCE TABLE, SEE SHEET 56.

- (A) EXISTING FLOORBEAM SET AT EXISTING LOCATION
- (B) EXISTING FLOORBEAM TO BE SLIGHTLY SHIFTED FROM ITS EXISTING LOCATION
- (C) NEW FLOORBEAM SET AT EXISTING LOCATION
- (D) EXISTING FLOORBEAM TO BE SET AT NEW LOCATION (FROM SPAN 1 STOCKPILE OR SPAN 2 REMOVAL)
- (E) NEW FLOORBEAM SET AT NEW LOCATION



PROJECT NAME:	WOODSTOCK	WOODSTOCK
PROJECT NUMBER:	BHO 1442(52)	ST 1444(58)
FILE NAME:	z96j262ffp.dgn	PLOT DATE: 10-JUL-2012
PROJECT LEADER:	M. Sargent	DRAWN BY: P. Dustin
DESIGNED BY:	P. Dustin	CHECKED BY: R. Joy
FLOOR FRAMING PLAN		SHEET 29 OF 68