



CEILING FRAMING PLAN - SPAN 1

SCALE: 1/4" = 1'-0"

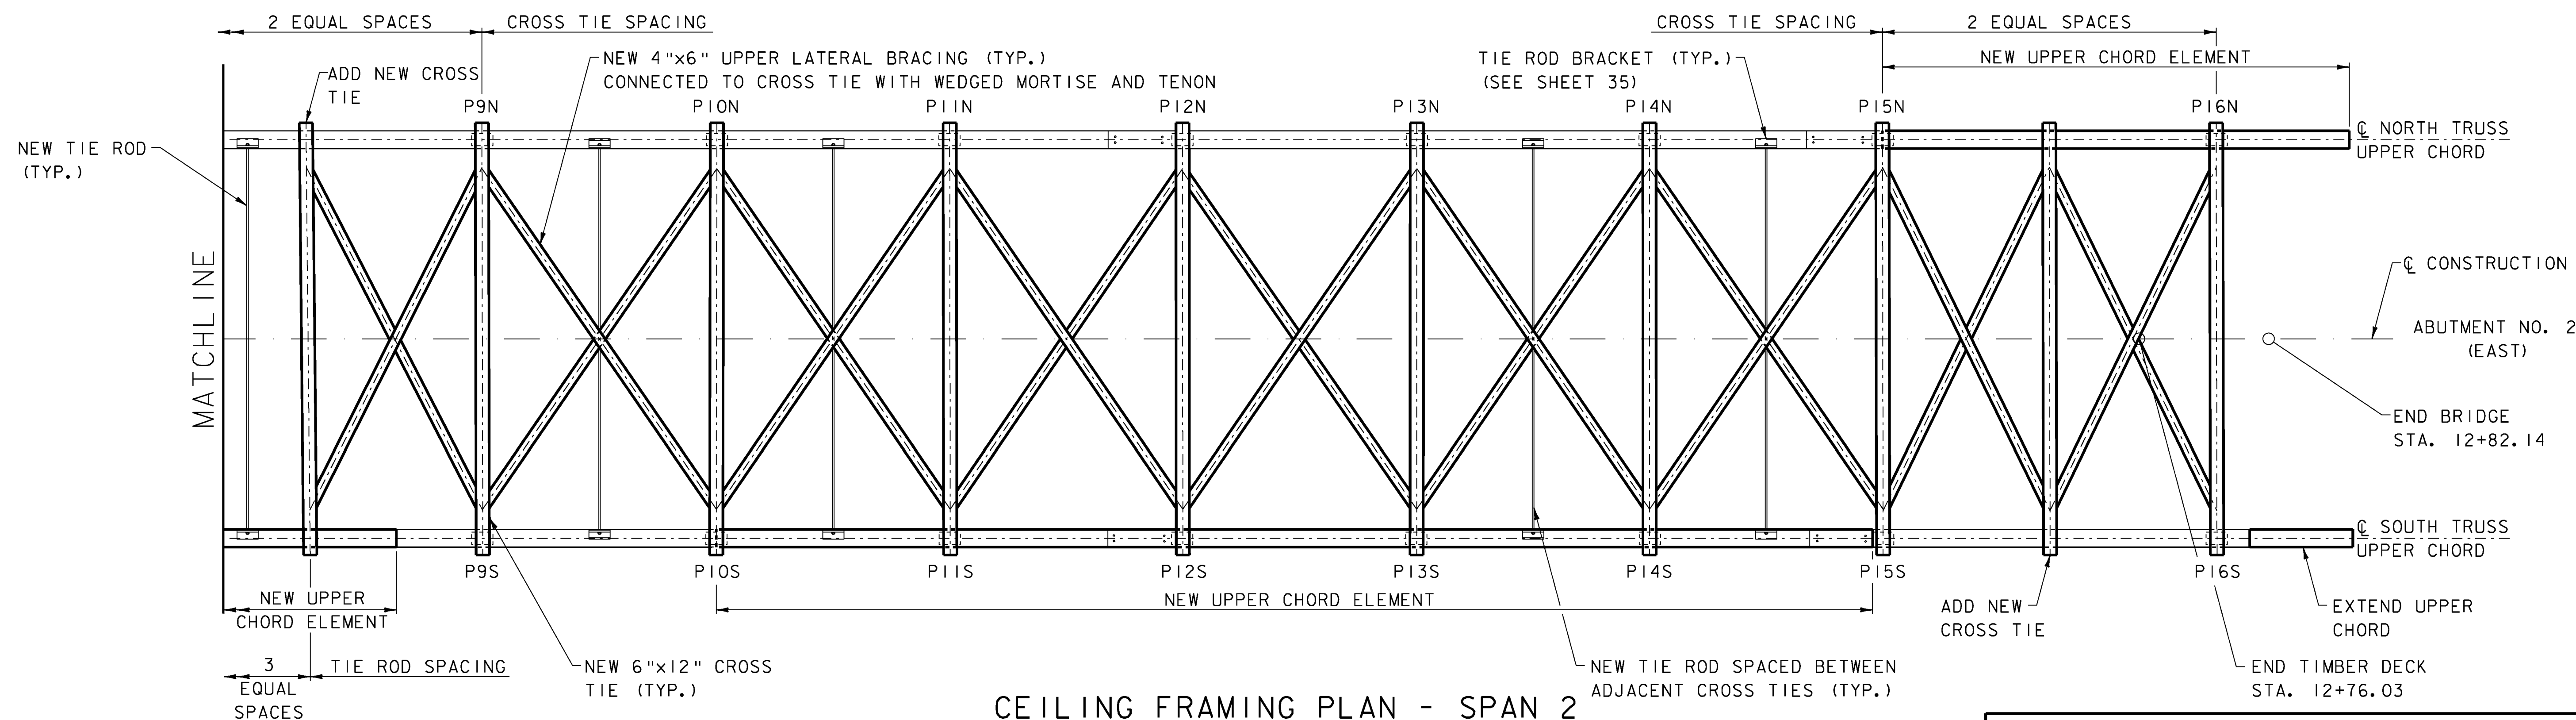

CEILING FRAMING PLAN - SPAN 2

SCALE: 1/4" = 1'-0"

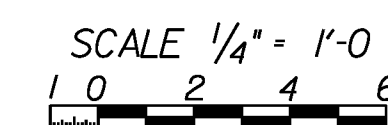

PROJECT NAME:	WOODSTOCK	WOODSTOCK
PROJECT NUMBER:	BHO 1442(52)	ST 1444(58)
FILE NAME:	z96j262cfp.dgn	
PROJECT LEADER:	M. Sargent	DRAWN BY: P. Dustin
DESIGNED BY:	D. Kull	CHECKED BY: R. Joy
CEILING FRAMING PLAN		PLOT DATE: 10-JUL-2012
		SHEET 30 OF 68