
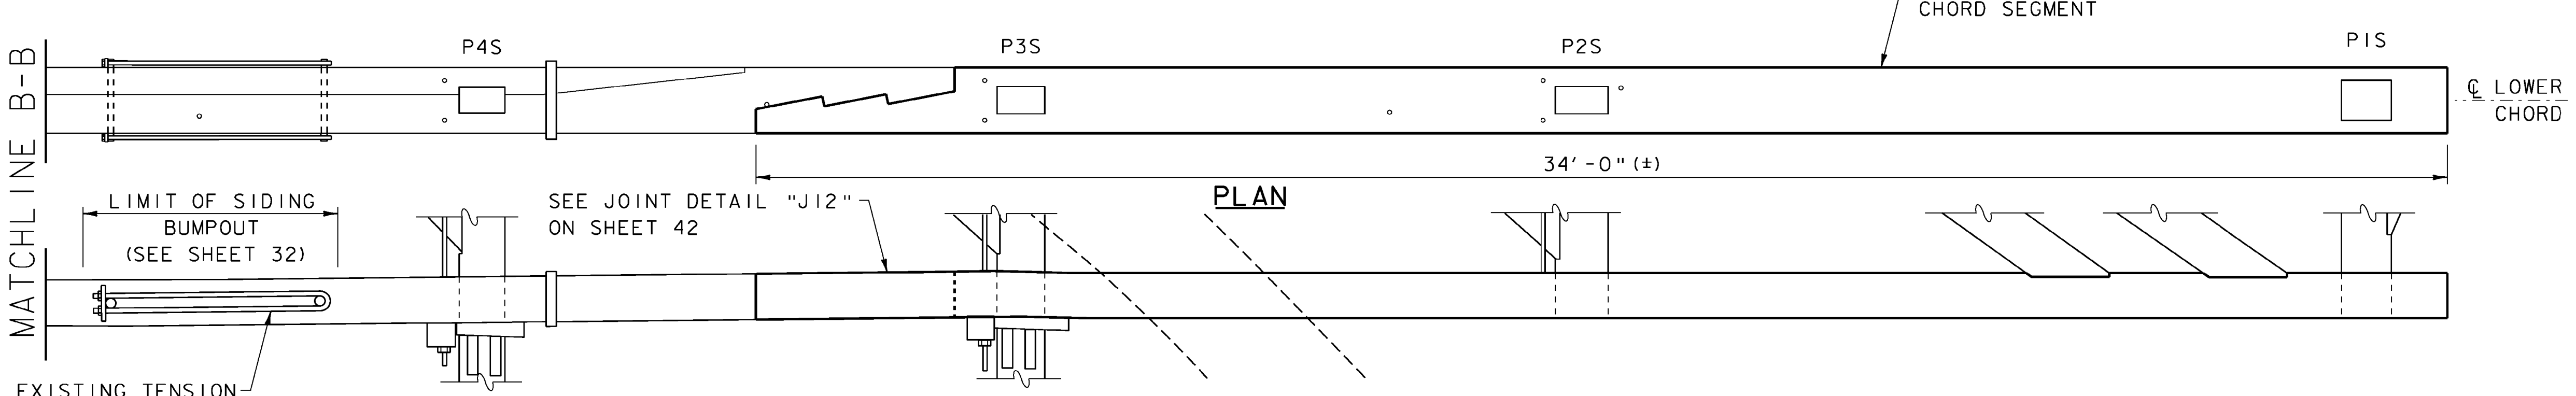
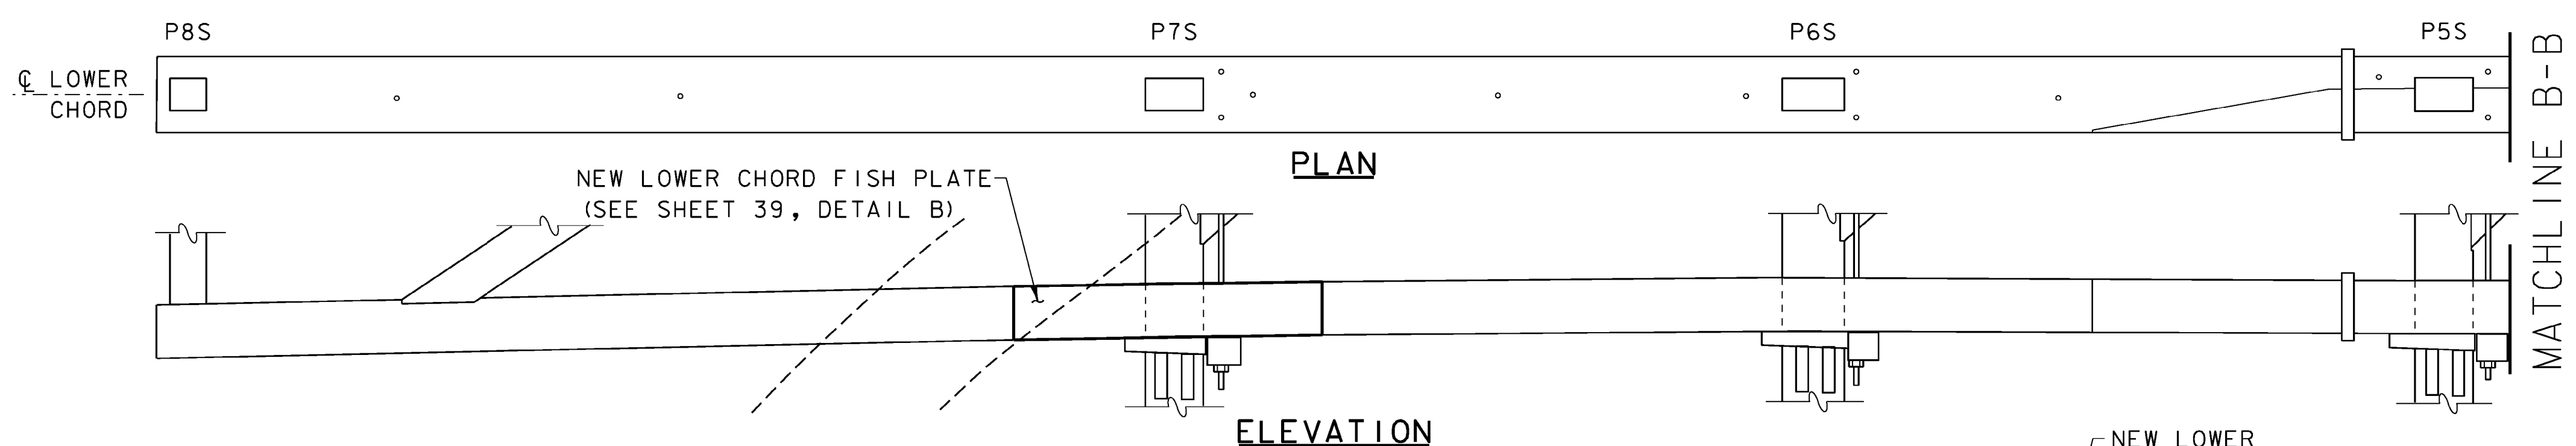


SPAN I - LOWER CHORD (NORTH)


(LOOKING NORTH)
SCALE: 1/2" = 1'-0"

FISH PLATES ADDED TO BOTTOM
CHORDS AT ALL POST LOCATIONS

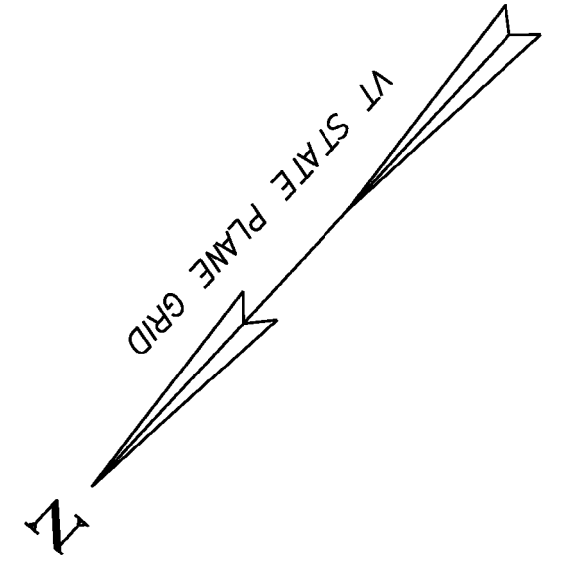

SPAN I - LOWER CHORD (SOUTH)

(LOOKING SOUTH)
SCALE: 1/2" = 1'-0"

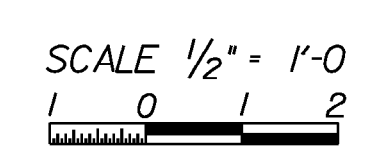

PROJECT NAME:	WOODSTOCK	WOODSTOCK
PROJECT NUMBER:	BHO 1444(52)	ST 1444(58)
FILE NAME:	z96j262d05.dgn	
PROJECT LEADER:	M. Sargent	
DESIGNED BY:	J. Hall	
BRIDGE DETAILS (5 OF 11)	PLOT DATE:	29-JUN-2012
	DRAWN BY:	P. Dustin
	CHECKED BY:	R. Joy
	SHEET	37 OF 68