


SPAN I - LOWER CHORD (NORTH)

(LOOKING NORTH)
SCALE: 1/2" = 1'-0"

PLATE ID	"A"	"B"	"C"	"D"	"E"	"F"	"G"	"H"	"I"	"J"
FP01	6	6	6	--	--	6	6	6	--	--
FP02	6	6	6	6	6	6	6	6	6	6
FP03	9	11	11	8	--	6	6	6	6	6
FP04	6	6	6	--	--	6	--	--	--	--
FP05	6	6	6	--	--	6	6	--	--	--
FP06	16	14	--	--	--	6	6	6	6	6

PLATE ID	EST. L (±)	NUMBER OF PLATES		
		SPAN 1	SPAN 2	TOTAL
FP01	5'-3"	8	14	22
FP02	7'-3"	6	6	12
FP03	8'-0"	--	2	2
FP04	4'-3"	4	--	4
FP05	4'-9"	2	--	2
FP06	7'-3"	2	--	2

FISH PLATE TABLES
N. T. S.

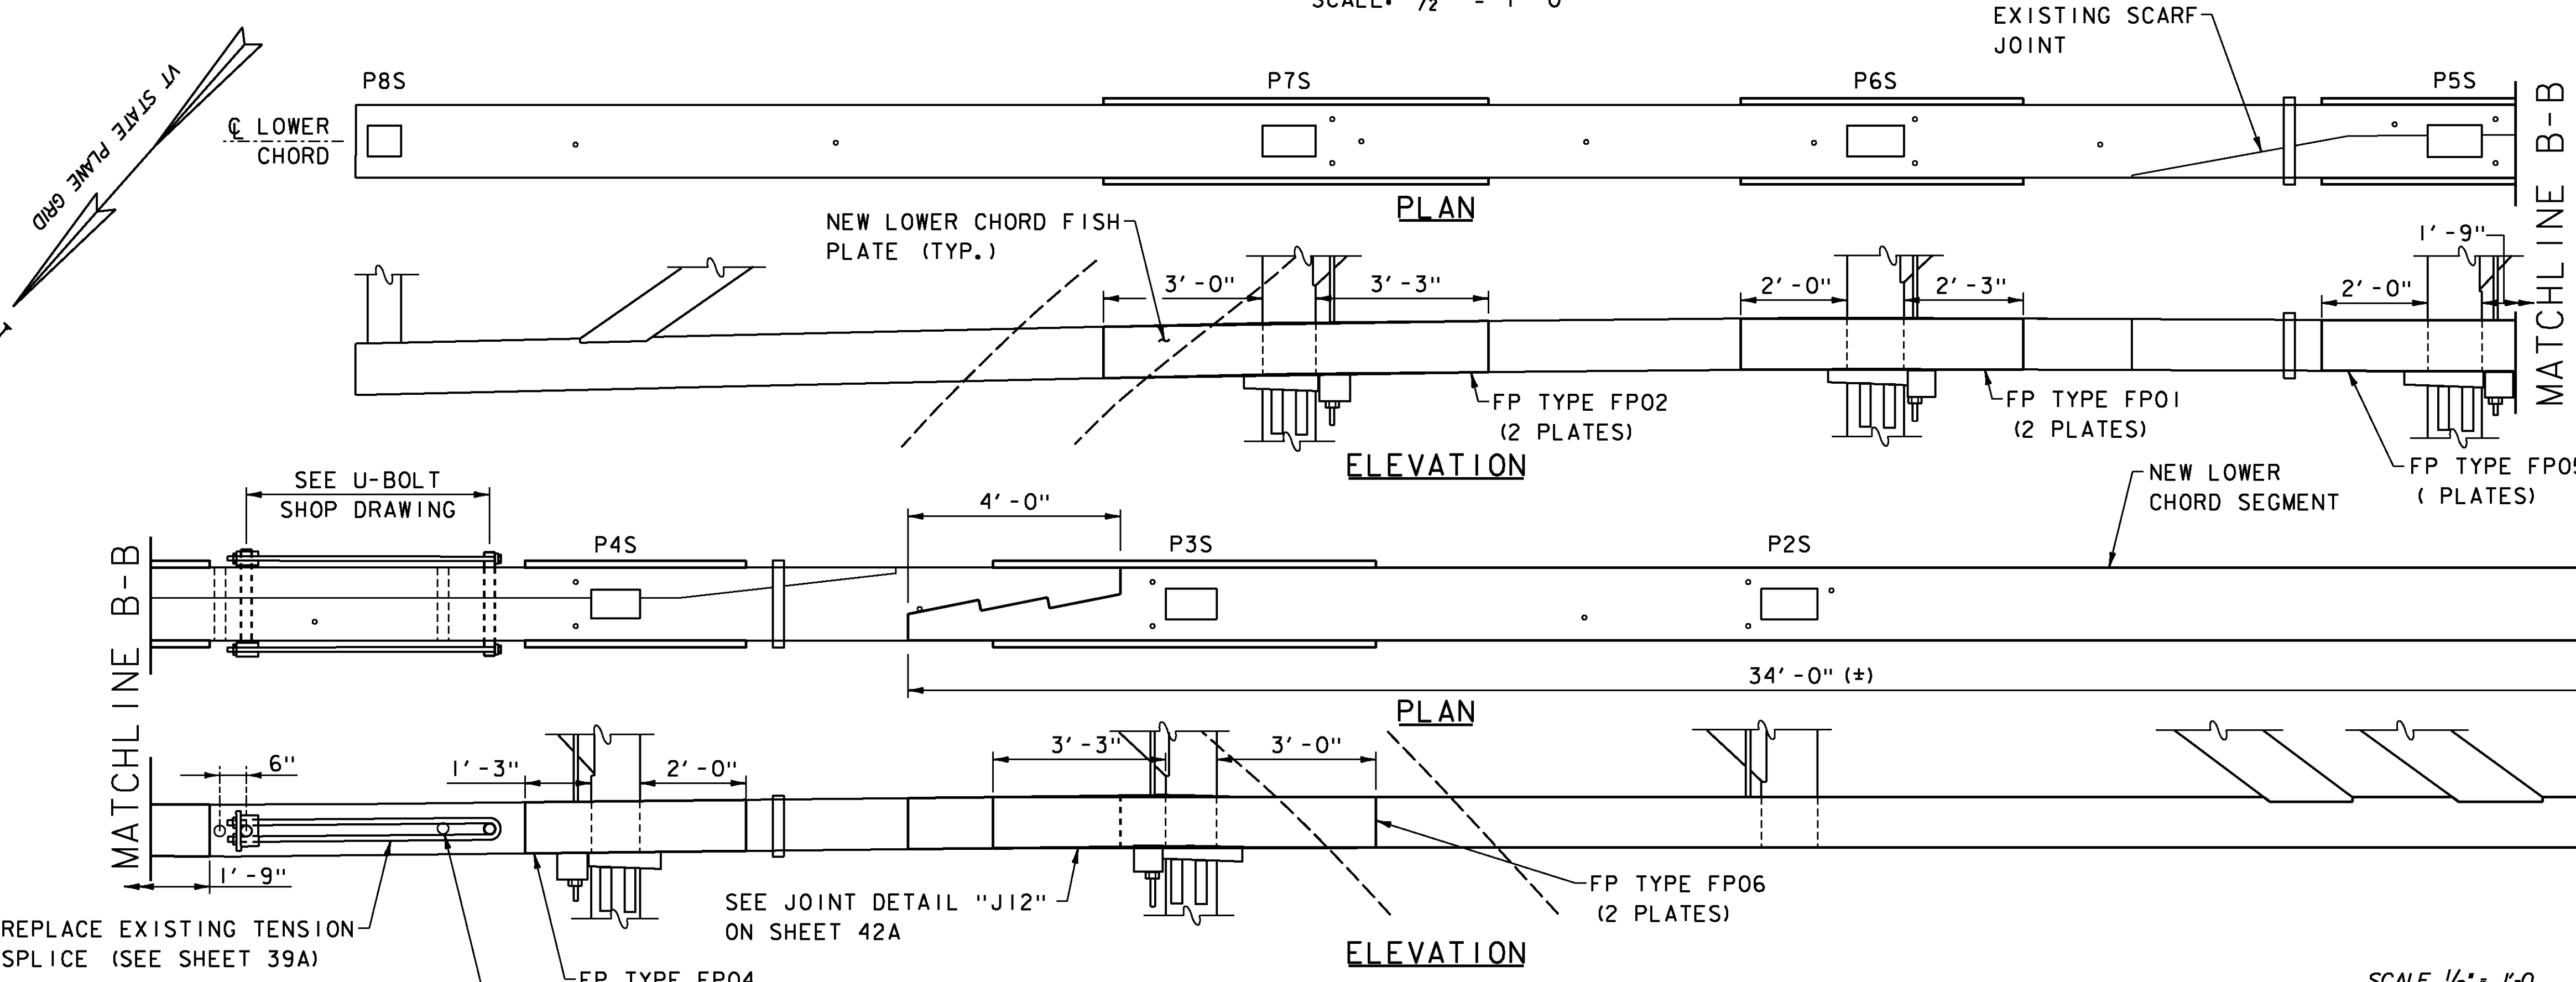

SPAN I - LOWER CHORD (SOUTH)

(LOOKING SOUTH)
SCALE: 1/2" = 1'-0"

SCALE 1/2" = 1'-0"

1/7/2013 UPDATE LIMITS OF REPAIR

PROJECT NAME:	WOODSTOCK	WOODSTOCK
PROJECT NUMBER:	BHO 1444(52)	ST 1444(58)
FILE NAME:	z96j262d05.dgn	PLOT DATE: \$\$\$DATE\$\$\$
PROJECT LEADER:	M. Sargent	DRAWN BY: P. Dustin
DESIGNED BY:	J. Hall / S. Delta	CHECKED BY: R. Joy
BRIDGE DETAILS (5 OF 11)		SHEET 37A OF 68

