


NOTES

- ELEVATIONS TO BE DETERMINED IN THE FIELD.
- FOR CONSTRUCTION NOTES, SEE SHEETS 23 AND 24.

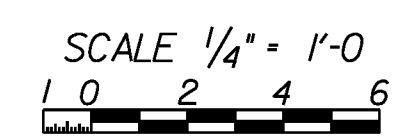

PROJECT NAME: WOODSTOCK	WOODSTOCK
PROJECT NUMBER: BHO 1444(52)	ST 1444(58)
FILE NAME: z96J262abl.dgn	PLOT DATE: 29-JUN-2012
PROJECT LEADER: M. Sargent	DRAWN BY: P. Dustin
DESIGNED BY: S. Della/J. Lund	CHECKED BY: R. Joy
PROPOSED ABUTMENT NO. 1	SHEET 48 OF 68

* LIMITS OF REBUILT STONE MASONRY NOT SHOWN IN ELEVATION FOR CLARITY