


NOTE:

1. Δ is the central angle which subtends a 5'-0" chord.
2. R is measured from the center of the circle to the back surface of the rough sawn timber rail.

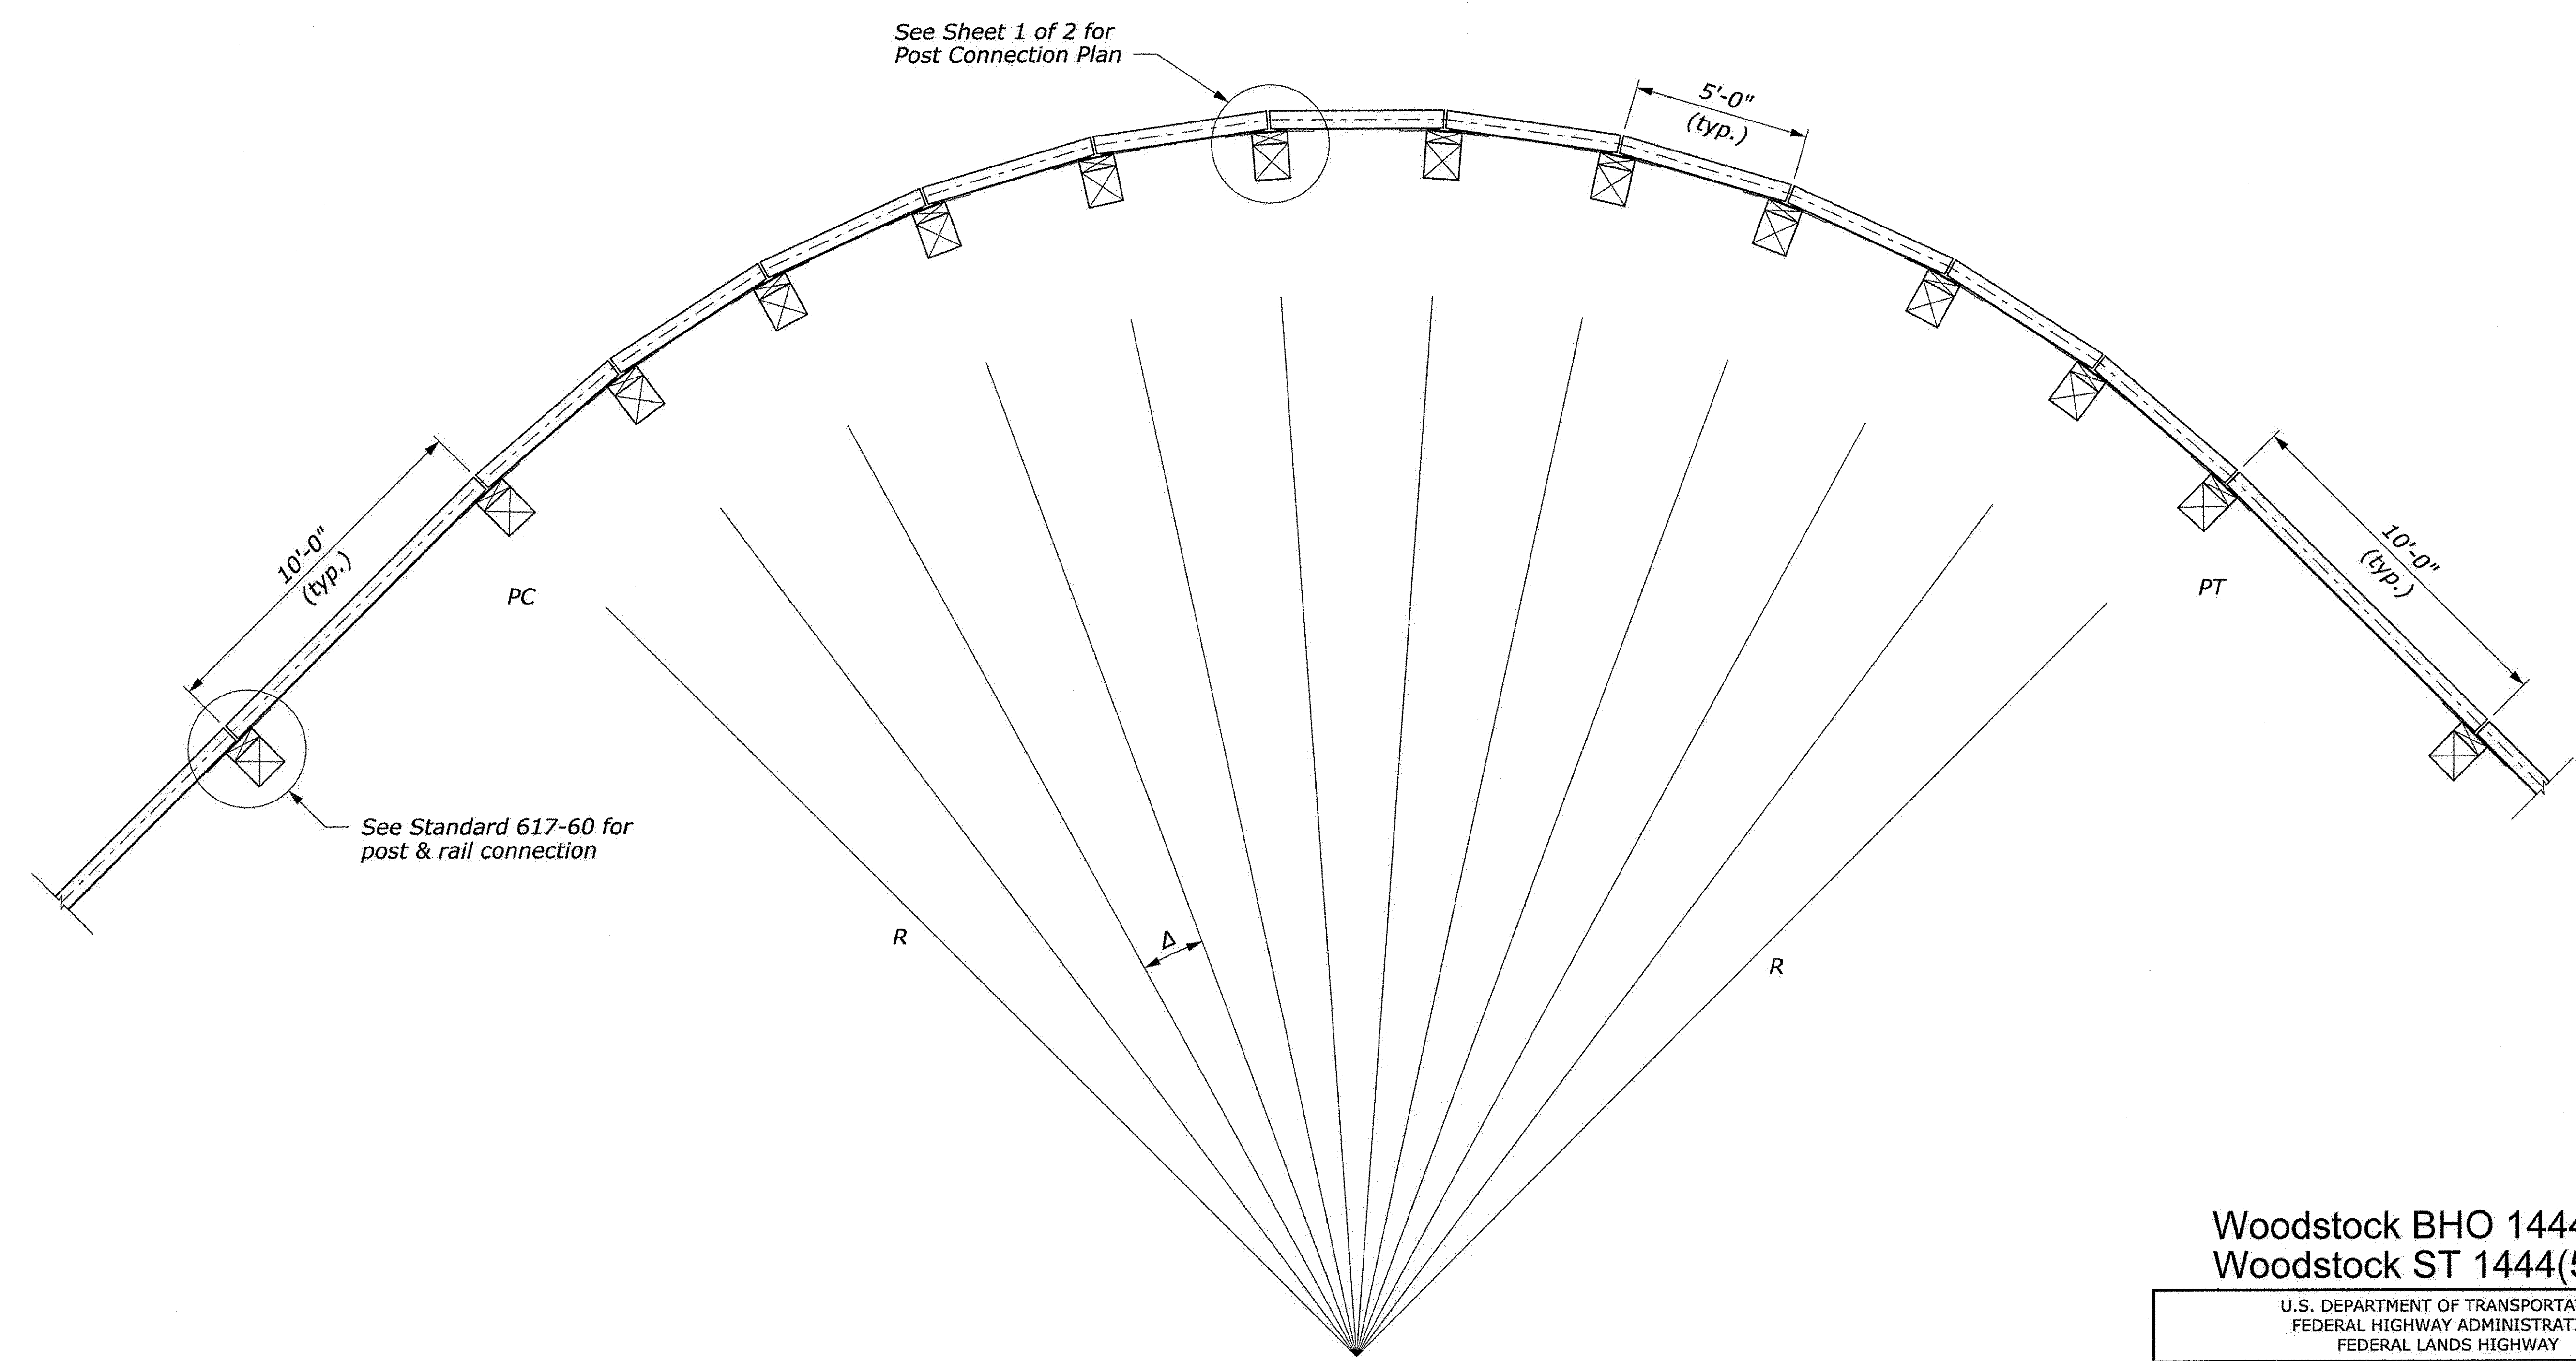

PLAN VIEW LAYOUT

Woodstock BHO 1444(52)
Woodstock ST 1444(58)

U.S. DEPARTMENT OF TRANSPORTATION FEDERAL HIGHWAY ADMINISTRATION FEDERAL LANDS HIGHWAY	
U.S. CUSTOMARY STANDARD	
STEEL-BACKED TIMBER GUARDRAIL AROUND CIRCULAR CURVES 70 FOOT RADIUS AND BELOW	
Sheet 2 of 2	
STANDARD APPROVED FOR USE 6/2005	STANDARD
REVISED:	617-63