

STATE OF VERMONT AGENCY OF TRANSPORTATION



PROPOSED IMPROVEMENT BRIDGE PROJECT


TOWN OF LINCOLN
COUNTY OF ADDISON

ROUTE NO : T.H. 9 CL 3 (LOCAL ROAD) BRIDGE NO : 48

PROJECT LOCATION : BEGINNING FROM A POINT ON T.H. 9 APPROXIMATELY 0.066 KM FROM THE INTERSECTION OF T.H. 1 AND T.H. 9 PROCEEDING NORTHERLY APPROXIMATELY 0.066 KM ALONG T.H. 9.


PROJECT DESCRIPTION : BRIDGE REPLACEMENT WITH ROADWAY APPROACH AND CHANNEL WORK.

LENGTH OF STRUCTURE : 26.663 METERS.
LENGTH OF ROADWAY : 39.537 METERS.
LENGTH OF PROJECT : 66.200 METERS.

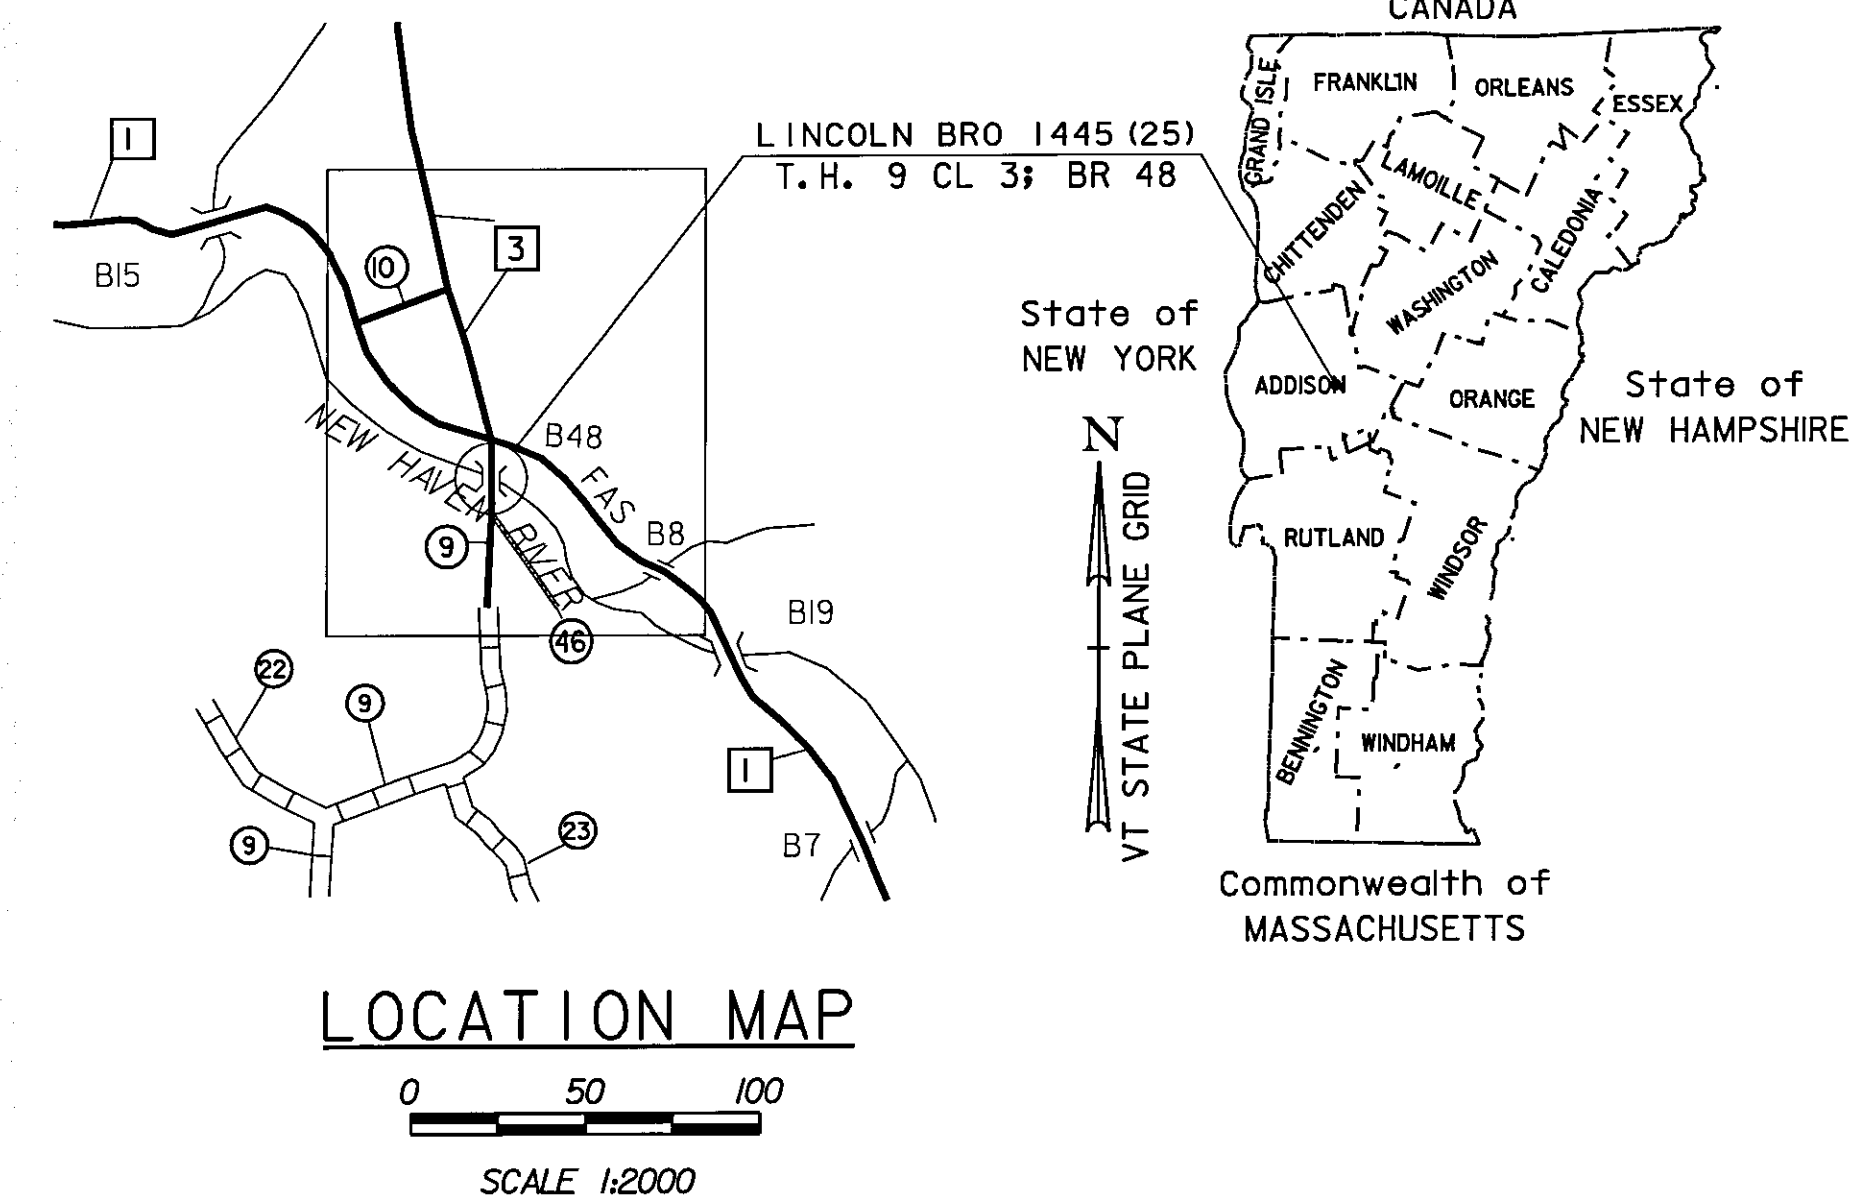

SEE SHEET 2 FOR INDEX OF SHEETS

RECORD PLANS	
CONTRACTOR:	PARENT CONSTRUCTION INC.- HINESBURG, VT
RESIDENT ENGINEER:	JOE KNIPES
CONSTRUCTION BEGAN:	MAY 4, 2009
CONSTRUCTION COMPLETE:	NOVEMBER 13, 2009
RECORD PLANS BY:	JOE KNIPES & NICK GARBACIK
I HEREBY CERTIFY THAT ALL THE CONSTRUCTION REQUIRED BY THIS SET OF DRAWINGS HAS BEEN ACCOMPLISHED AS INDICATED HEREIN.	
BY:	RESIDENT ENGINEER
DATE:	6-12-11
NOTE: Any further information concerning final quantities, amounts or other details relative to this project may be found at Central Files in the electronic archives.	

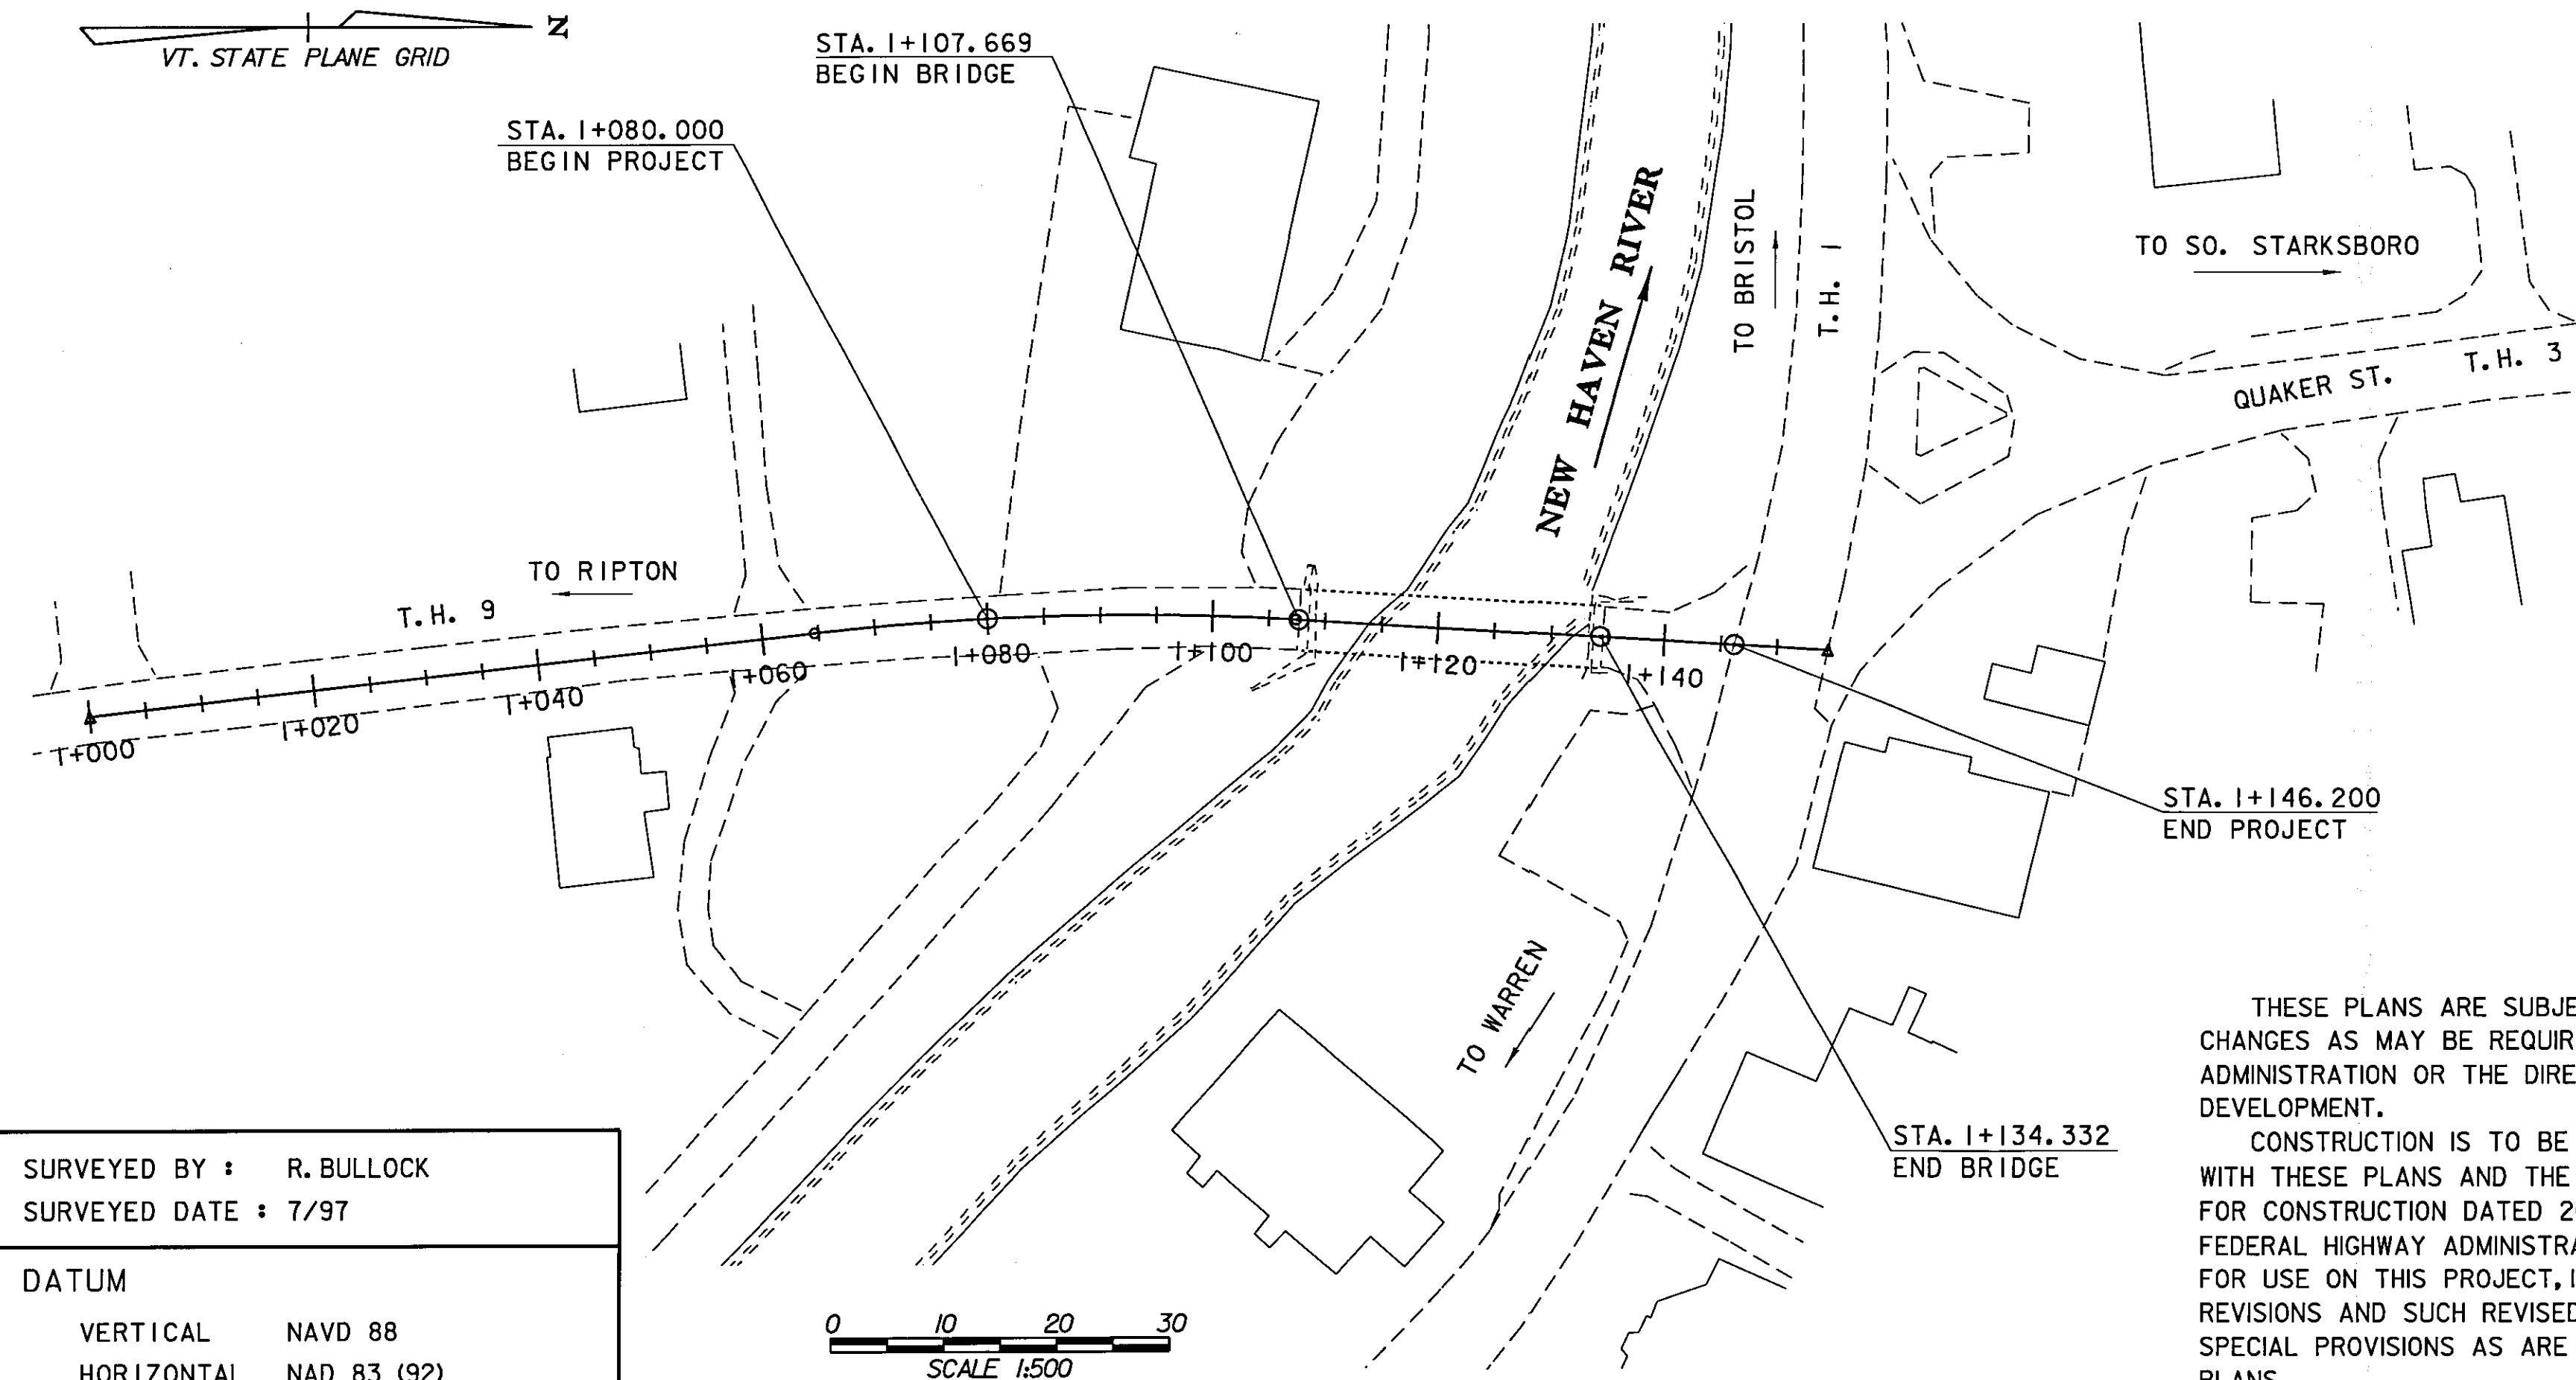

CONVENTIONAL SYMBOLS	
COUNTY LINE	
TOWN LINE	
LIMITS OF ACCESS	
POINT OF ACCESS	
FENCE LINE	
STONE WALL	
TRAVELED WAY	
GUARD RAIL	
RAILROAD	
SURVEY LINE	
CULVERT	
POWER POLE	
TELEPHONE POLE	
TREES	
CONTROL OF ACCESS	
PROPERTY LINE	
R.O.W. TAKING LINE	
SLOPE RIGHTS	
TOP OF CUT	
TOE OF SLOPE	

SURVEYED BY : R. BULLOCK
SURVEYED DATE : 7/97

DATUM
VERTICAL NAVD 88
HORIZONTAL NAD 83 (92)

THESE PLANS ARE SUBJECT TO SUCH ENGINEERING CHANGES AS MAY BE REQUIRED BY THE FEDERAL HIGHWAY ADMINISTRATION OR THE DIRECTOR OF PROGRAM DEVELOPMENT.

CONSTRUCTION IS TO BE CARRIED ON IN ACCORDANCE WITH THESE PLANS AND THE STANDARD SPECIFICATIONS FOR CONSTRUCTION DATED 2006, AS APPROVED BY THE FEDERAL HIGHWAY ADMINISTRATION ON JUNE 15, 2006 FOR USE ON THIS PROJECT, INCLUDING ALL SUBSEQUENT REVISIONS AND SUCH REVISED SPECIFICATIONS AND SPECIAL PROVISIONS AS ARE INCORPORATED IN THESE PLANS.

29-JAN-2009

UNLESS NOTED OTHERWISE
STATIONS ARE IN KILOMETERS
ELEVATIONS ARE IN METERS
DIMENSIONS ARE IN MILLIMETERS

DIRECTOR OF PROGRAM DEVELOPMENT	
APPROVED	DATE 1-29-09
PROJECT MANAGER : R. WHITCOMB	
PROJECT NAME : LINCOLN	
PROJECT NUMBER : BRO 1445 (25)	
SHEET 1 OF 58 SHEETS	