



PROFILE

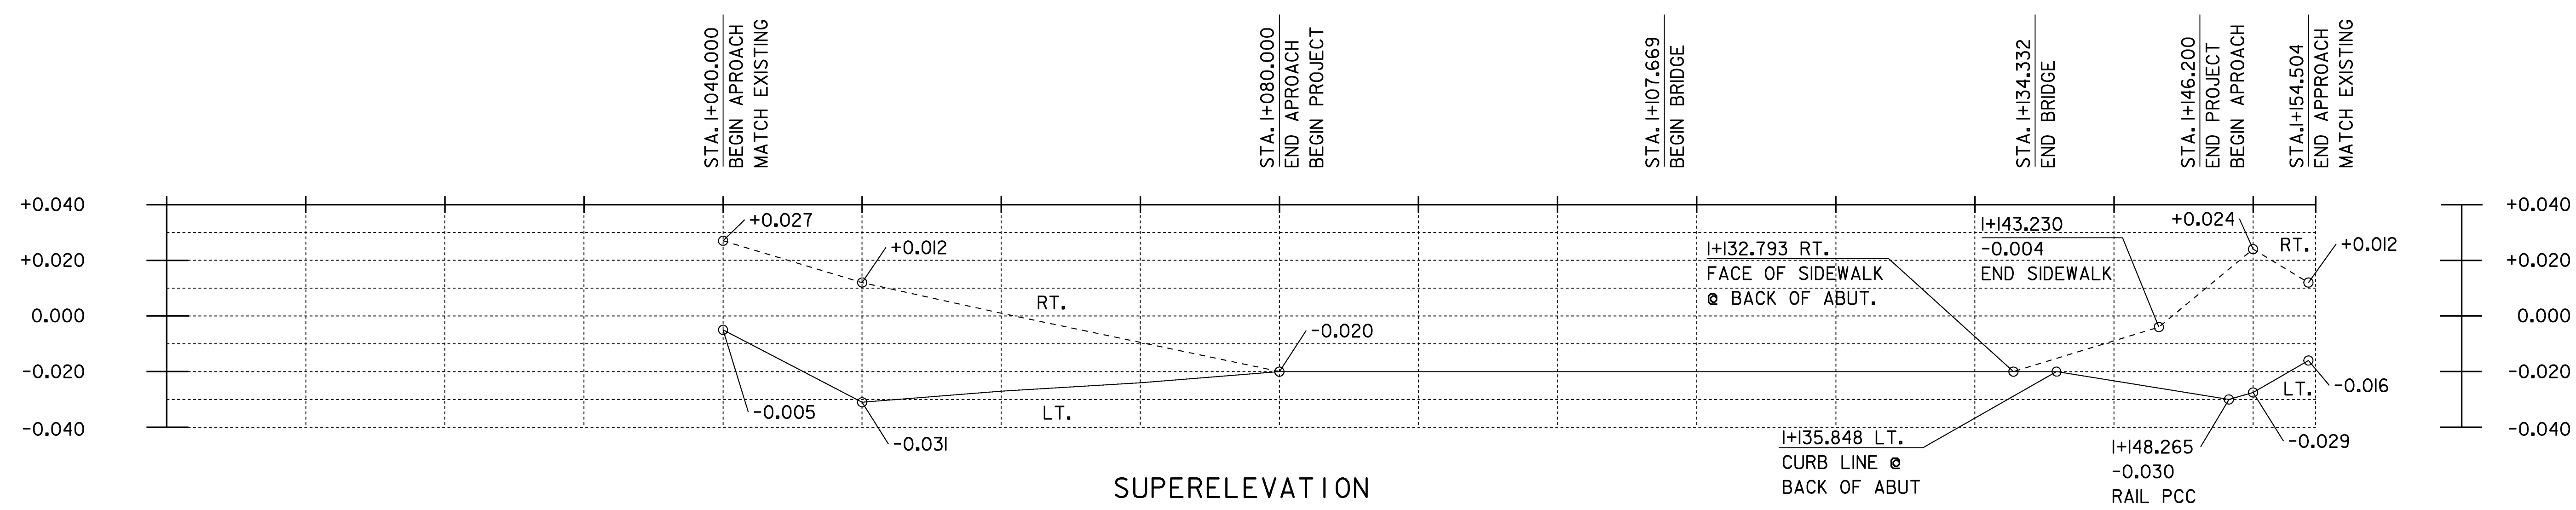

SUPERELEVATION

NOTES:
 1. ELEVATIONS TO THE NEAREST 0.01 ARE EXISTING GROUND ALONG PROPOSED CENTERLINE.
 2. ELEVATIONS TO THE NEAREST 0.001 ARE FINISH GRADE ALONG PROPOSED CENTERLINE.

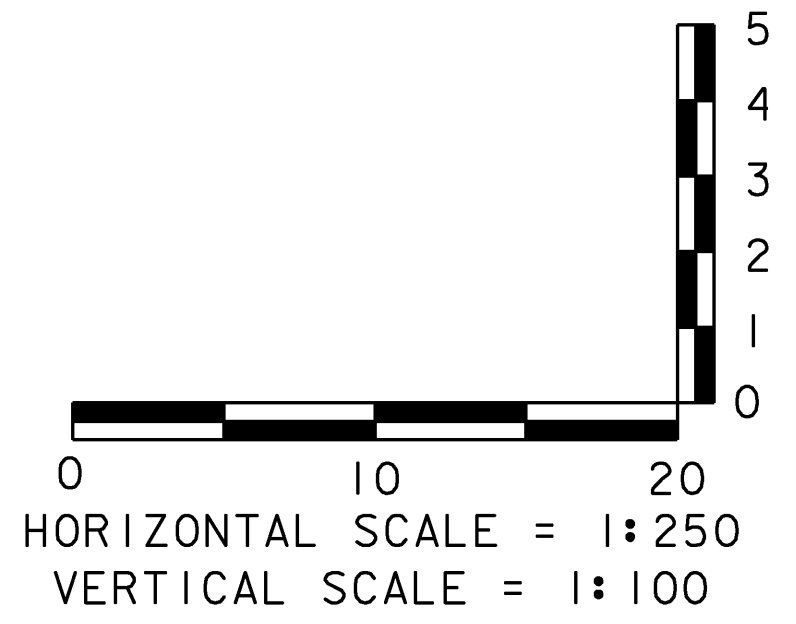

PROJECT NAME:	LINCOLN	PLOT DATE:	29-JAN-2009
PROJECT NUMBER:	BRO 1445 (25)	DRAWN BY:	S. SCRIBNER
FILE NAME:	s96J266xs.dgn	CHECKED BY:	C. CARLSON
PROJECT MANAGER:	R. WHITCOMB	SHEET II	OF 58
DESIGNED BY:	S. SCRIBNER		
PROFILE			

PROFILE