
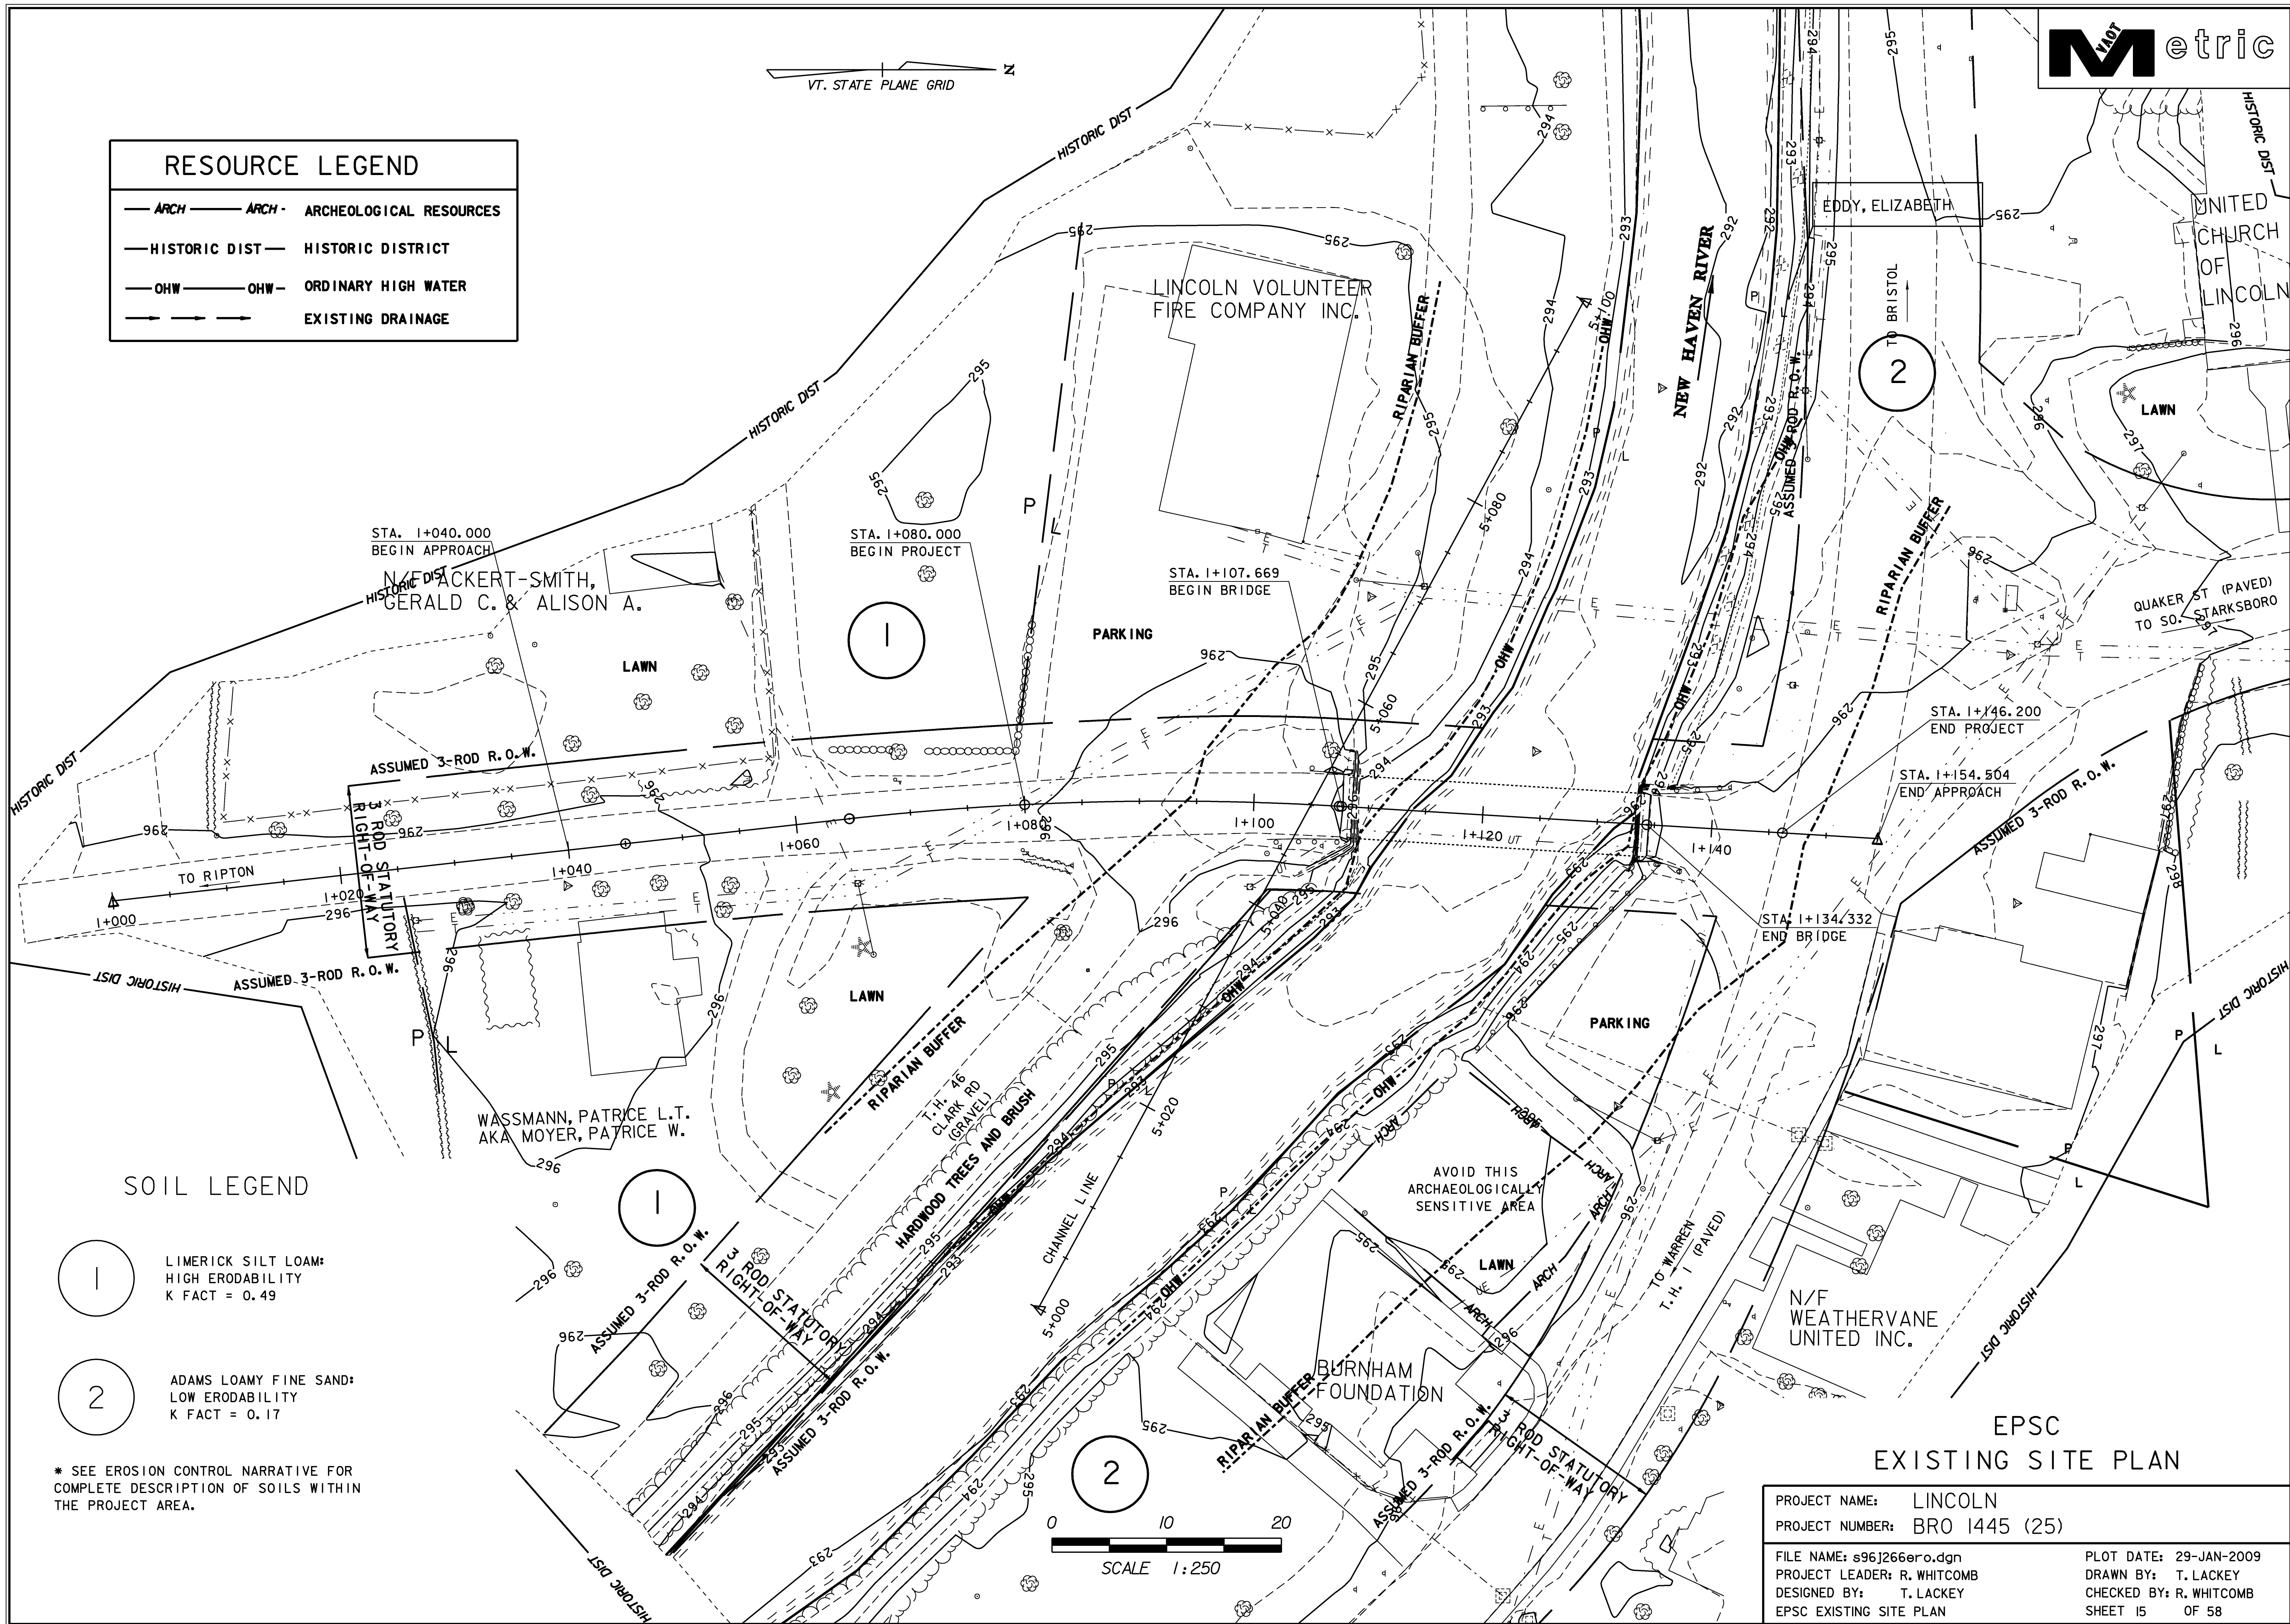


RESOURCE LEGEND	
— ARCH —	— ARCH — ARCHEOLOGICAL RESOURCES
— HISTORIC DIST —	— HISTORIC DIST — HISTORIC DISTRICT
— OHW —	— OHW — ORDINARY HIGH WATER
— —>	— —> — EXISTING DRAINAGE

SOIL LEGEND

- 1 LIMERICK SILT LOAM:
HIGH ERODABILITY
K FACT = 0.49
- 2 ADAMS LOAMY FINE SAND:
LOW ERODABILITY
K FACT = 0.17

* SEE EROSION CONTROL NARRATIVE FOR COMPLETE DESCRIPTION OF SOILS WITHIN THE PROJECT AREA.

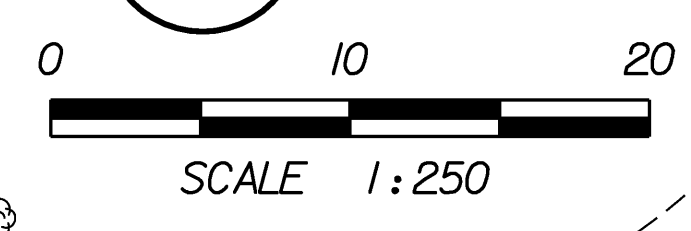

EPSC
EXISTING SITE PLAN

PROJECT NAME:	LINCOLN
PROJECT NUMBER:	BRO 1445 (25)
FILE NAME:	s96j266e0.dgn
PROJECT LEADER:	R. WHITCOMB
DESIGNED BY:	T. LACKEY
EPSC EXISTING SITE PLAN	
PLOT DATE:	29-JAN-2009
DRAWN BY:	T. LACKEY
CHECKED BY:	R. WHITCOMB
SHEET	15 OF 58