



PLAN

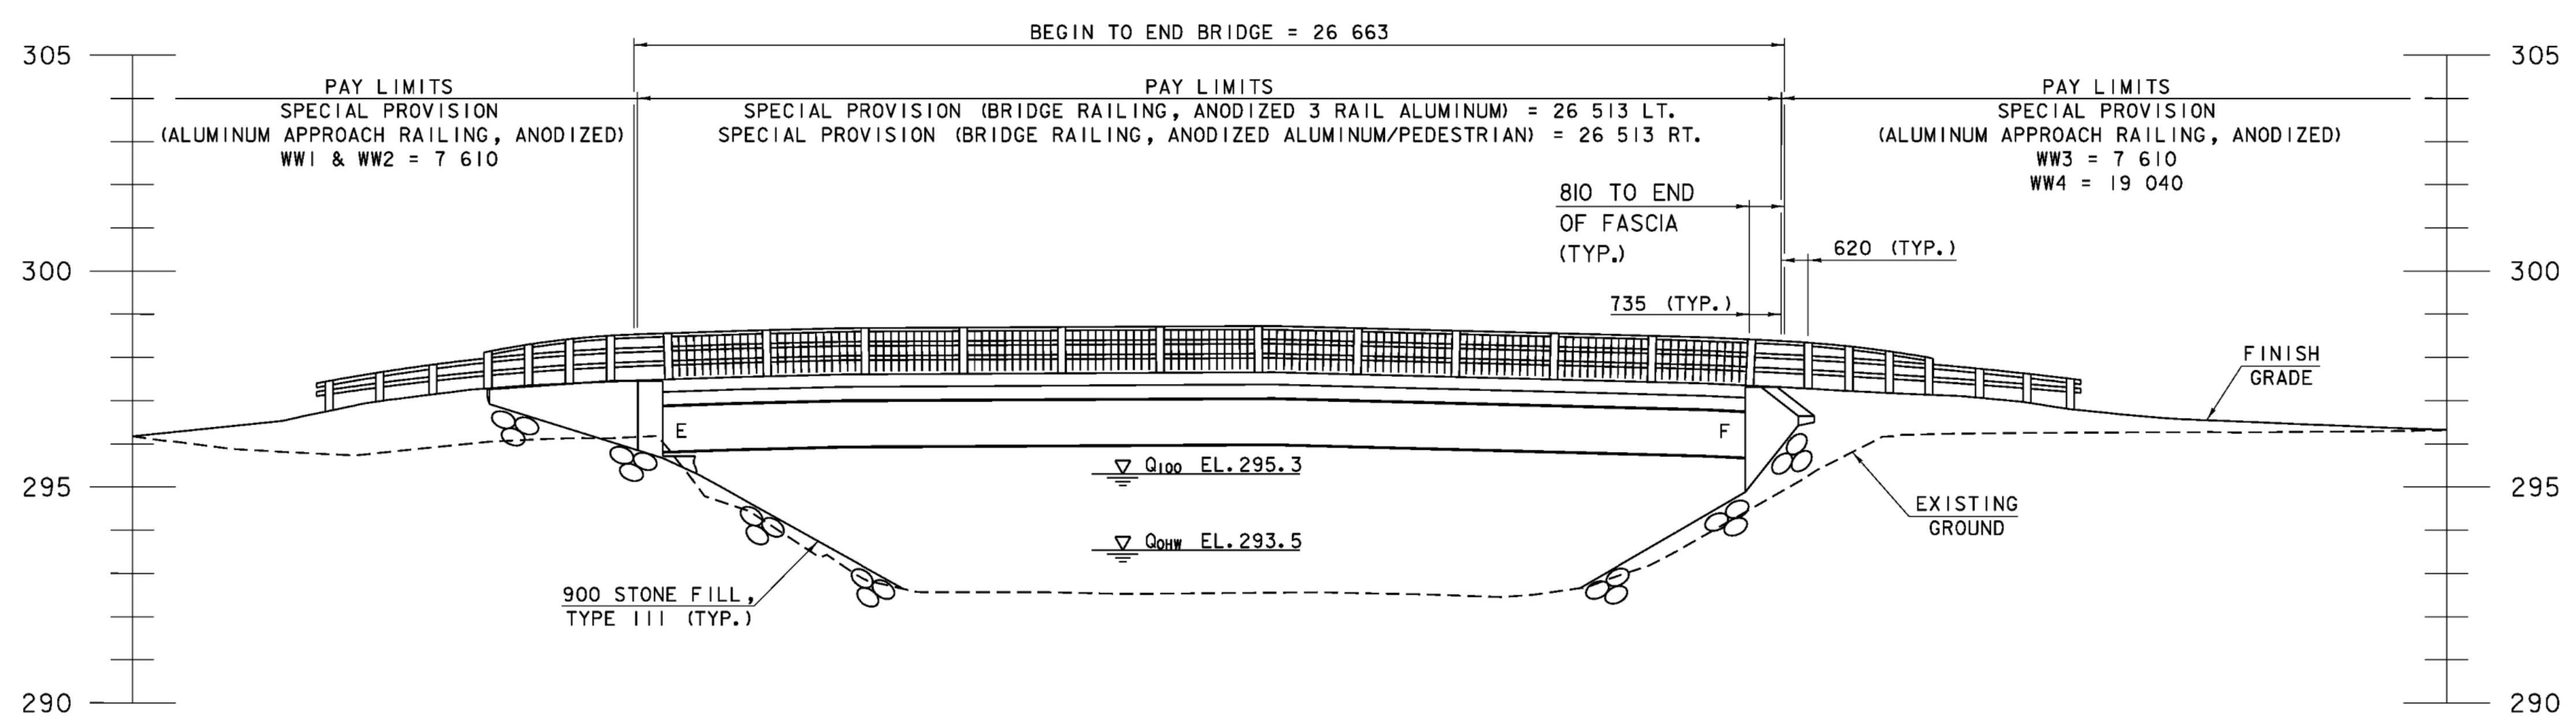

ELEVATION

PLAN & ELEVATION

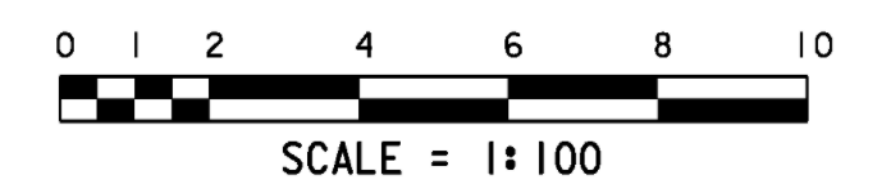

PROJECT NAME:	LINCOLN	PLOT DATE:	29-JAN-2009
PROJECT NUMBER:	BRO 1445 (25)	DRAWN BY:	T. LACKEY
FILE NAME:	s96j266pe.dgn	CHECKED BY:	R. WHITCOMB
PROJECT MANAGER:	R. WHITCOMB	PLAN & ELEVATION	SHEET 28 OF 58
DESIGNED BY:	S. SCRIBNER		