

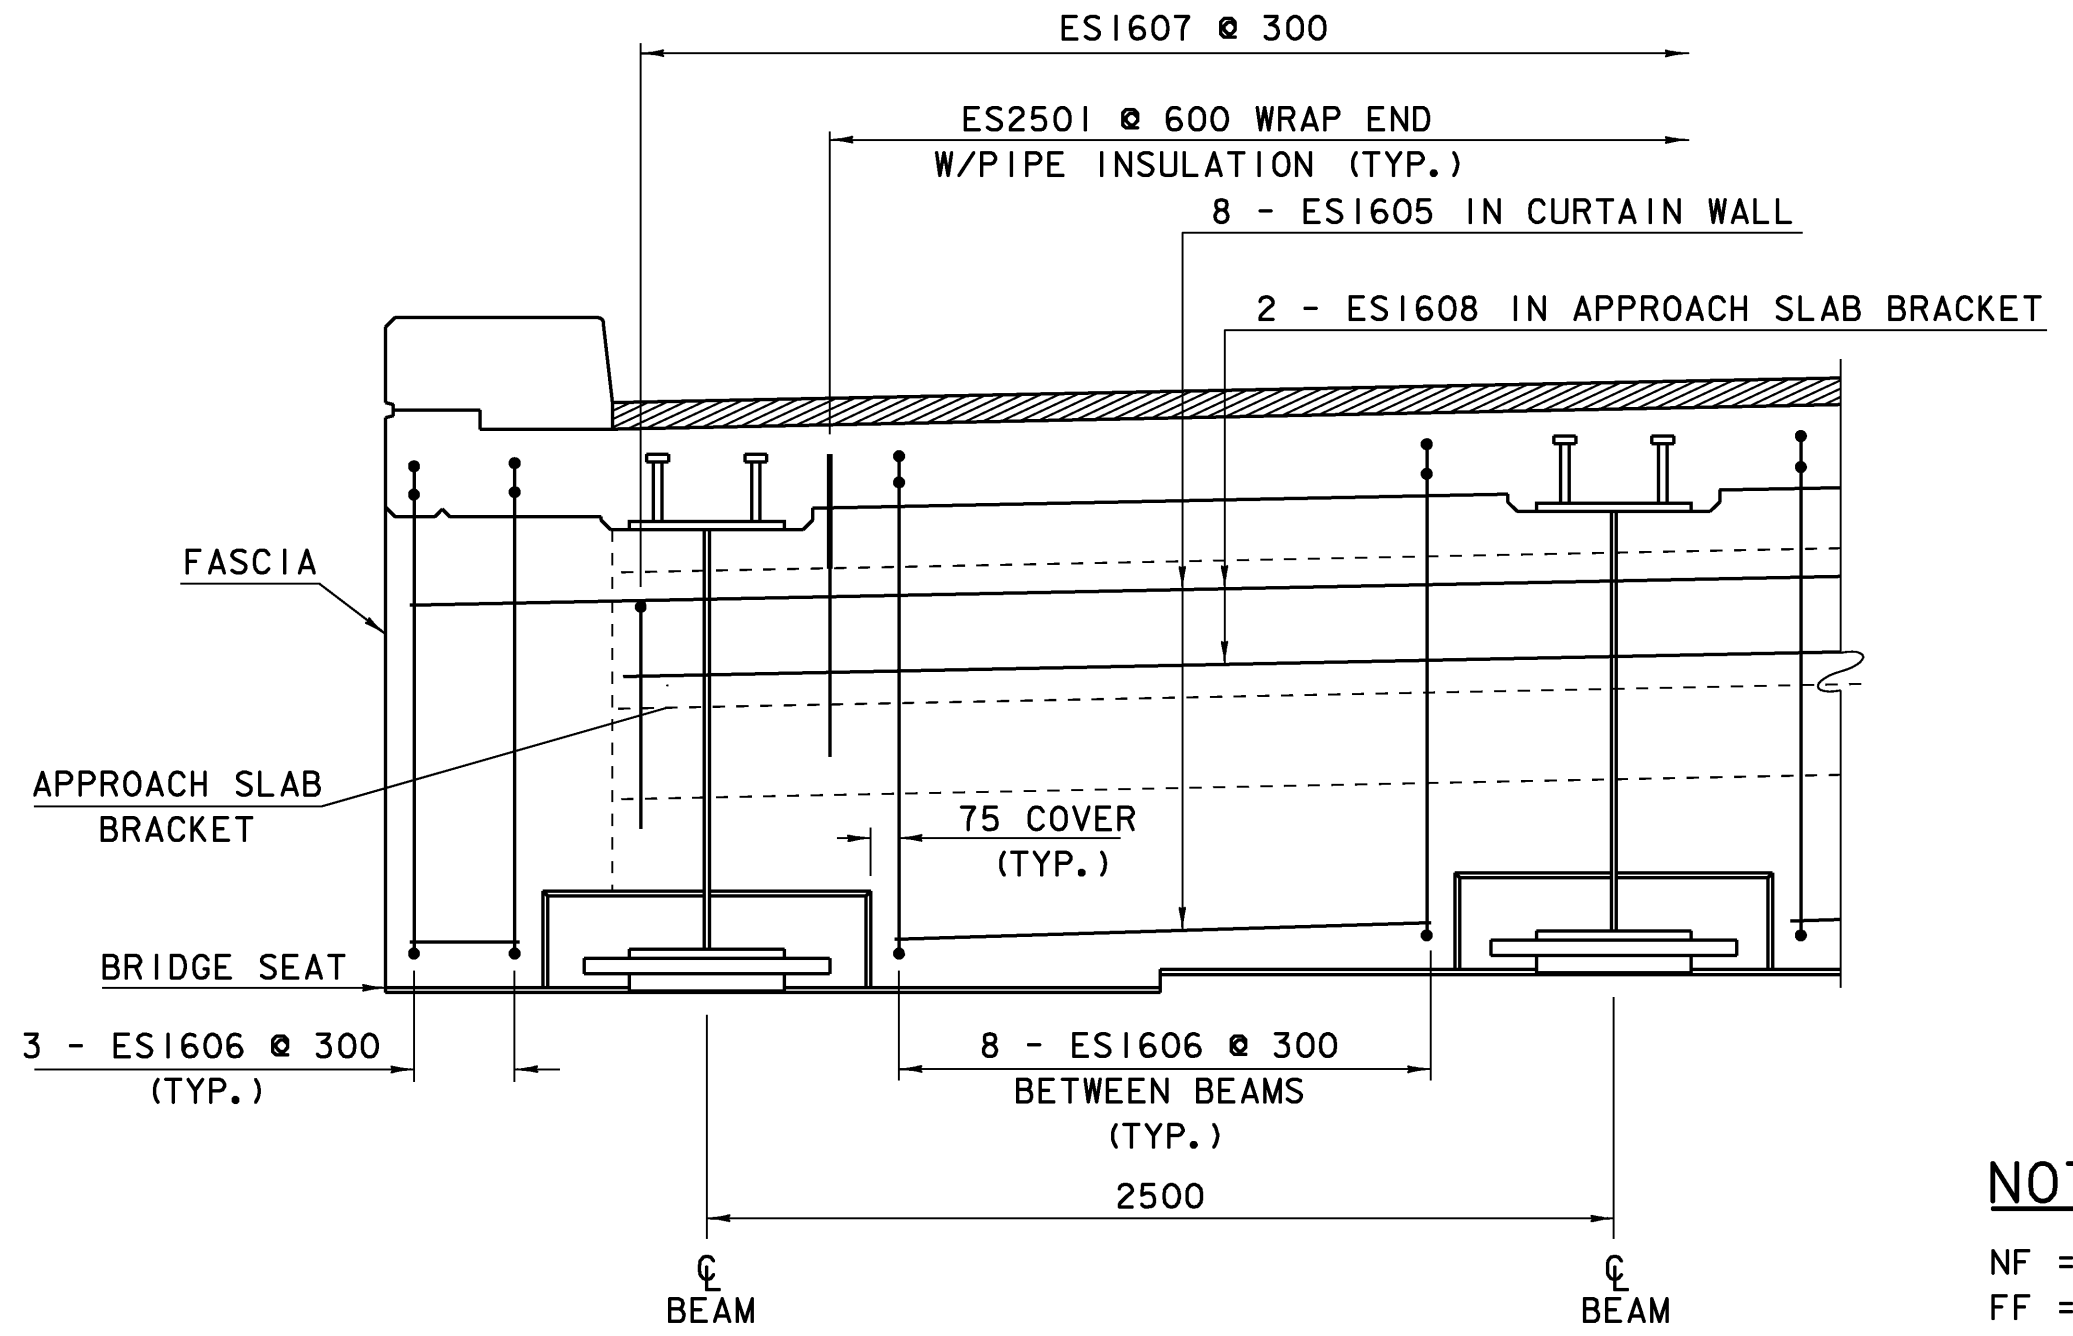
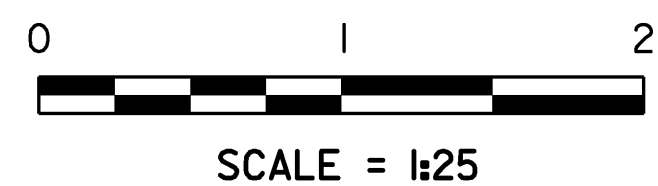
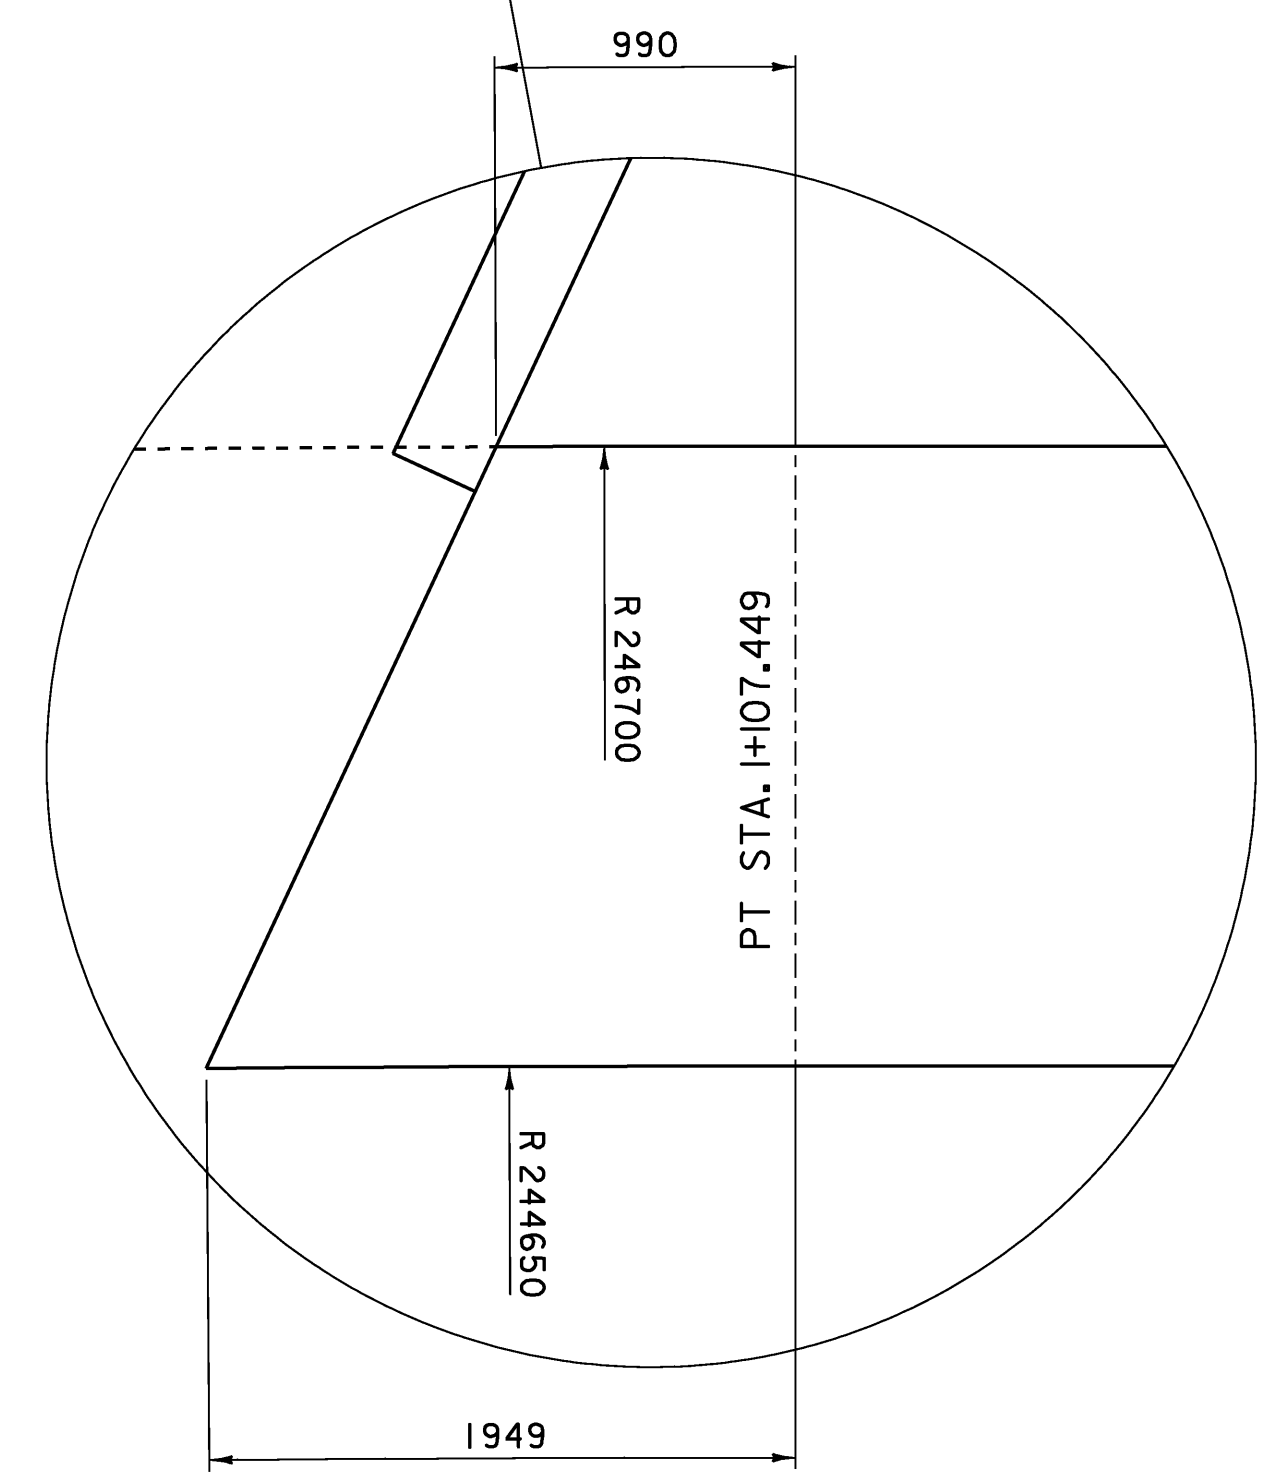
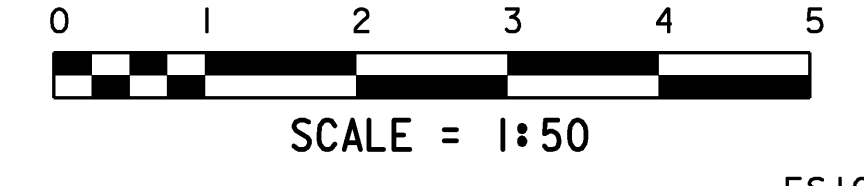


DECK REINFORCING PLAN

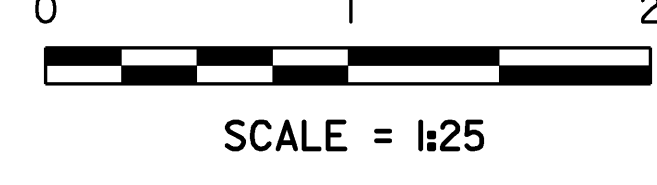

SECTION "A-A"

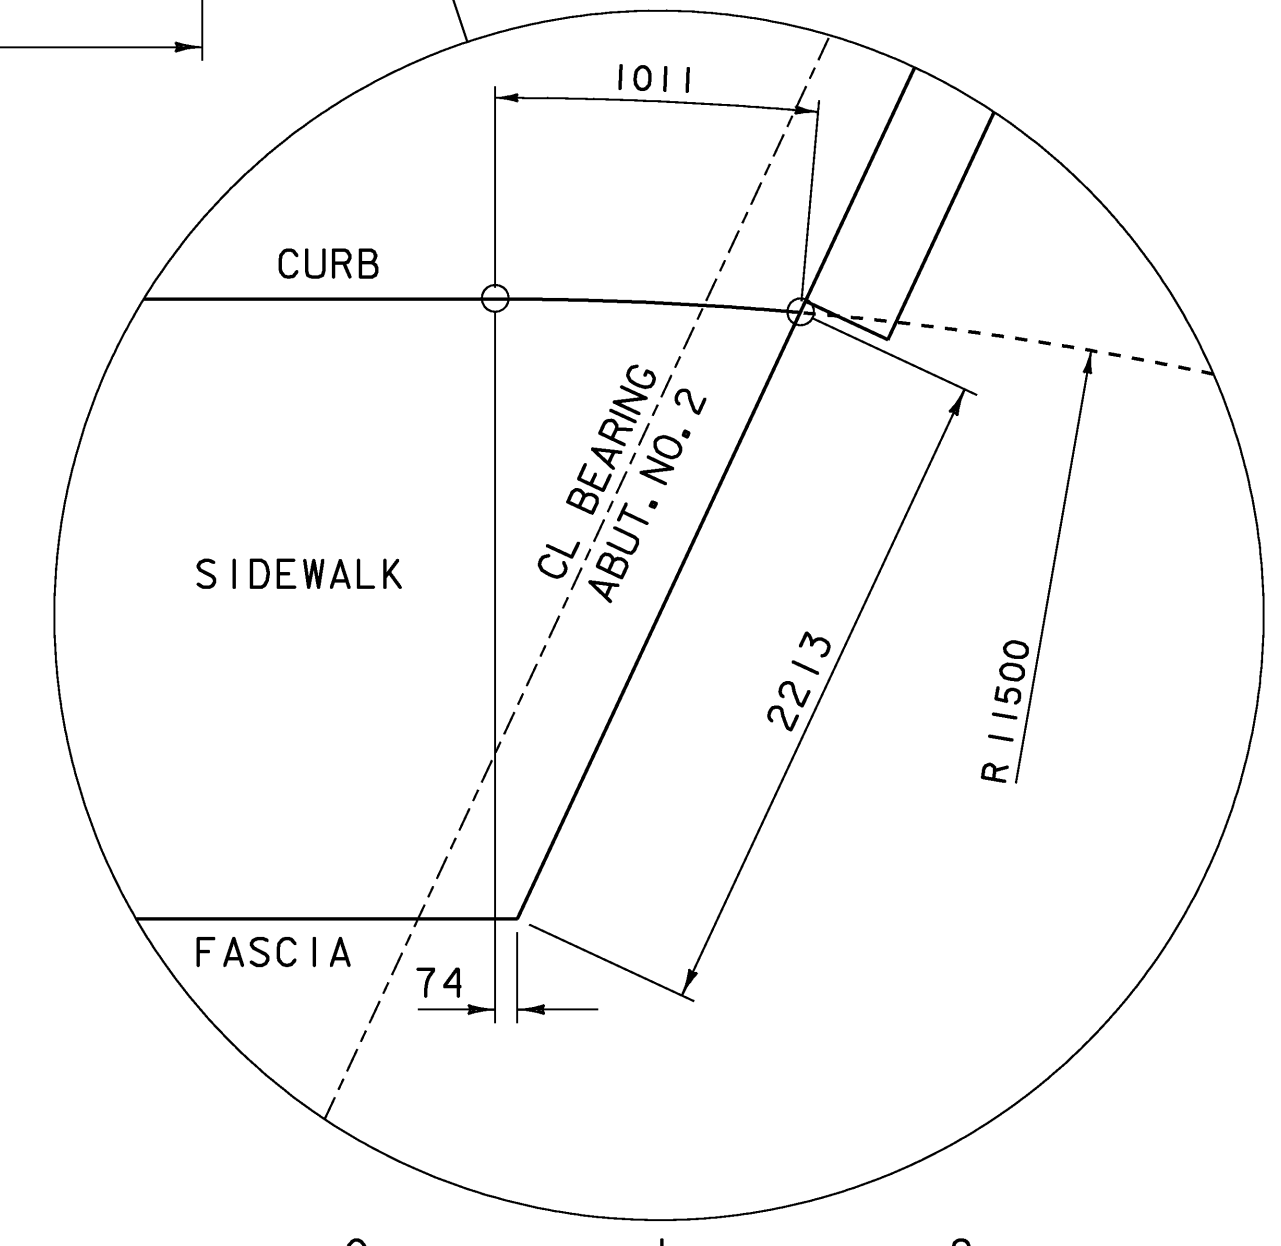

SUPERSTRUCTURE PLAN

- NOTES:**
- NF = NEAR FACE
 - FF = FAR FACE
 - EF = EACH FACE
 - ▲ = CUT TO FIT IN FIELD
 - 75 COVER UNLESS OTHERWISE SPECIFIED ON THE PLANS.
 - 660 MIN. LAP SPLICE UNLESS OTHERWISE SPECIFIED ON THE PLANS.

PROJECT NAME: LINCOLN	PLOT DATE: 29-JAN-2009
PROJECT NUMBER: BRO 1445(25)	DRAWN BY: C. MOONEY
FILE NAME: s96j266str.dgn	CHECKED BY: R. WHITCOMB
PROJECT LEADER: R. WHITCOMB	SHEET 30 OF 58
DESIGNED BY: S. SCRIBNER	
SUPERSTRUCTURE PLAN	