


APPROACH RAILING
LAYOUT PLAN

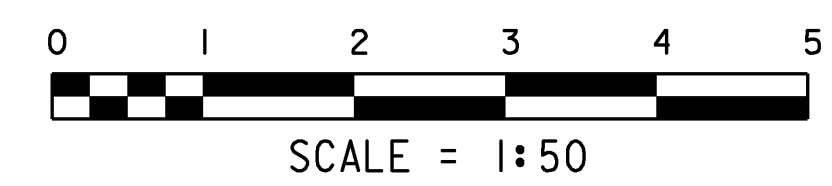

PROJECT NAME:	LINCOLN	PLOT DATE:	29-JAN-2009
PROJECT NUMBER:	BRO 1445 (25)	DRAWN BY:	C.MOONEY
FILE NAME:	s96j266r-all.dgn	CHECKED BY:	T.LACKEY
PROJECT LEADER:	R. WHITCOMB	APPROACH RAILING LAYOUT PLAN	SHEET 47 OF 58