


STA. I+040.000
BEGIN APPROACH
MATCH EXISTING

ROADWAY CROSS SECTIONS I

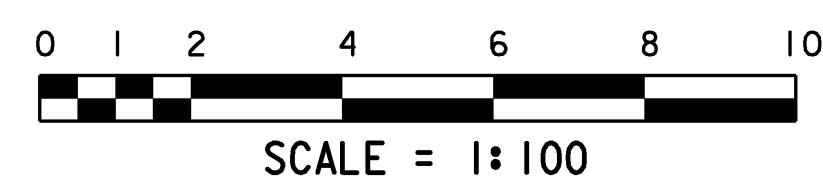

PROJECT NAME: LINCOLN	PLOT DATE: 29-JAN-2009
PROJECT NUMBER: BRO 1445 (25)	DRAWN BY: T. LACKEY
FILE NAME: s96j266xs.dgn	CHECKED BY: R. WHITCOMB
PROJECT MANAGER: R. WHITCOMB	SHEET 48 OF 58
DESIGNED BY: S. SCRIBNER	
ROADWAY CROSS SECTIONS I	