



5+065 STA. 5+065RT. (RIVER LEFT)
 END UNCLASS. CHANNEL EXCAVATION
 GEOTEXTILE UNDER STONE FILL
 STONE FILL, TYPE III
 GRUBBING MATERIAL

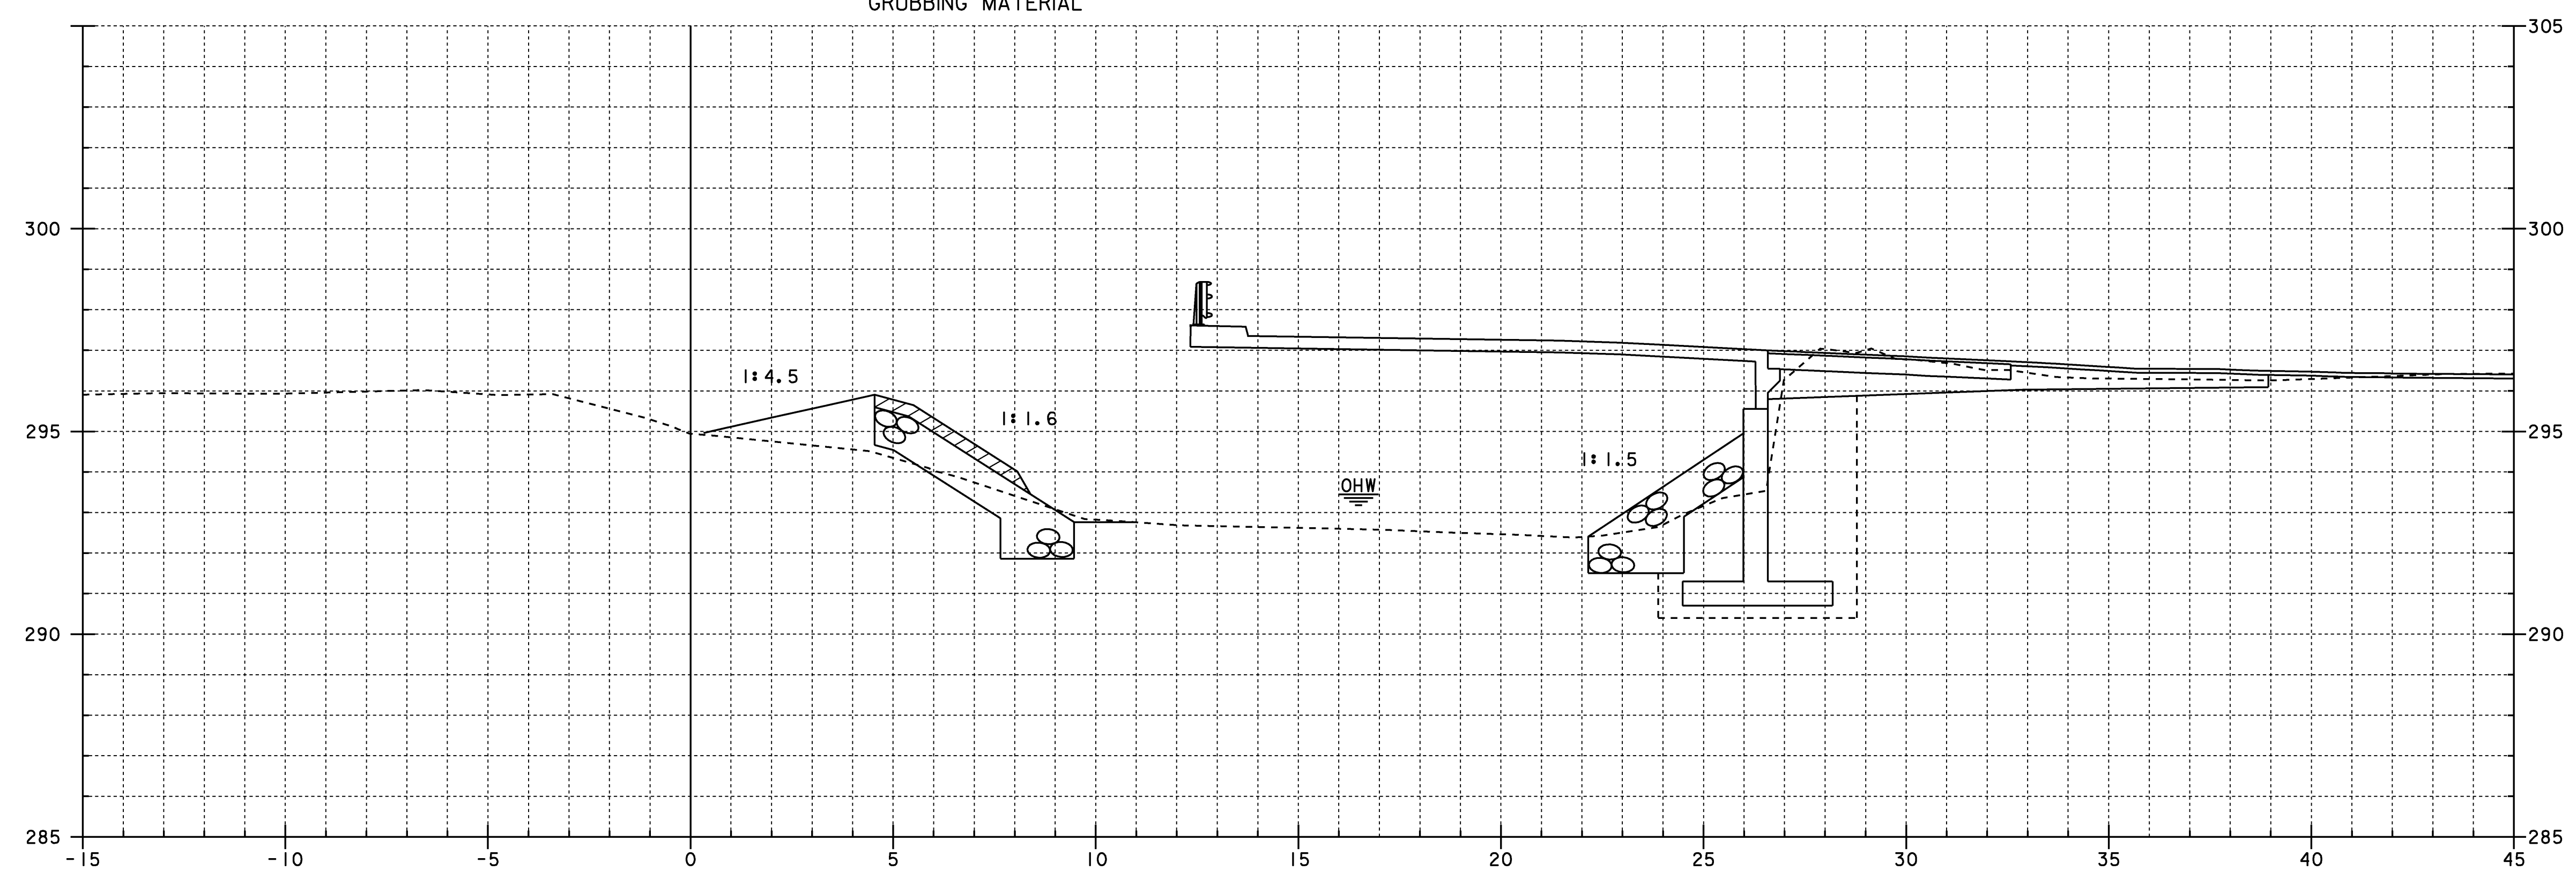

5+060

CHANNEL CROSS SECTIONS 4

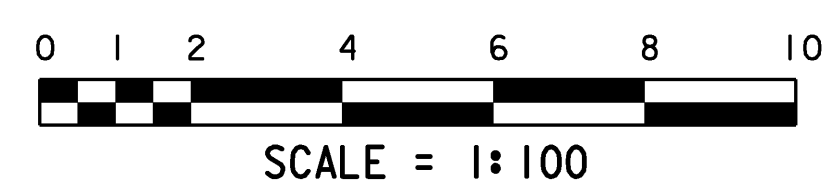

PROJECT NAME:	LINCOLN	PLOT DATE:	29-JAN-2009
PROJECT NUMBER:	BRO 1445 (25)	DRAWN BY:	T. LACKEY
FILE NAME:	s96j266xs.dgn	CHECKED BY:	R. WHITCOMB
PROJECT MANAGER:	R. WHITCOMB	CHANNEL CROSS SECTIONS 4	SHEET 54 OF 58
DESIGNED BY:	S. SCRIBNER		