


5+080

STA. 5+075.1 RT. (RIVER RIGHT)
 END UNCLASS. CHANNEL EXCAVATION
 GEOTEXTILE UNDER STONE FILL
 STONE FILL, TYPE III
 GRUBBING MATERIAL

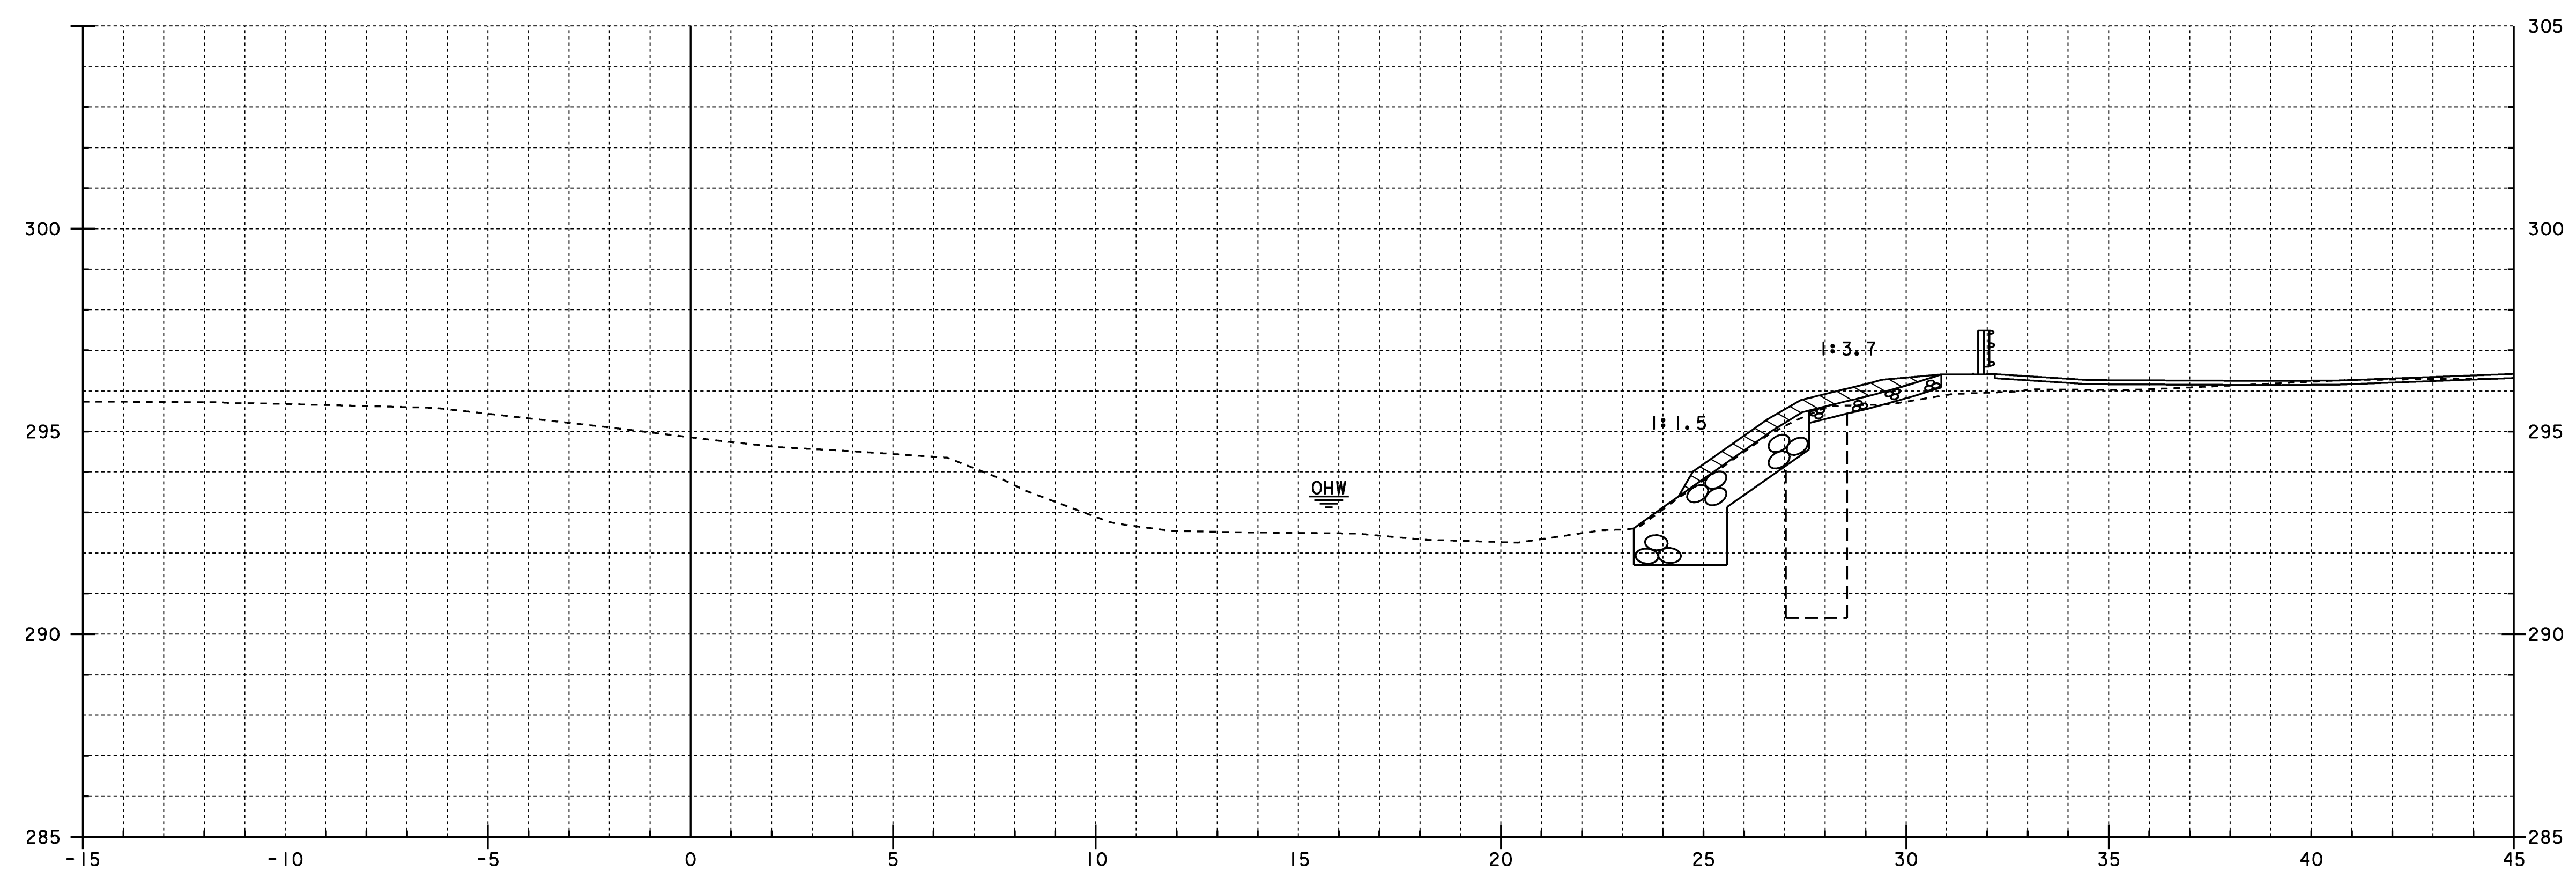

5+070

CHANNEL CROSS SECTIONS 5



PROJECT NAME:	LINCOLN	PLOT DATE:	29-JAN-2009
PROJECT NUMBER:	BRO 1445 (25)	DRAWN BY:	T. LACKEY
FILE NAME:	s96j266xs.dgn	CHECKED BY:	R. WHITCOMB
PROJECT MANAGER:	R. WHITCOMB	SHEET	55 OF 58
DESIGNED BY:	S. SCRIBNER		
CHANNEL CROSS SECTIONS	5		