


SEE SHEET 2 FOR INDEX OF SHEETS  
AND LIST OF STANDARDS.

# STATE OF VERMONT AGENCY OF TRANSPORTATION



## PROPOSED IMPROVEMENT BRIDGE PROJECT TOWNS OF SALISBURY & CORNWALL COUNTY OF ADDISON


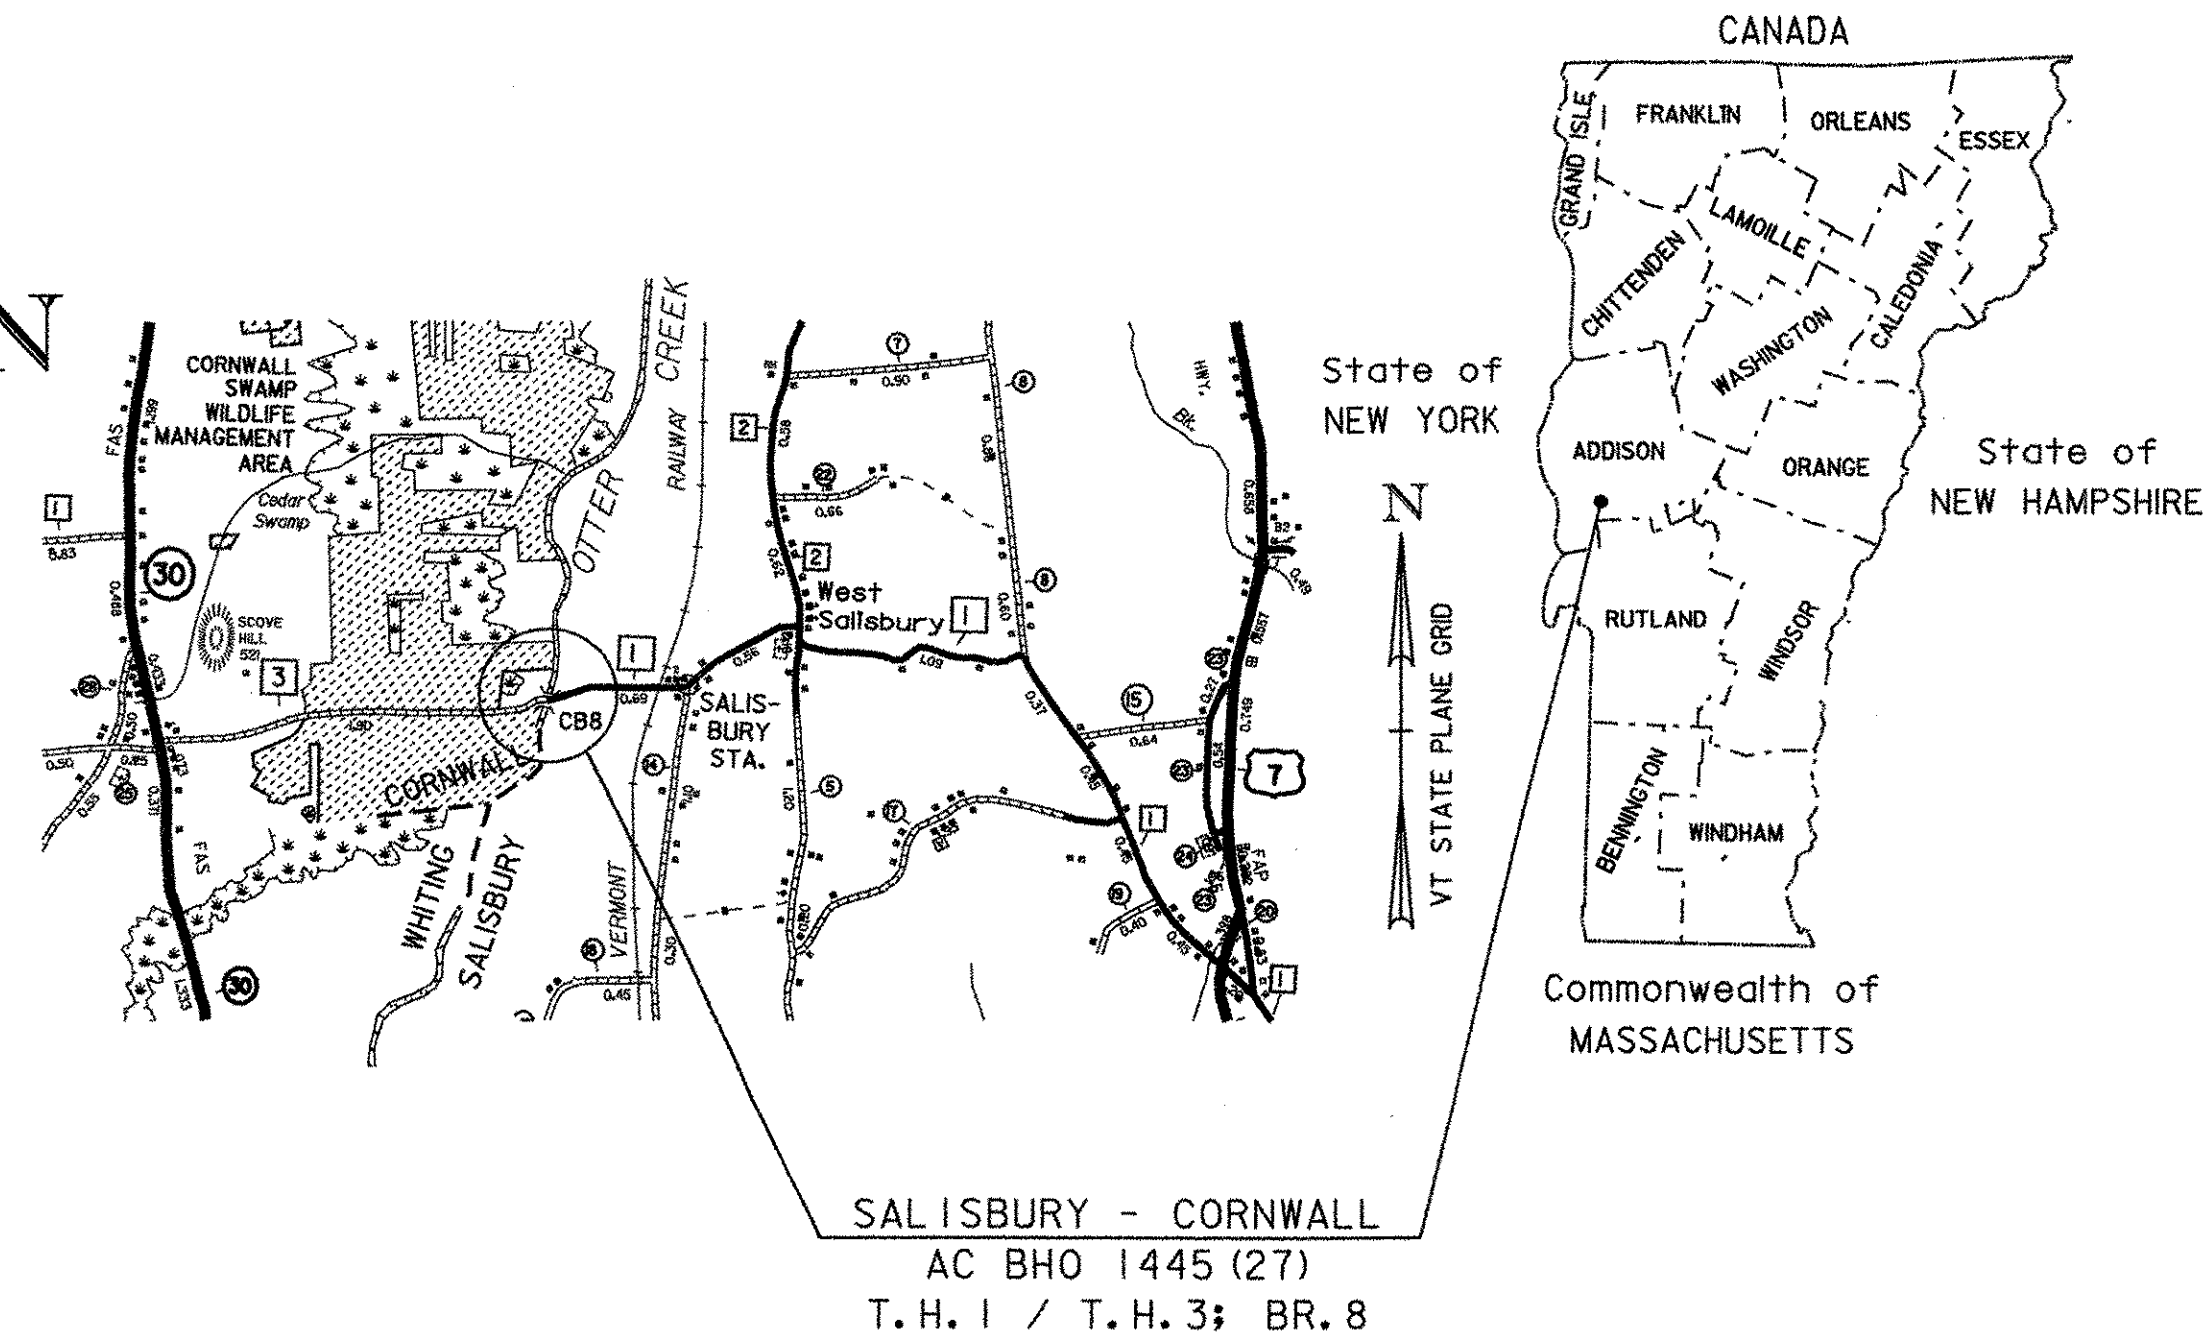


ROUTE NO : T.H. 1 / T.H. 3 CL. 2    BRIDGE NO : 8 (CEDAR SWAMP)

PROJECT LOCATION : BEGINNING AT A POINT ON T.H. 3 IN THE TOWN OF CORNWALL APPROXIMATELY 1.88 MILES EASTERLY FROM ITS INTERSECTION WITH VT 30 AND PROCEEDING EASTERLY 0.071 MILES TO A POINT ON T.H. 1 IN THE TOWN OF SALISBURY.

PROJECT DESCRIPTION : REHABILITATION OF COVERED BRIDGE WITH NECESSARY APPROACH WORK.

LENGTH OF STRUCTURE : 154.00 FEET  
LENGTH OF ROADWAY : 221.00 FEET  
LENGTH OF PROJECT : 375.00 FEET

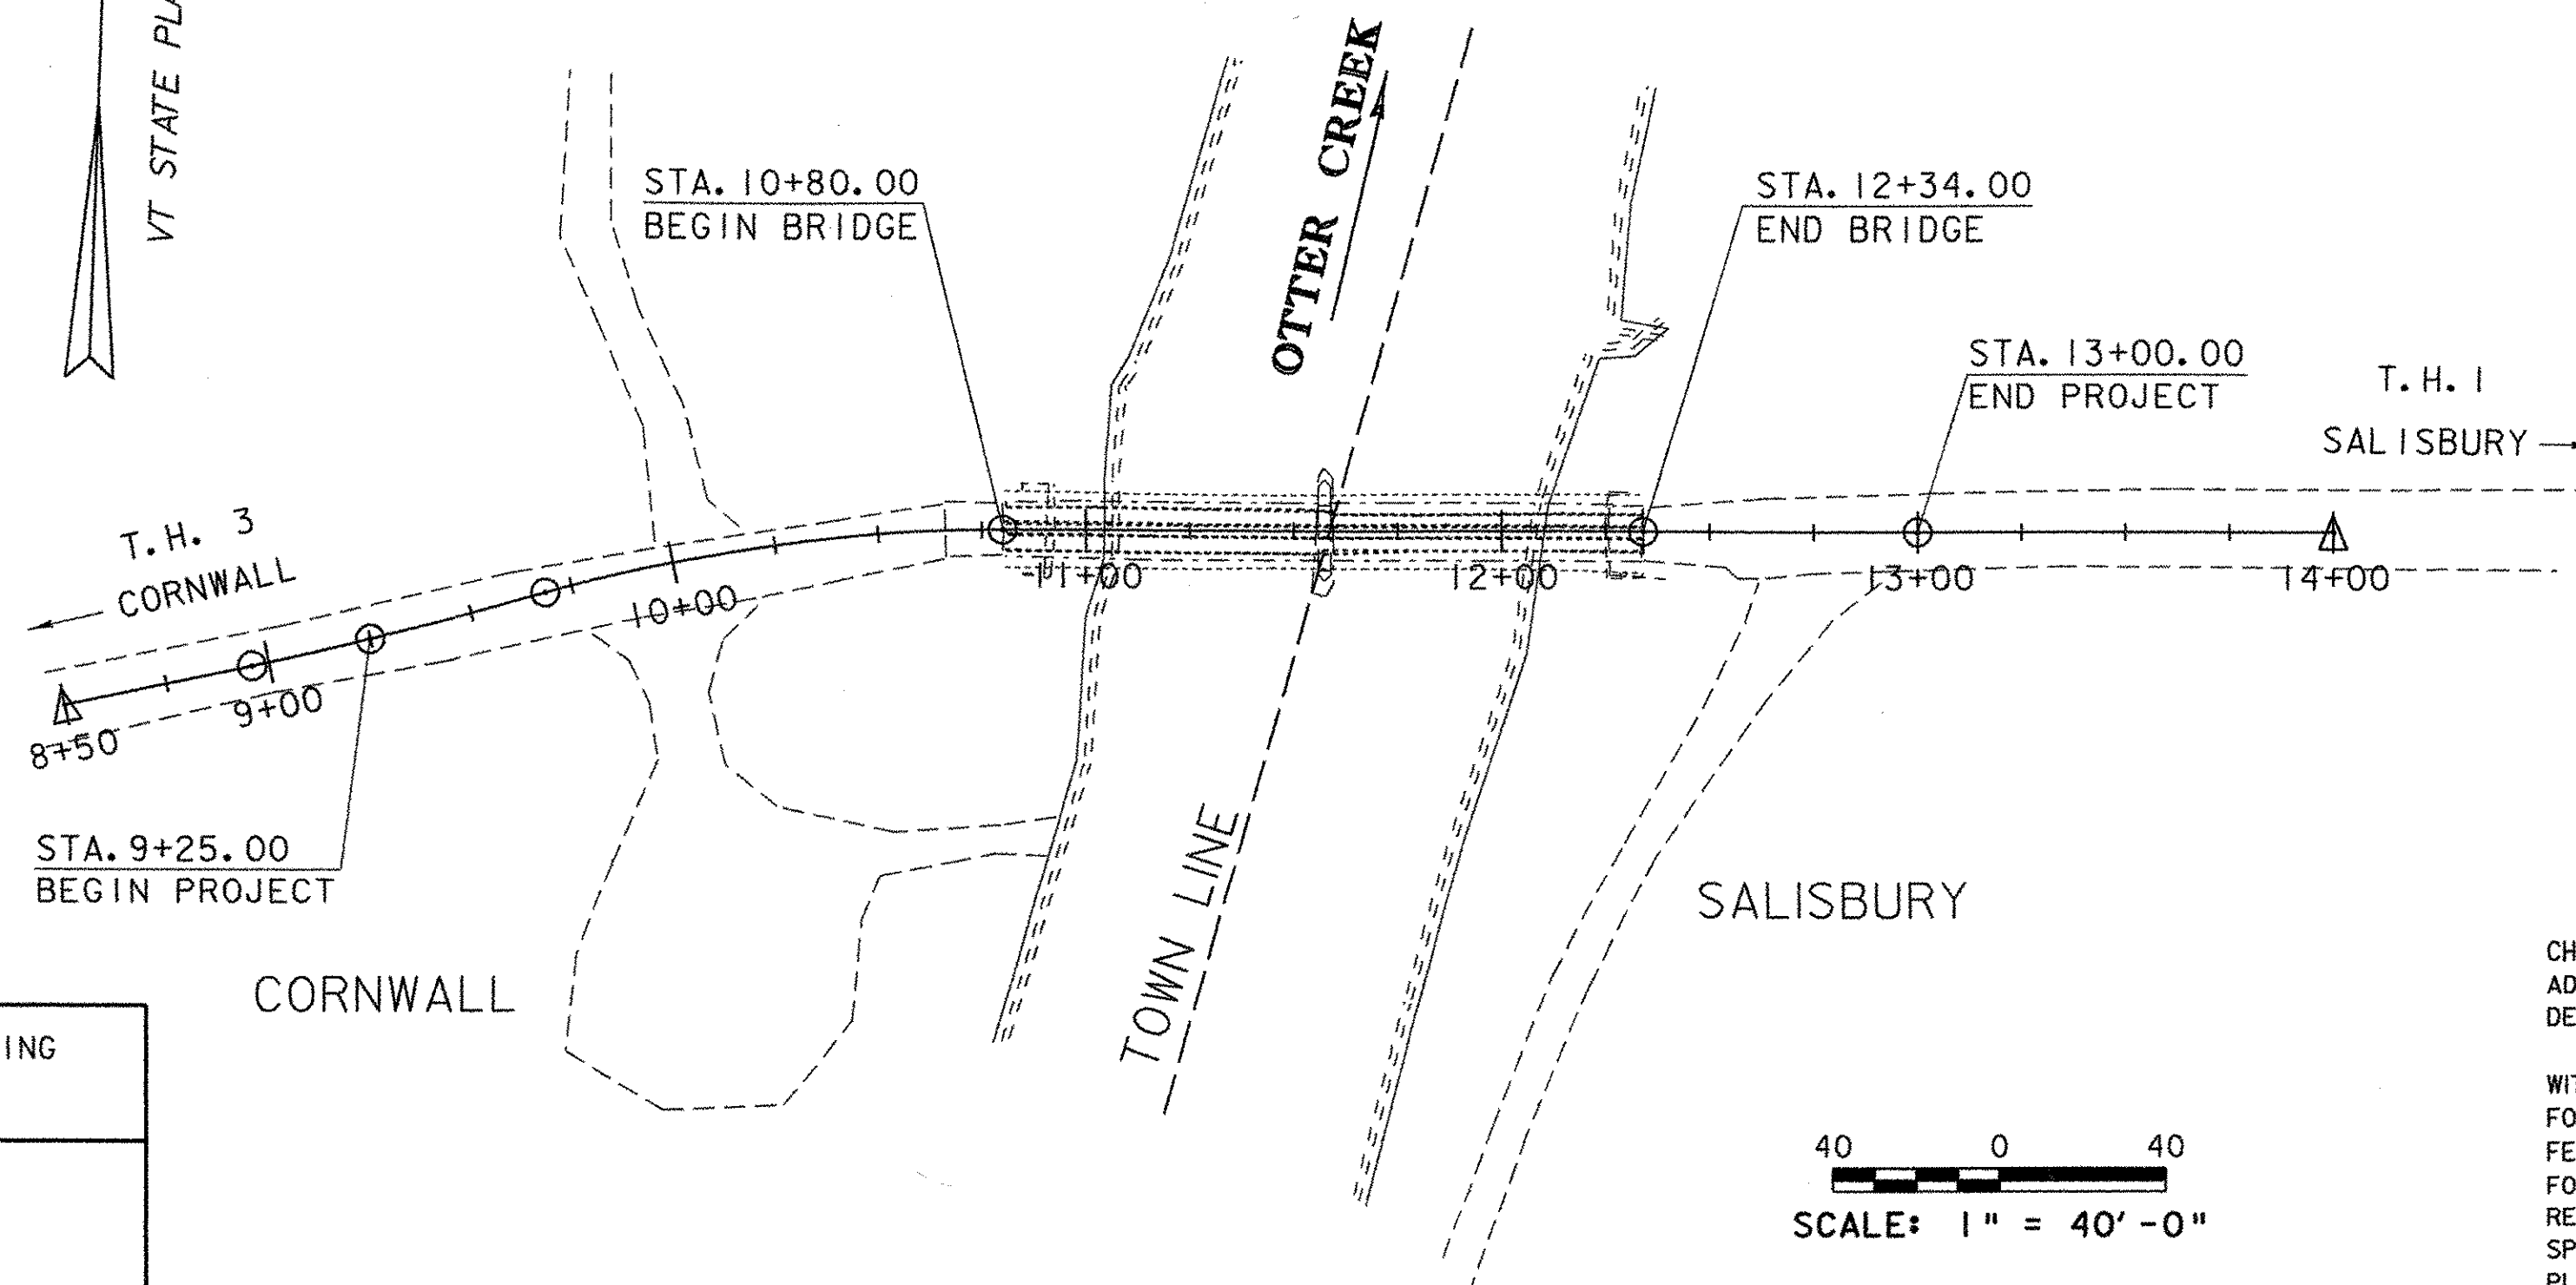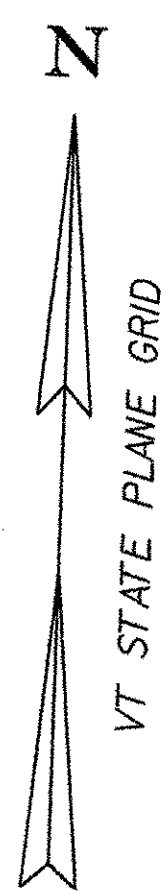

### CONVENTIONAL SYMBOLS

COUNTY LINE	
TOWN LINE	
LIMITS OF ACCESS	
POINT OF ACCESS	
FENCE LINE	
STONE WALL	
TRAVELED WAY	
GUARD RAIL	
RAILROAD	
SURVEY LINE	
CULVERT	
POWER POLE	
TELEPHONE POLE	
TREES	
CONTROL OF ACCESS	
PROPERTY LINE	
R.O.W. TAKING LINE	
SLOPE RIGHTS	
TOP OF CUT	
TOE OF SLOPE	

SURVEYED BY : DUBOIS & KING  
SURVEYED DATE : 06/99

DATUM  
VERTICAL    NAVD 88  
HORIZONTAL    NAD 83 (96)

THESE PLANS ARE SUBJECT TO SUCH ENGINEERING CHANGES AS MAY BE REQUIRED BY THE FEDERAL HIGHWAY ADMINISTRATION OR THE DIRECTOR OF PROGRAM DEVELOPMENT.  
CONSTRUCTION IS TO BE CARRIED ON IN ACCORDANCE WITH THESE PLANS AND THE STANDARD SPECIFICATIONS FOR CONSTRUCTION DATED 2006, AS APPROVED BY THE FEDERAL HIGHWAY ADMINISTRATION ON JUNE 15, 2006 FOR USE ON THIS PROJECT, INCLUDING ALL SUBSEQUENT REVISIONS AND SUCH REISED SPECIFICATIONS AND SPECIAL PROVISIONS AS ARE INCORPORATED IN THESE PLANS.

40    0    40  
SCALE: 1" = 40'-0"

DEPARTMENT OF TRANSPORTATION FEDERAL HIGHWAY ADMINISTRATOR	
APPROVED <i>Ted Kendall</i>	DATE 4-9-2007
DIRECTOR OF PROGRAM DEVELOPMENT	
APPROVED <i>James V. B...</i>	DATE 3-30-2007
PROJECT MANAGER : R. R. WHITCOMB	
PROJECT NAME : SALISBURY - CORNWALL	
PROJECT NUMBER : AC BHO 1445 (27)	
SHEET 1 OF 60 SHEETS	