


LEGEND

----- RIPARIAN BUFFER

BM NO. 1
RR SPIKE IN 16" ELM
ELEV. 346.19

NOTE:

FINAL CONTOURS ARE NOT SHOWN. SEE CROSS SECTIONS FOR FINAL GRADE INFORMATION.

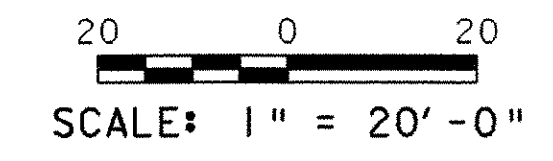

**FINAL CONDITIONS
SITE PLAN**

PROJECT NAME: SALISBURY - CORNWALL	PLOT DATE: 02-APR-2007
PROJECT NUMBER: BHO 1445 (27)	DRAWN BY: M. HALE
FILE NAME: 96j268\Structures\sj268ec3.1	CHECKED BY: C. CARLSON
PROJECT MANAGER: R. R. WHITCOMB	SHEET 16 OF 60
DESIGNED BY: M. HALE	