



TYPICAL CONCRETE CONSTRUCTION JOINT
NOT TO SCALE

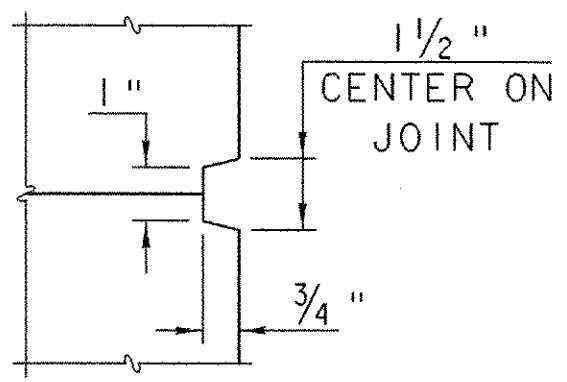

SCORE MARK DETAIL
NOT TO SCALE

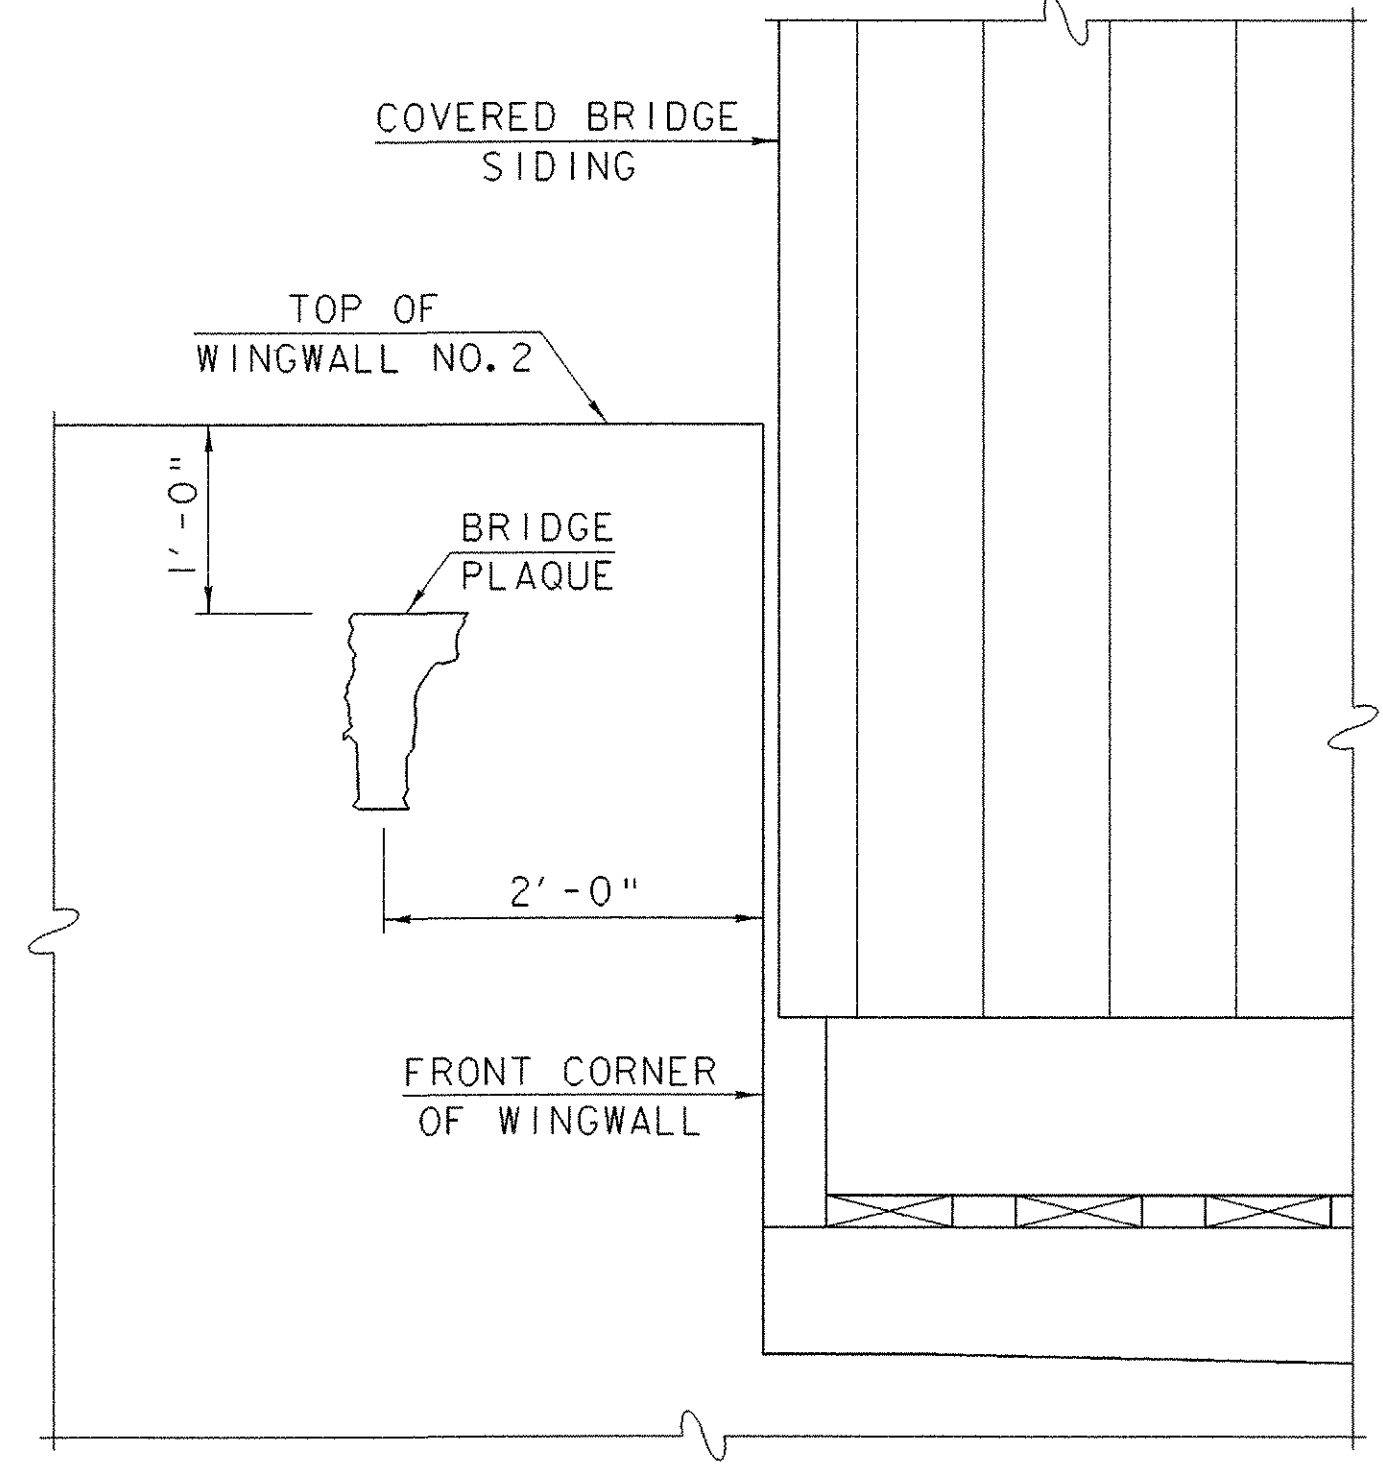

BRIDGE PLAQUE DETAIL
NOT TO SCALE

THE BRIDGE PLAQUE WILL BE SUPPLIED BY THE AGENCY OF TRANSPORTATION AND SHALL BE INSTALLED BY THE CONTRACTOR AS SHOWN OR AS DIRECTED BY THE ENGINEER.

MISCELLANEOUS PROJECT DETAILS

PROJECT NAME:	SALISBURY - CORNWALL
PROJECT NUMBER:	BHO 1445 (27)
FILE NAME:	96j268\Structures\sj268mpd.i
PROJECT MANAGER:	R. R. WHITCOMB
DESIGNED BY:	C. CARLSON
PLOT DATE:	02-APR-2007
DRAWN BY:	G. ROY
CHECKED BY:	CARLSON
SHEET	26 OF 60