



DOWNSTREAM (LEFT) TRUSS ELEVATION

(VIEWED FROM INSIDE)
 1 0 1 2 3 4 5 6
 SCALE: 3/16" = 1'-0"

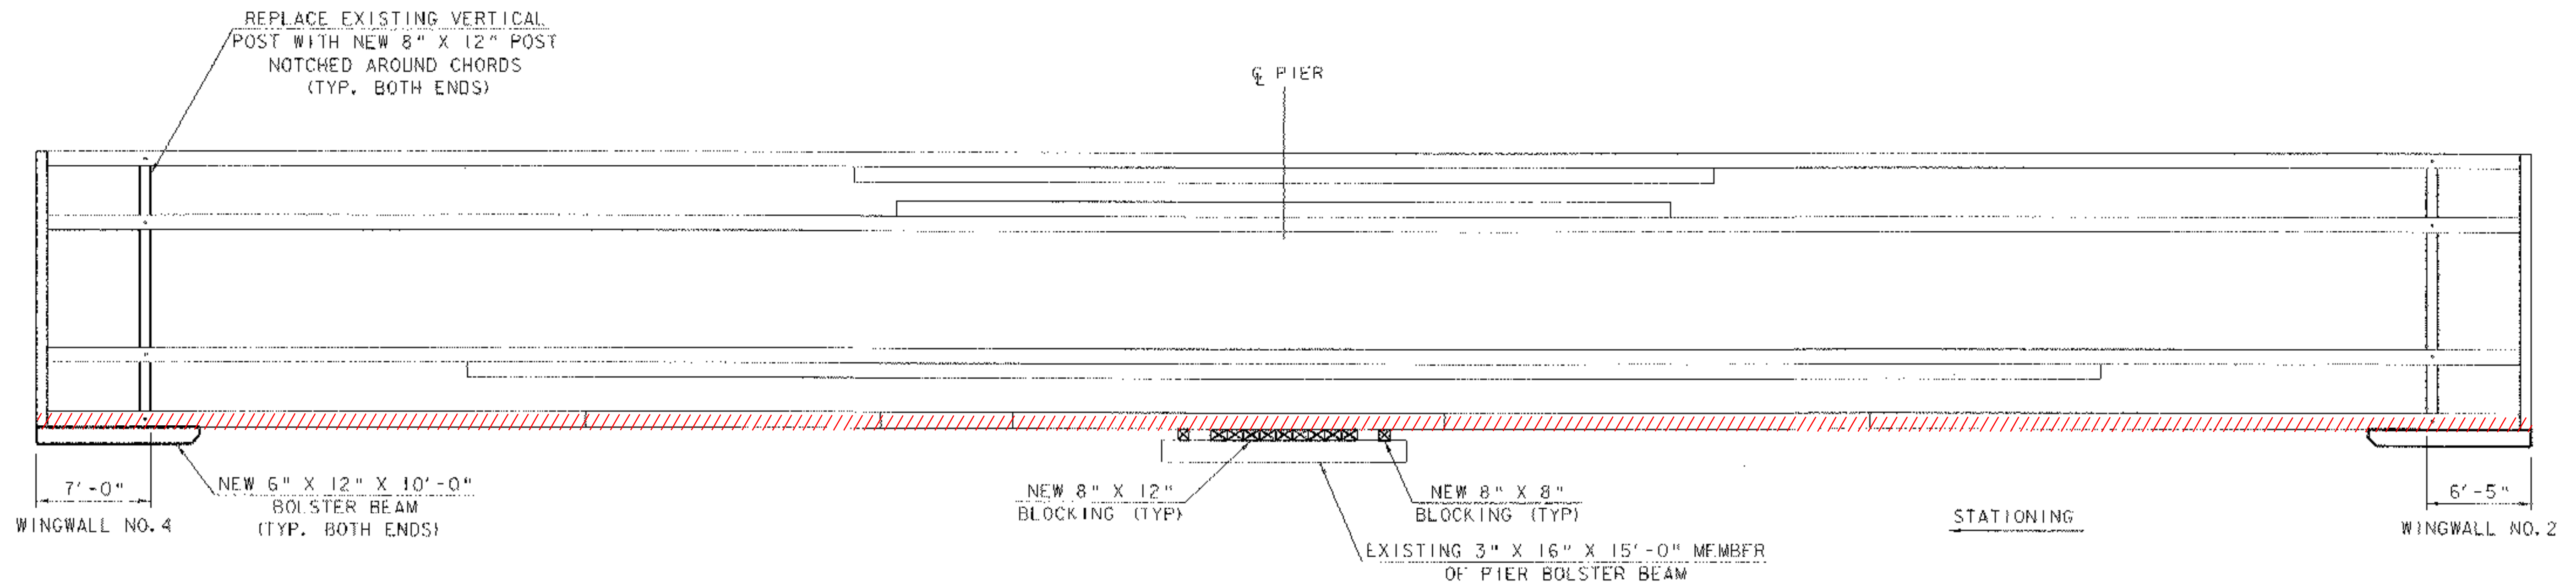

UPSTREAM (RIGHT) TRUSS ELEVATION

(VIEWED FROM INSIDE)
 1 0 1 2 3 4 5 6
 SCALE: 3/16" = 1'-0"

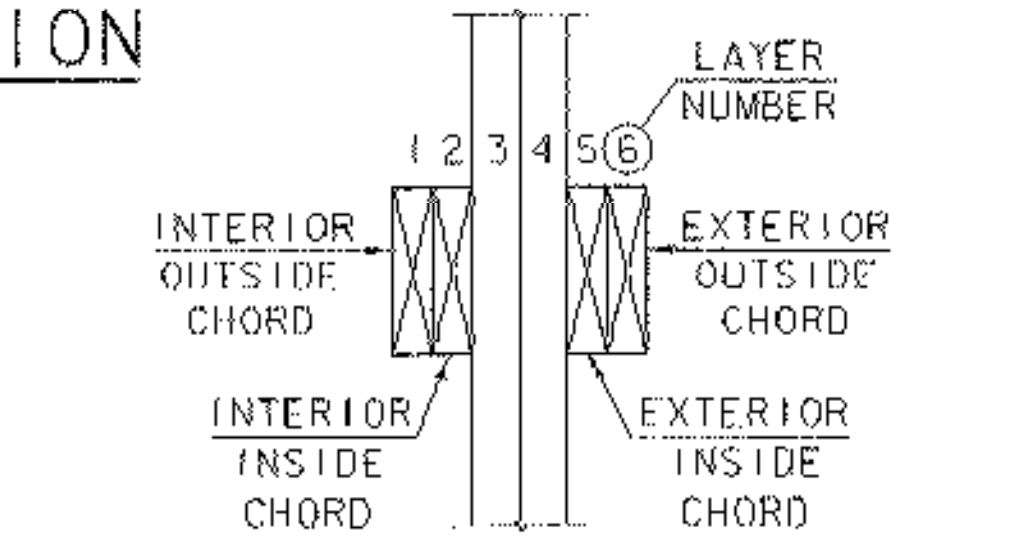

TRUSS LAYER LEGEND

TRUSS REPAIR - LAYER 6

PROJECT NAME:	SALISBURY - CORNWALL	FILE NAME:	961268\Structures\sj268+16.l	PLOT DATE:	02-APR-2007
PROJECT NUMBER:	BHO 1445 (27)	PROJECT MANAGER:	R.R. WHITCOMB	DRAWN BY:	G. ROY
		DESIGNED BY:	C. CARLSON	CHECKED BY:	C. CARLSON
				SHEET	33 OF 60