

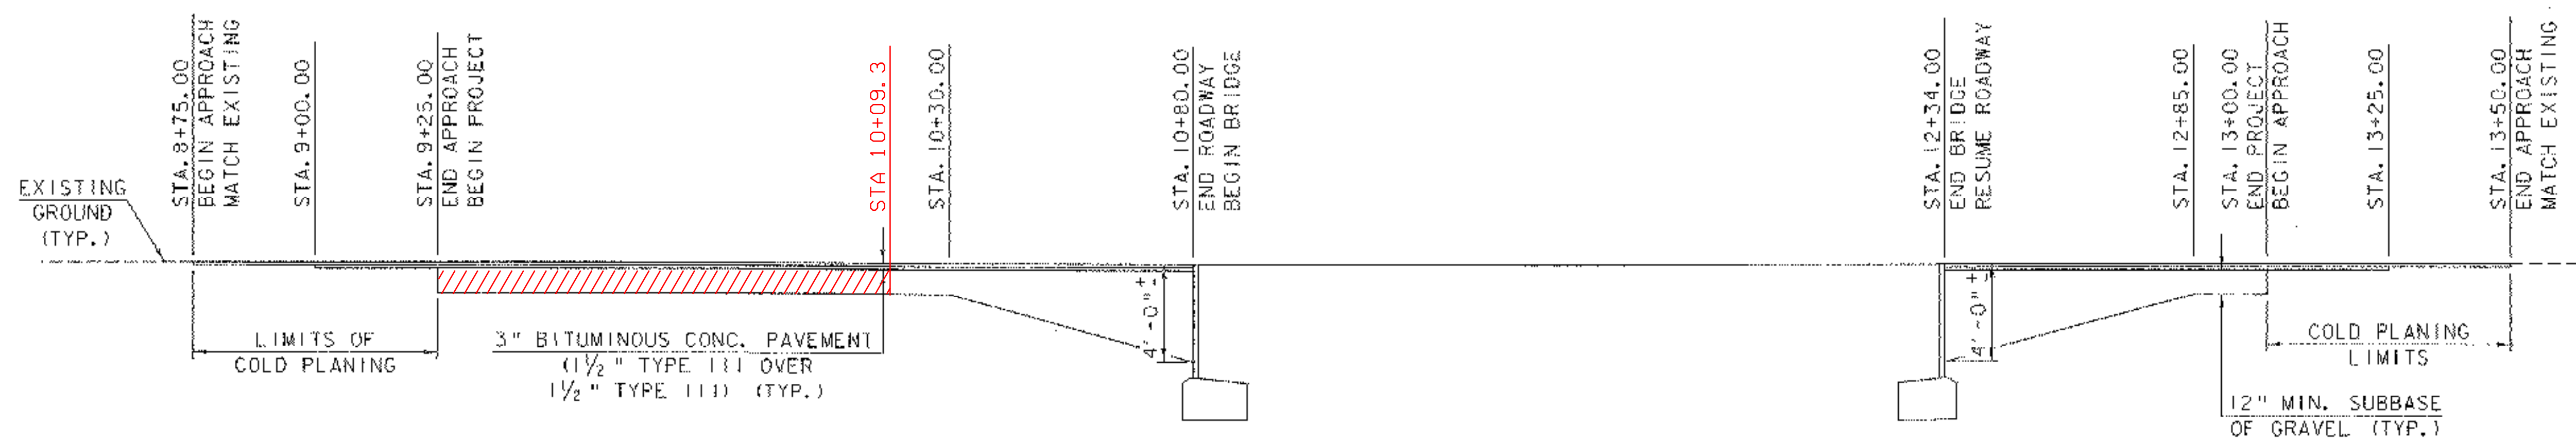


**BANKING DIAGRAM**

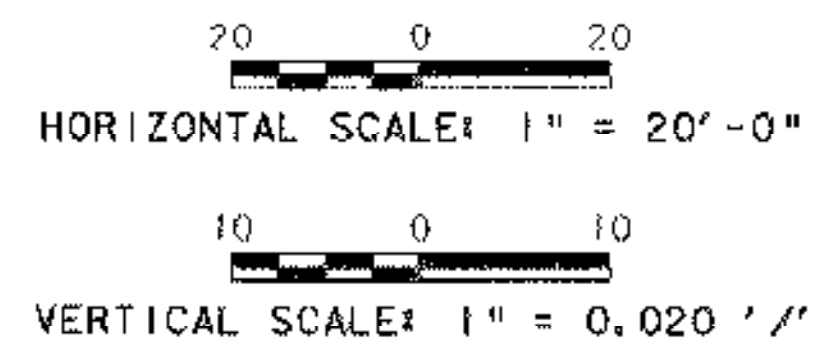

**MATERIAL TRANSITION DETAIL**

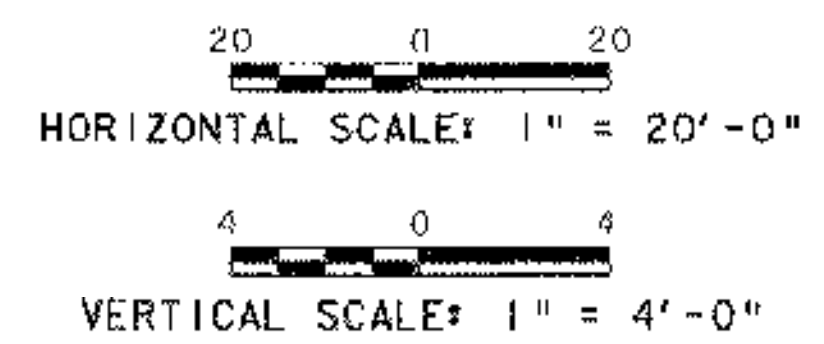

**BANKING DIAGRAM & MATERIAL TRANSITION DETAIL**

PROJECT NAME:	SALISBURY - CORNWALL		
PROJECT NUMBER:	BHO 1445 (27)		
FILE NAME:	96J268\Structures\sj268b.dmt.d	DATE:	02-APR-2007
PROJECT MANAGER:	R. R. WHITCOMB	DRAWN BY:	G. ROY
DESIGNED BY:	G. ROY	CHECKED BY:	C. CARLSON
			SHEET 48 OF 60