



9+00

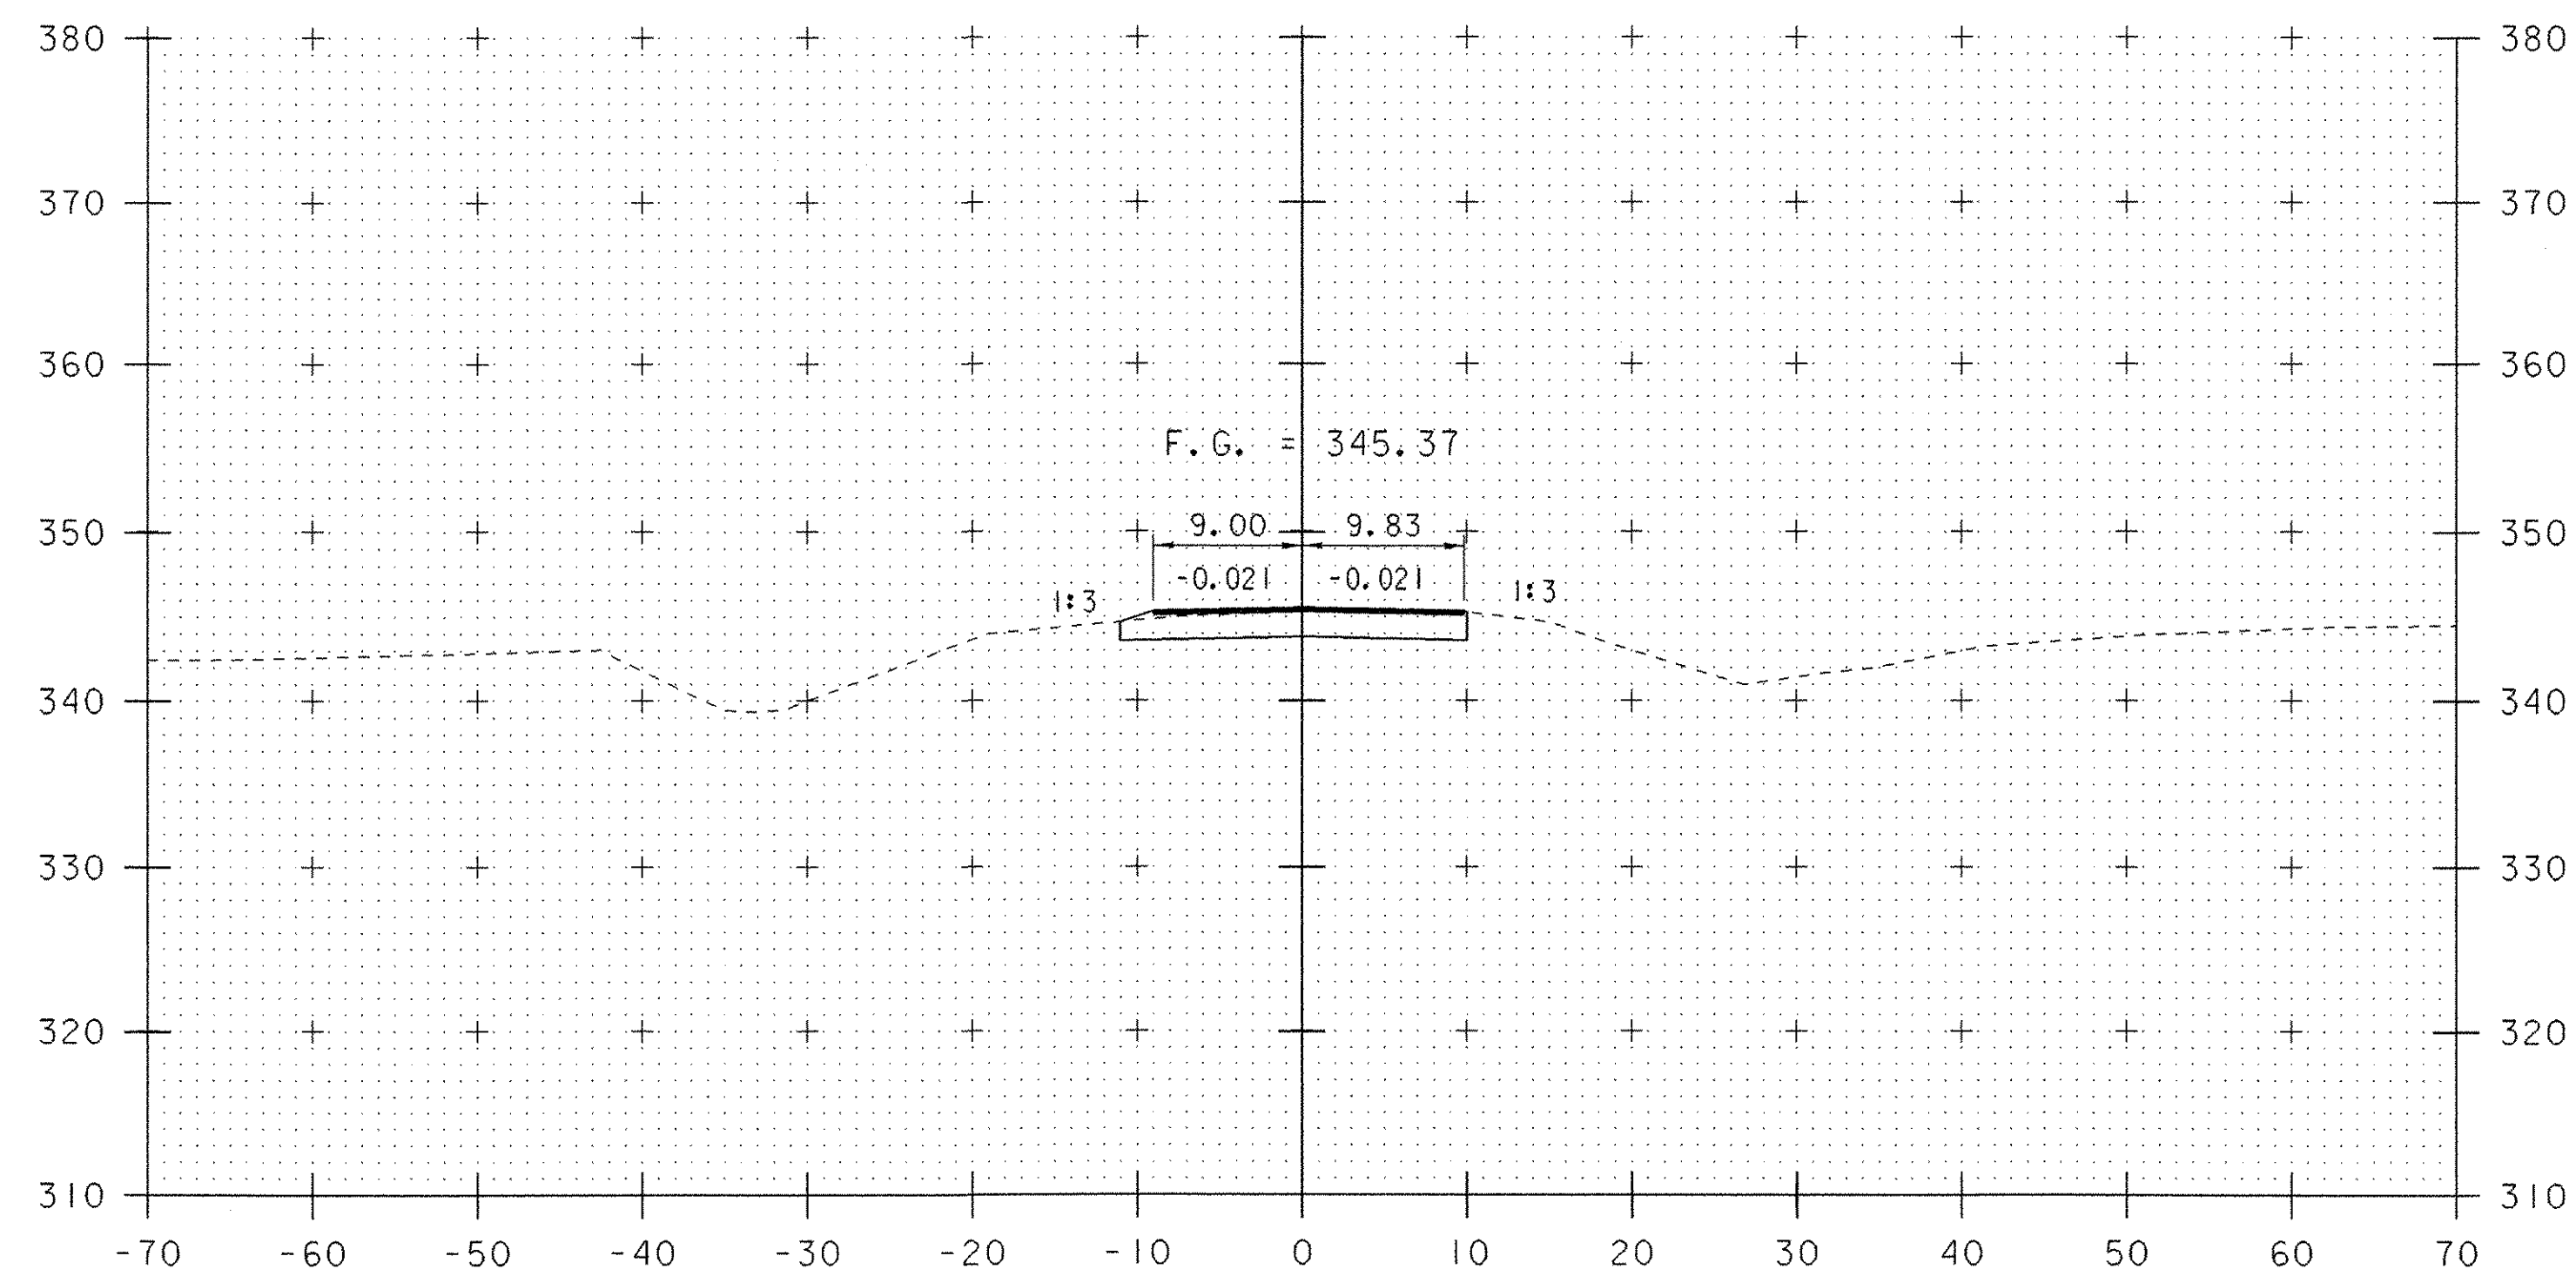


9+50

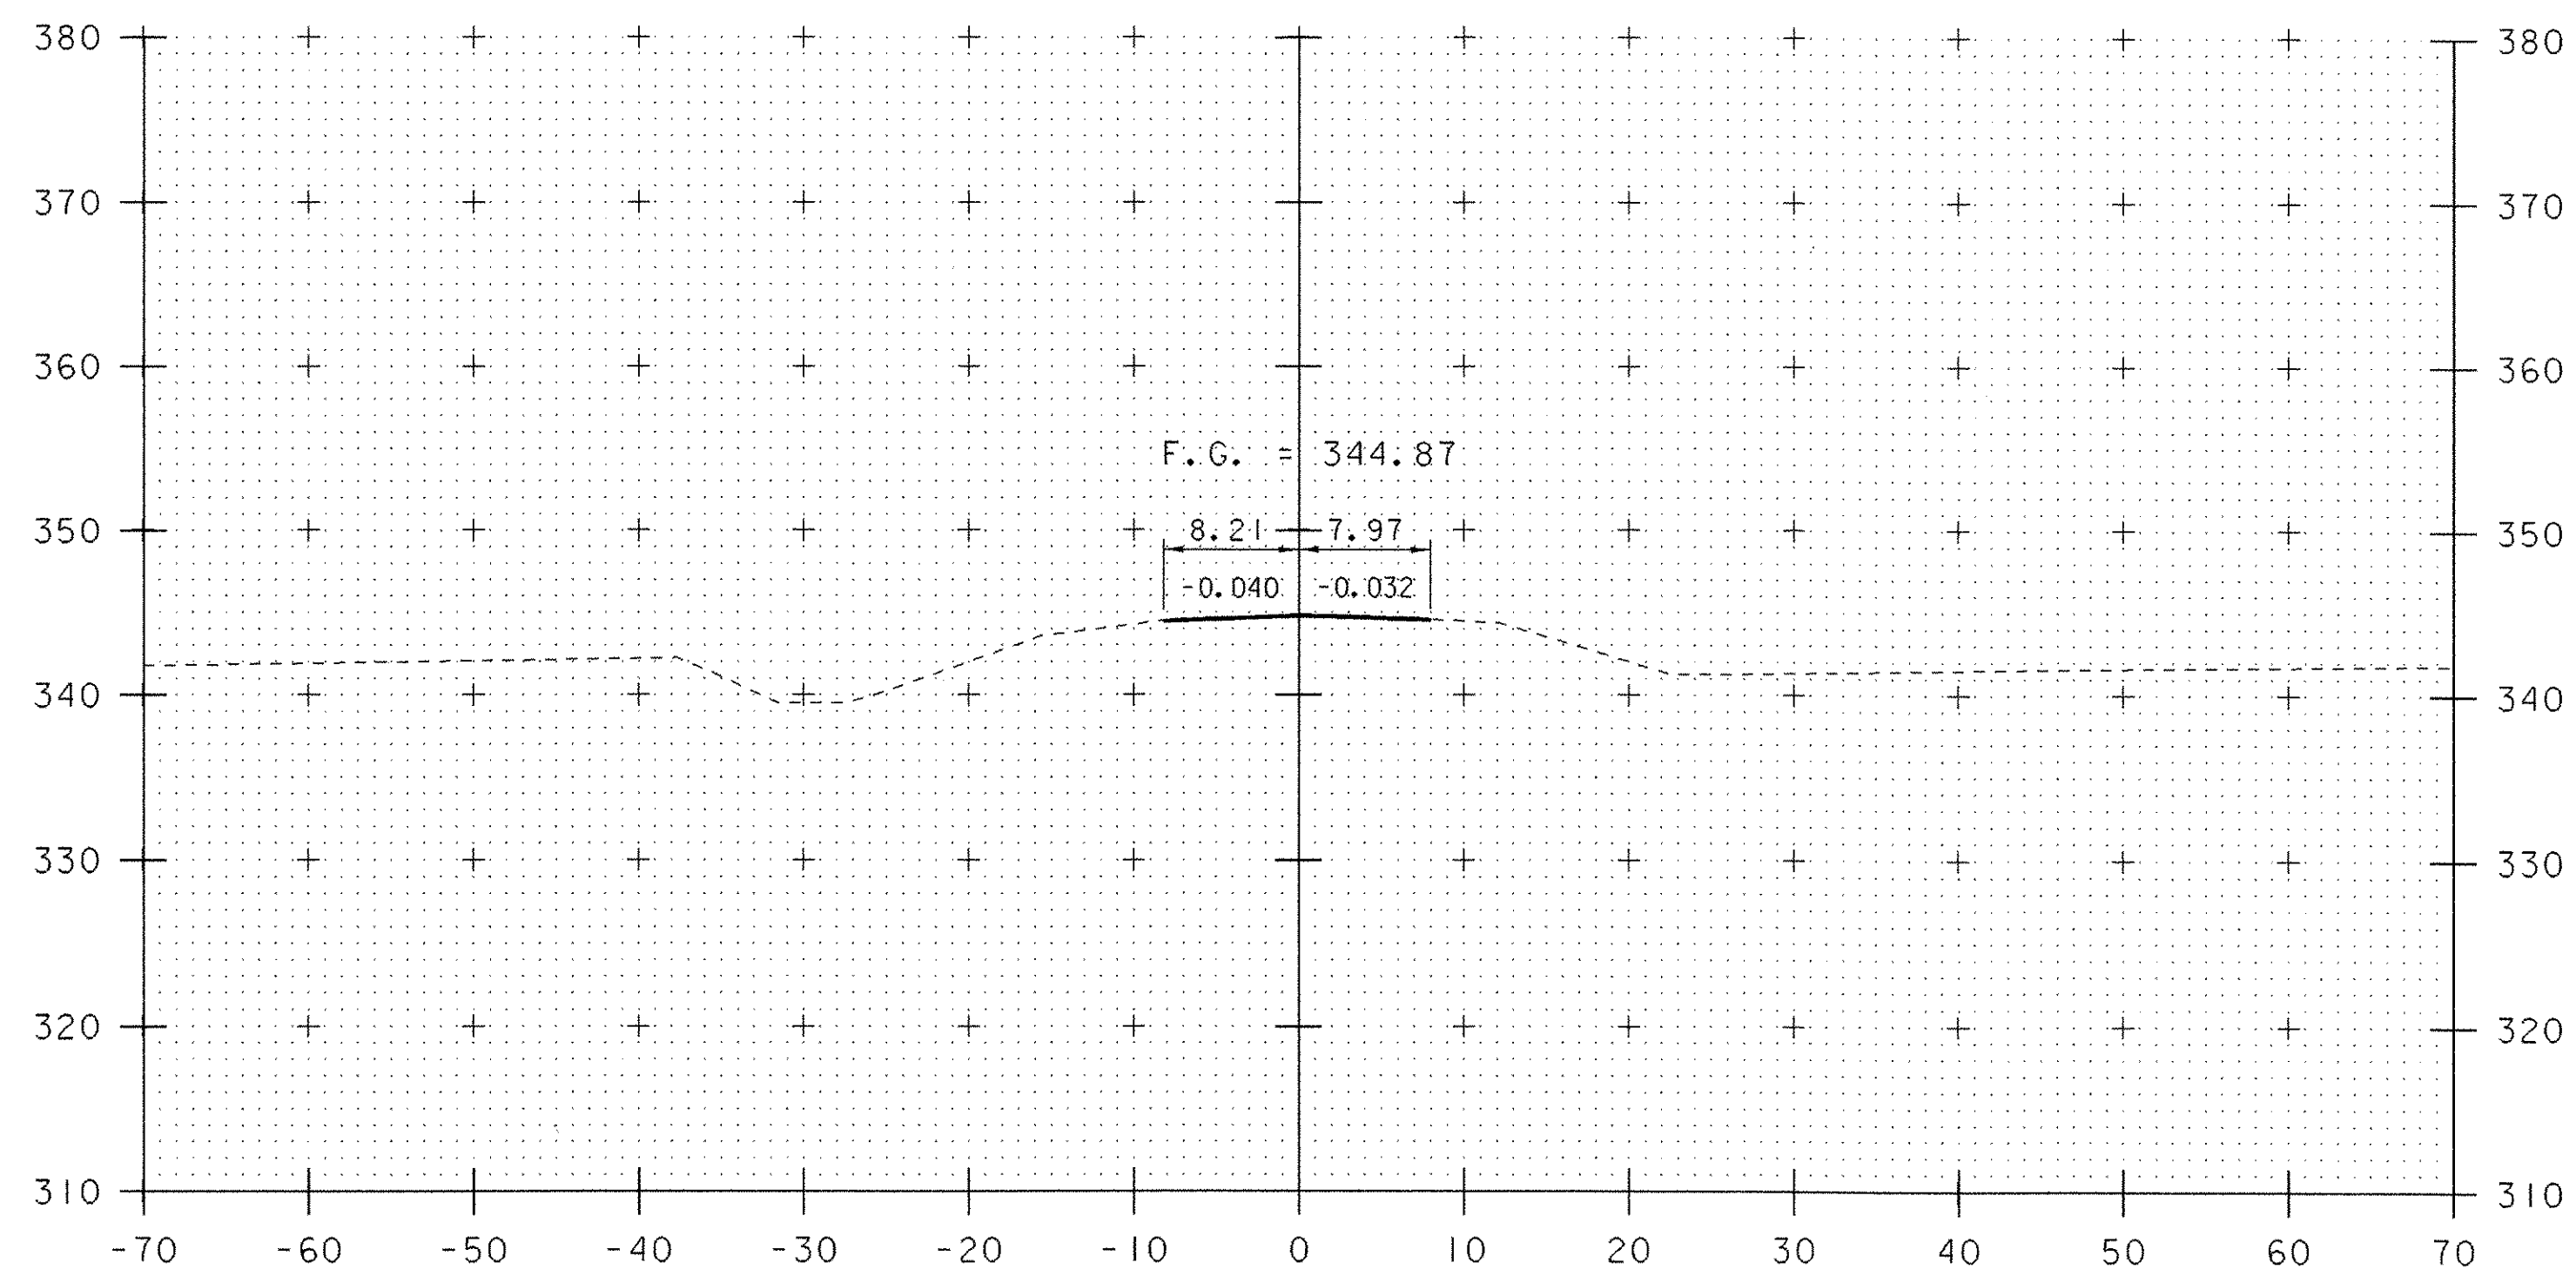

8+75


STA. 8+75.00
BEGIN APPROACH
MATCH EXISTING

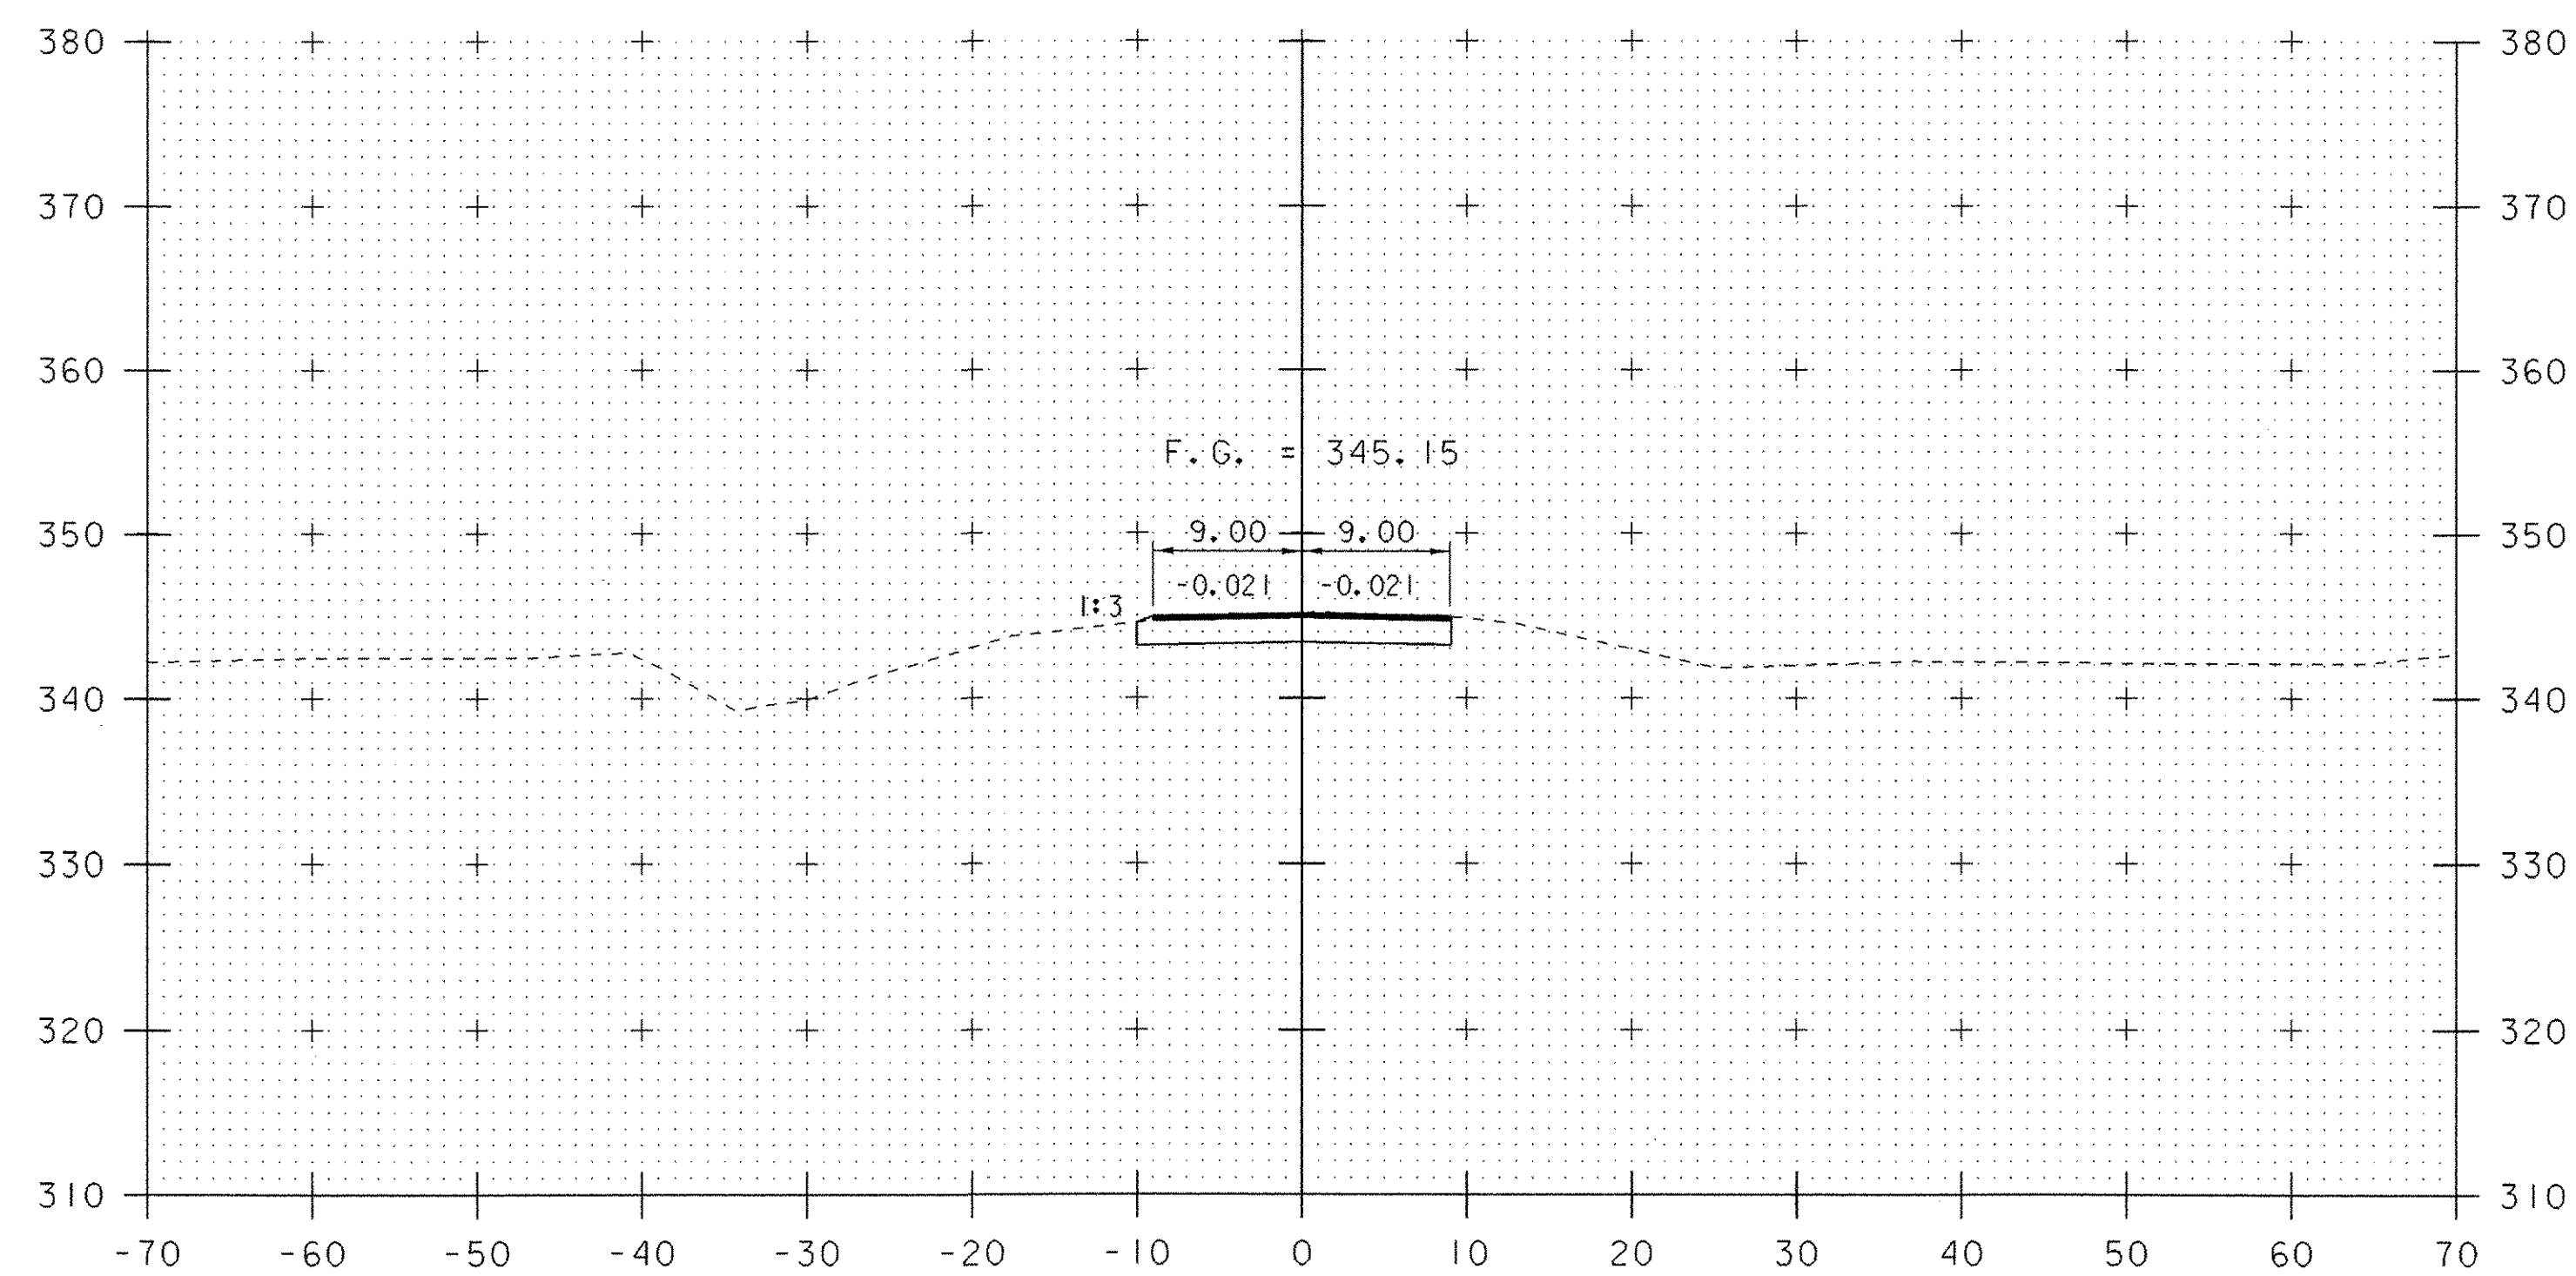

9+25

STA. 9+25.00
END APPROACH
BEGIN PROJECT

ROADWAY CROSS SECTIONS (1)

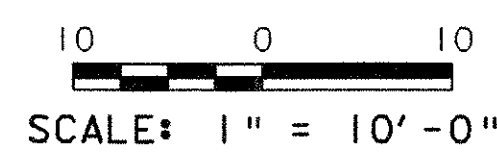

PROJECT NAME: SALISBURY - CORNWALL	PLOT DATE: 02-APR-2007
PROJECT NUMBER: BHO 1445 (27)	DRAWN BY: G. ROY
FILE NAME: 96j268\Structures\sj268m01.i	CHECKED BY: C. CARLSON
PROJECT MANAGER: R. R. WHITCOMB	SHEET 49 OF 60
DESIGNED BY: G. ROY	
STA. 8+75 - STA. 9+50	