



STA. 10+04.3 LT.
CONSTRUCT DRIVE

10+00


STA. 9+94.4 RT.
CONSTRUCT DRIVE

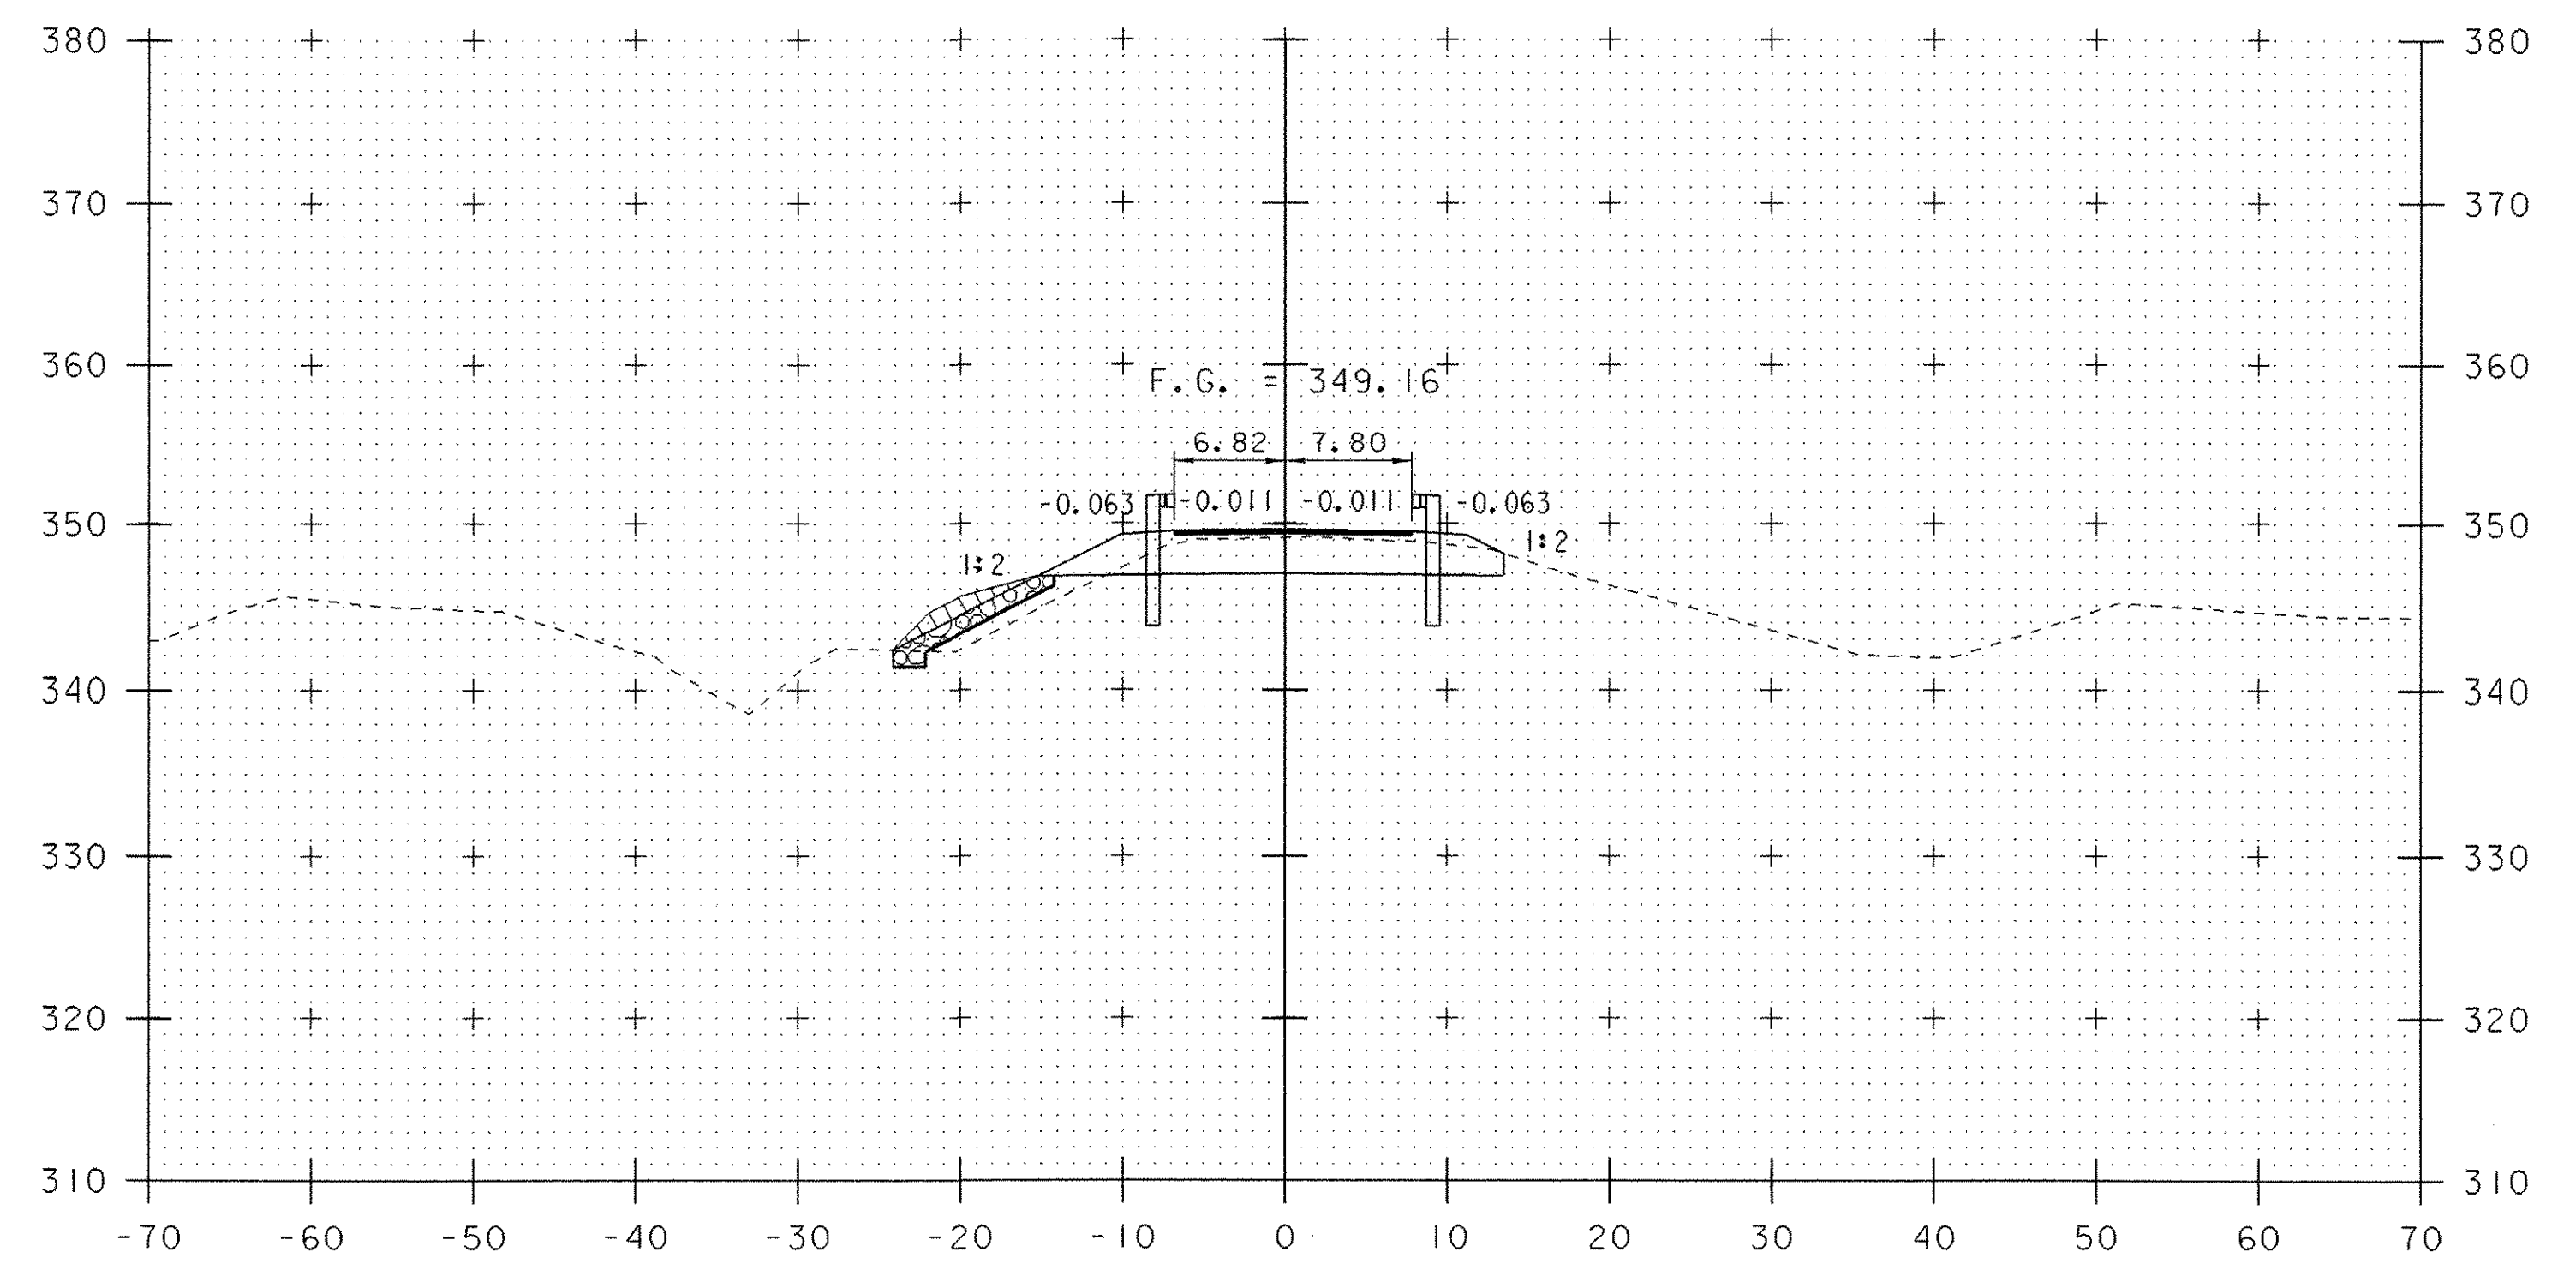

10+50

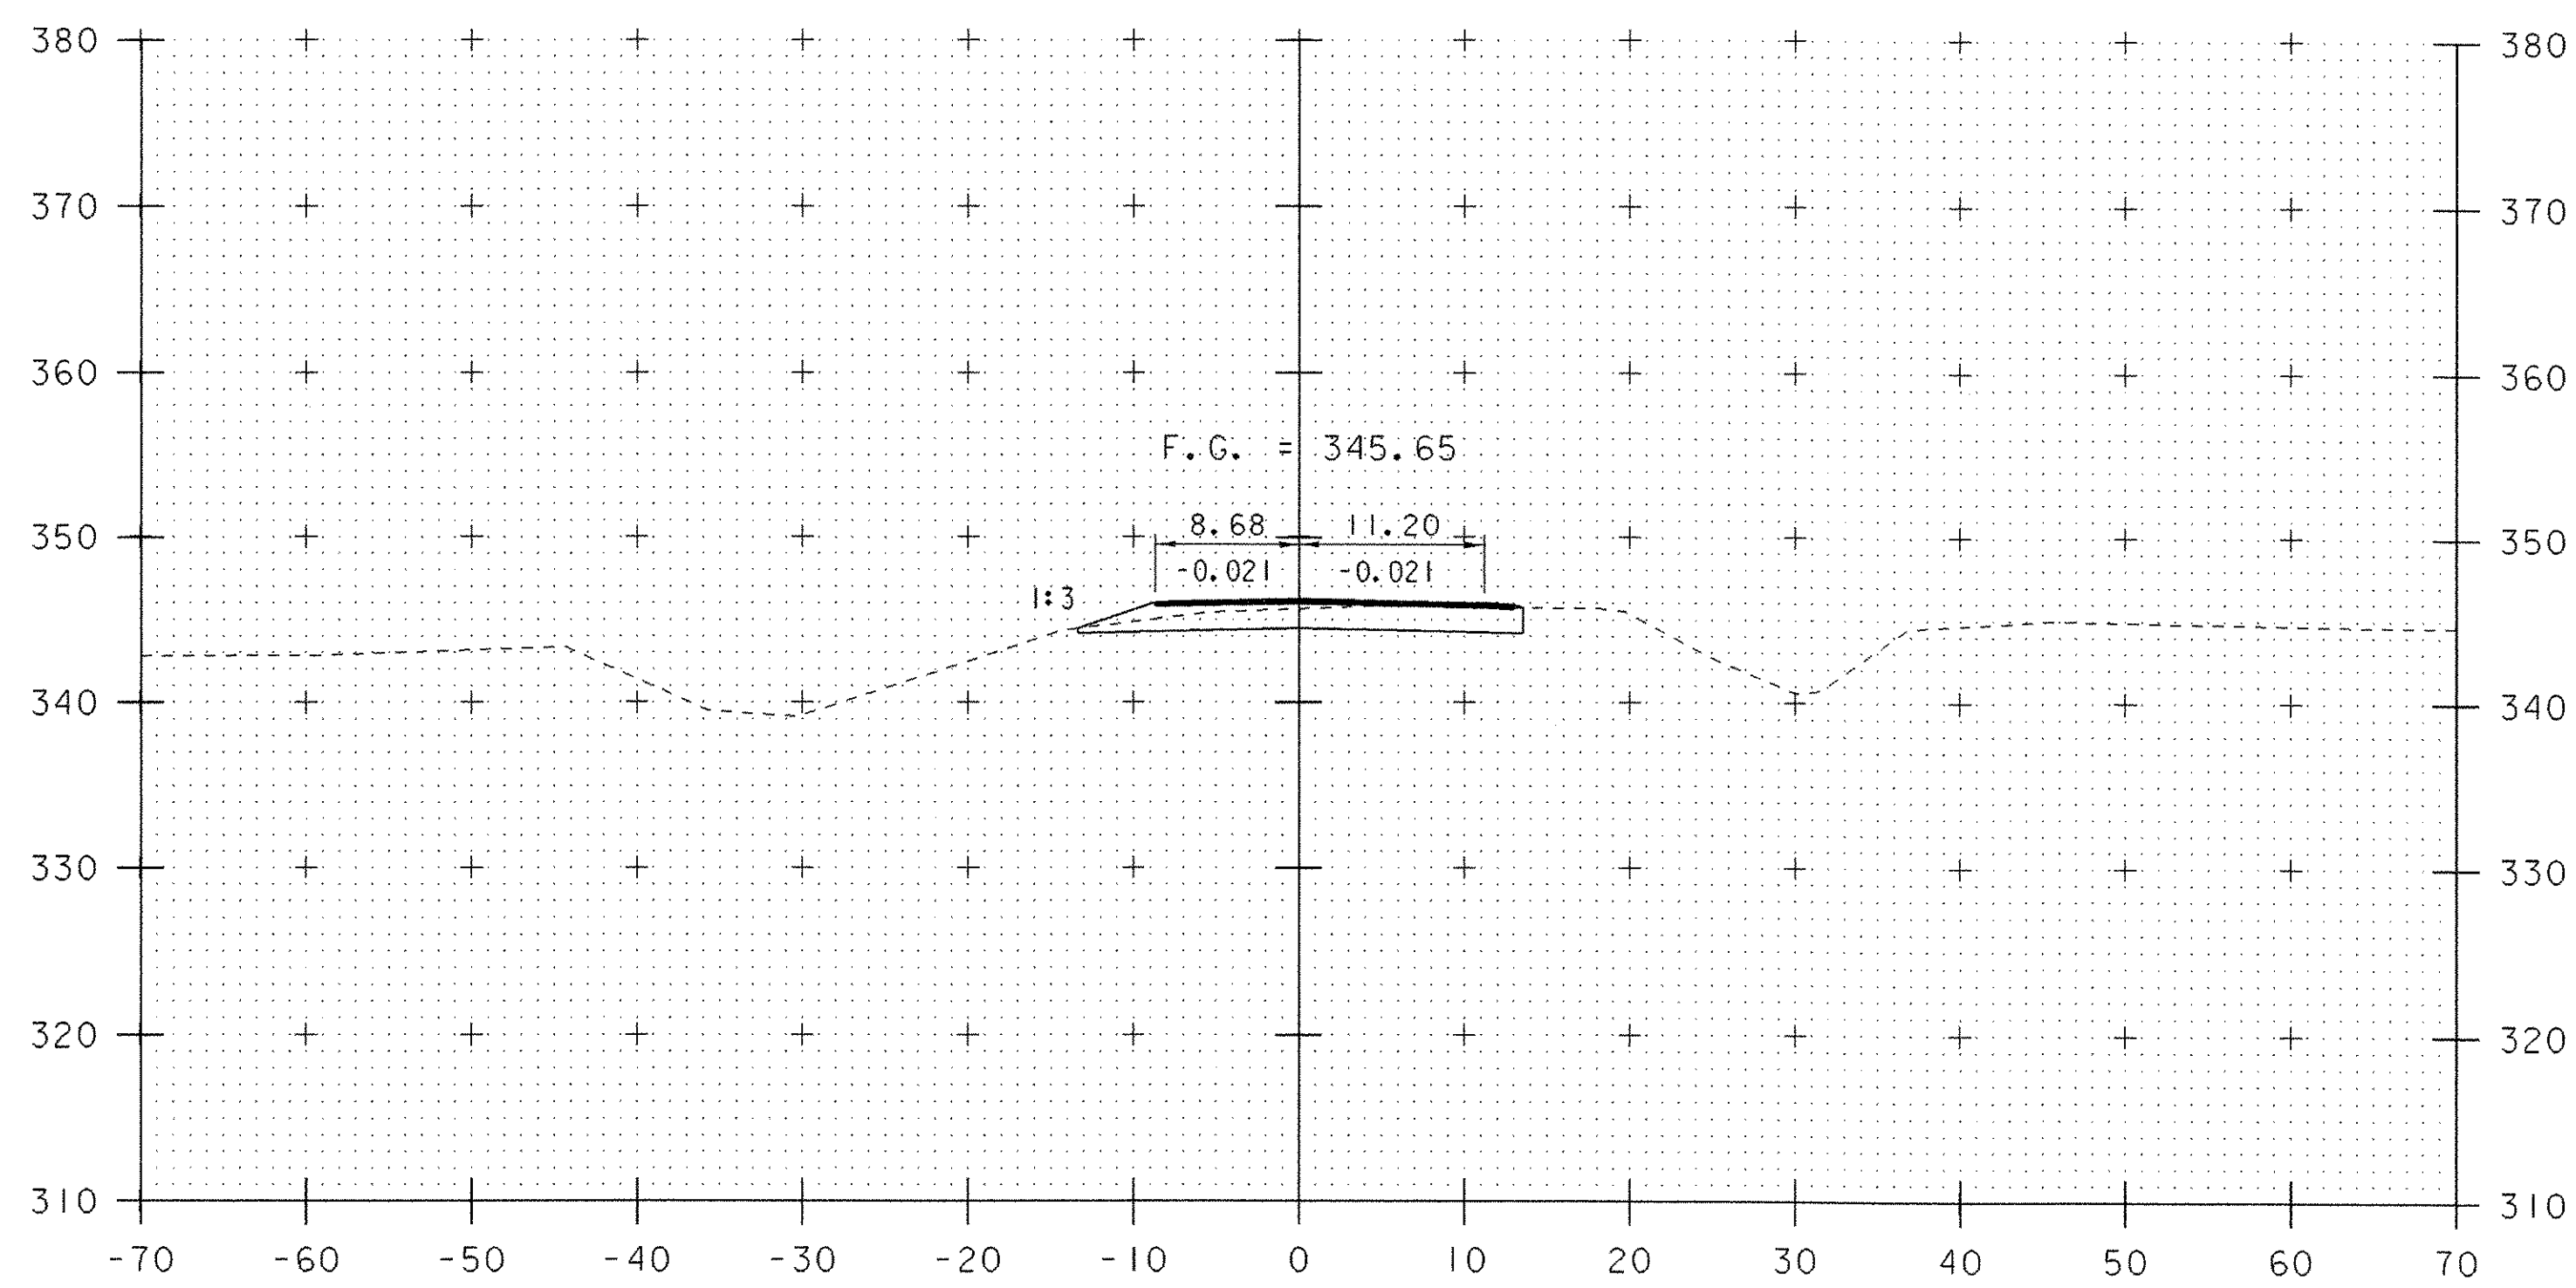


9+75

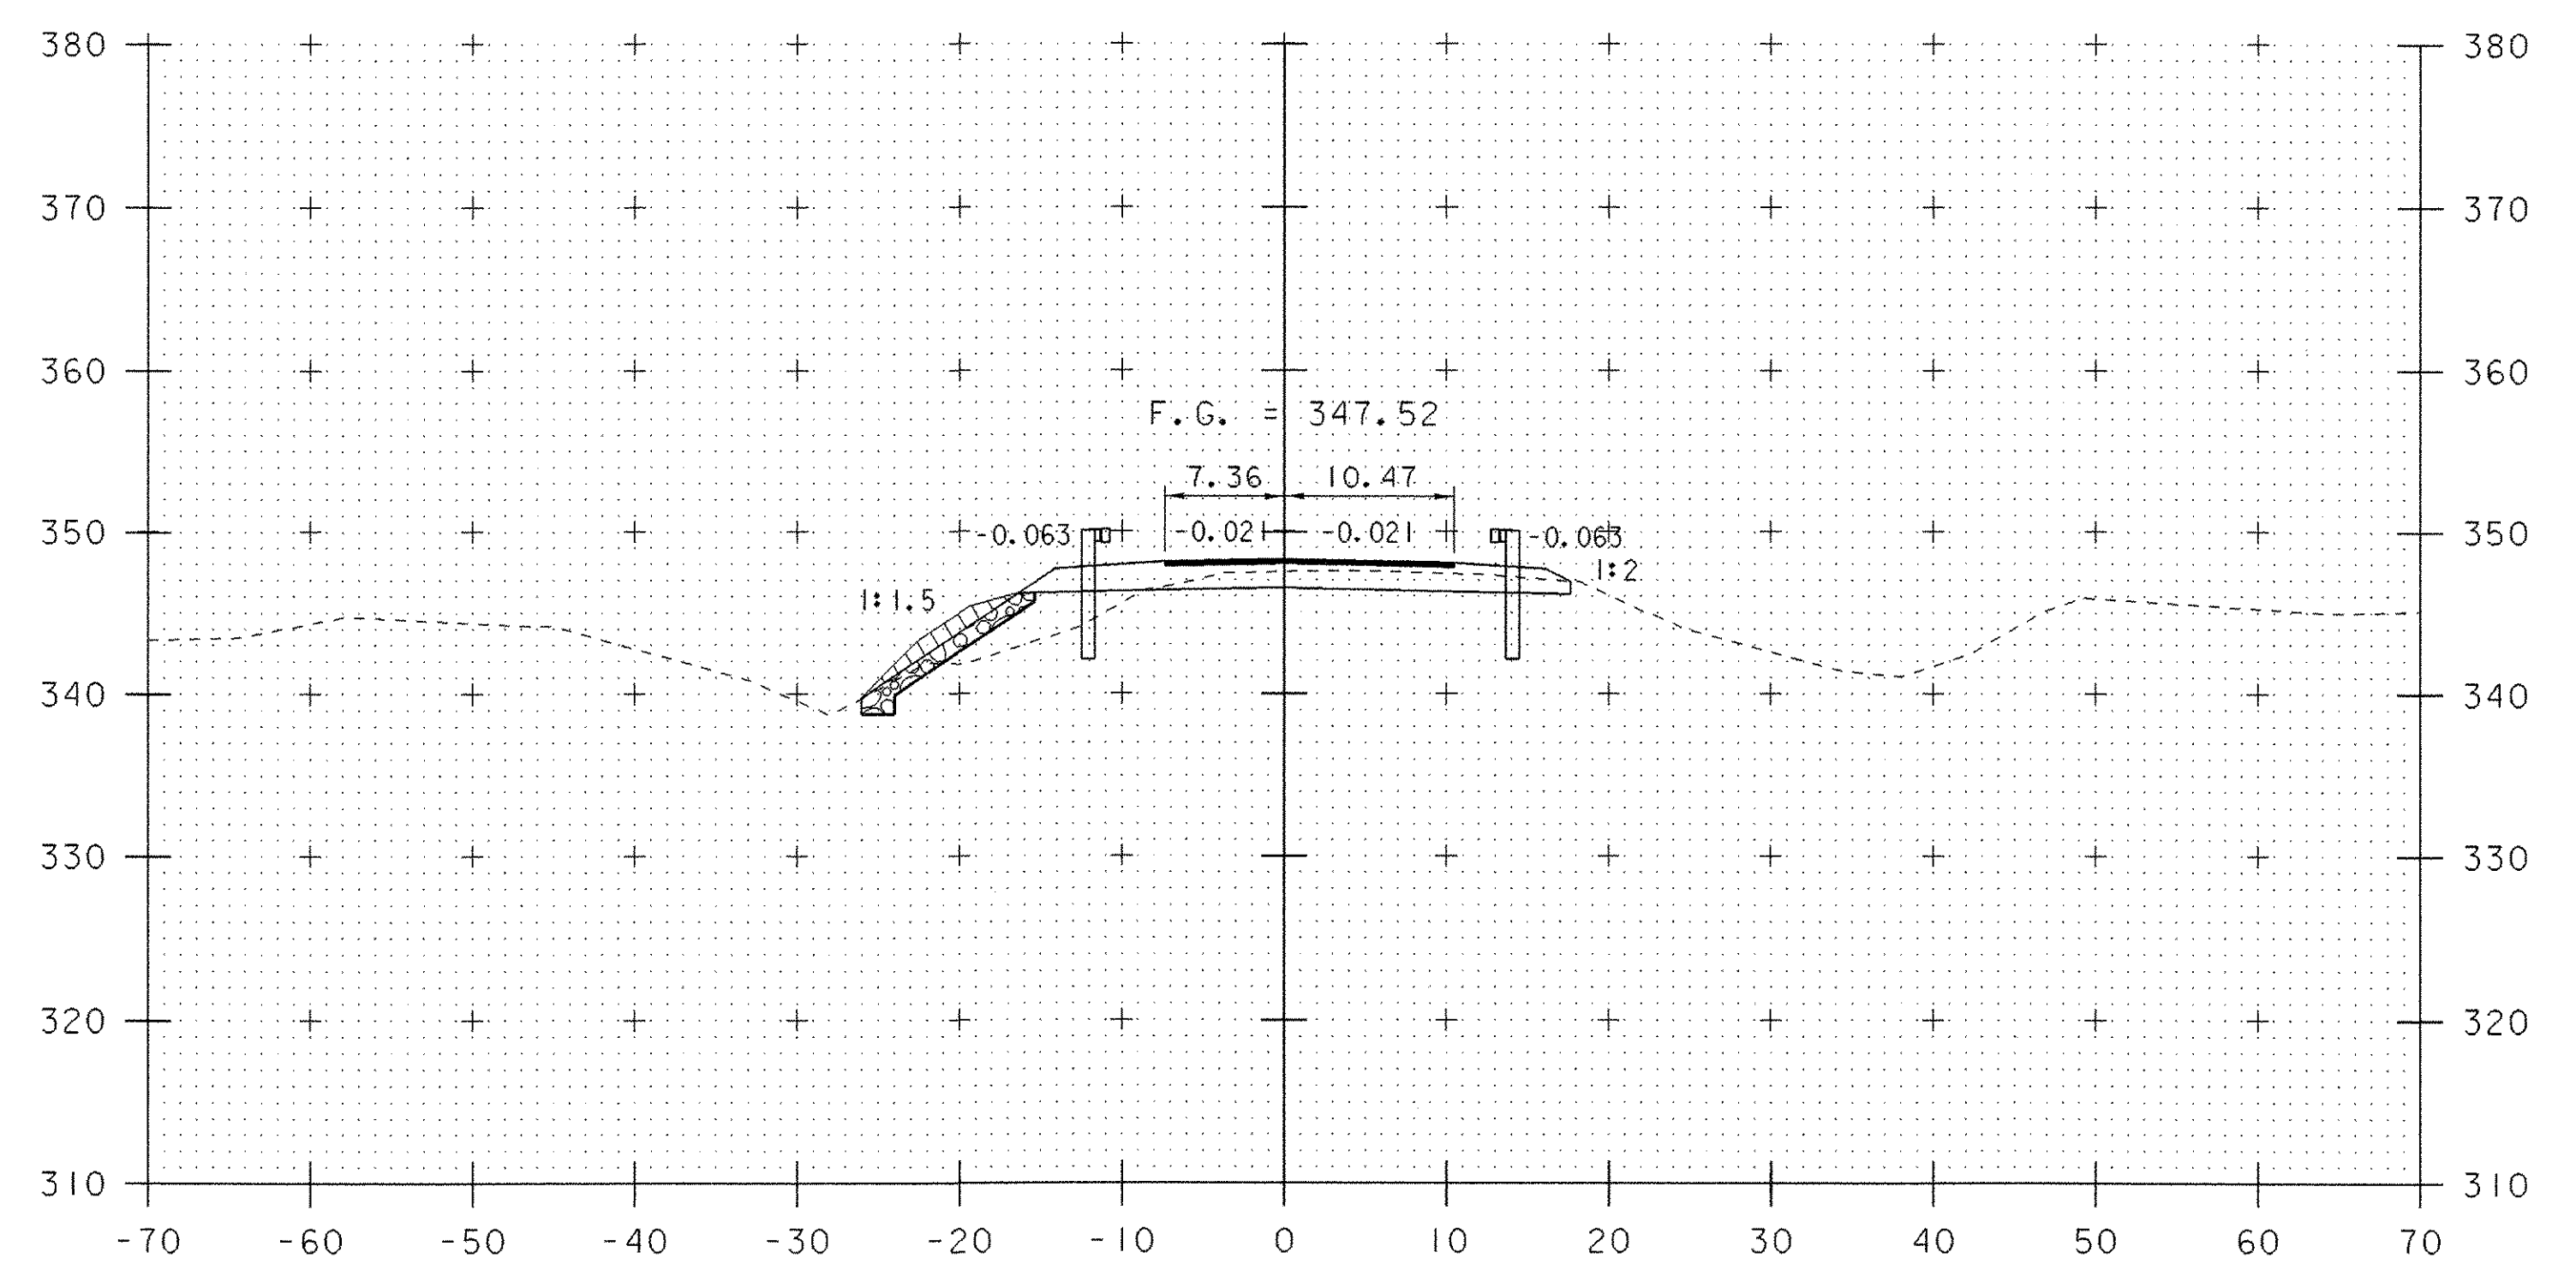

10+25

STA. 10+09.3 LT.
BEGIN STONE FILL, TYPE I SLOPE

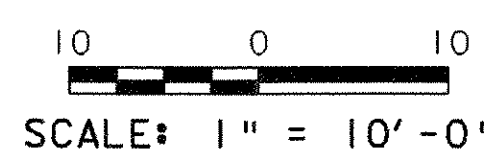

ROADWAY CROSS SECTIONS (2)

PROJECT NAME:	SALISBURY - CORNWALL
PROJECT NUMBER:	BHO 1445 (27)
FILE NAME:	96j268\Structures\sj268m02.1
PROJECT MANAGER:	R. R. WHITCOMB
DESIGNED BY:	G. ROY
STA. 9+75 - STA. 10+50	
PLOT DATE:	02-APR-2007
DRAWN BY:	G. ROY
CHECKED BY:	C. CARLSON
SHEET	50 OF 60