


CHANNEL STA. 6+09.1 LT.  
 END STRUCTURE EXCAVATION  
 GRANULAR BACKFILL FOR STRUCTURES

6+10

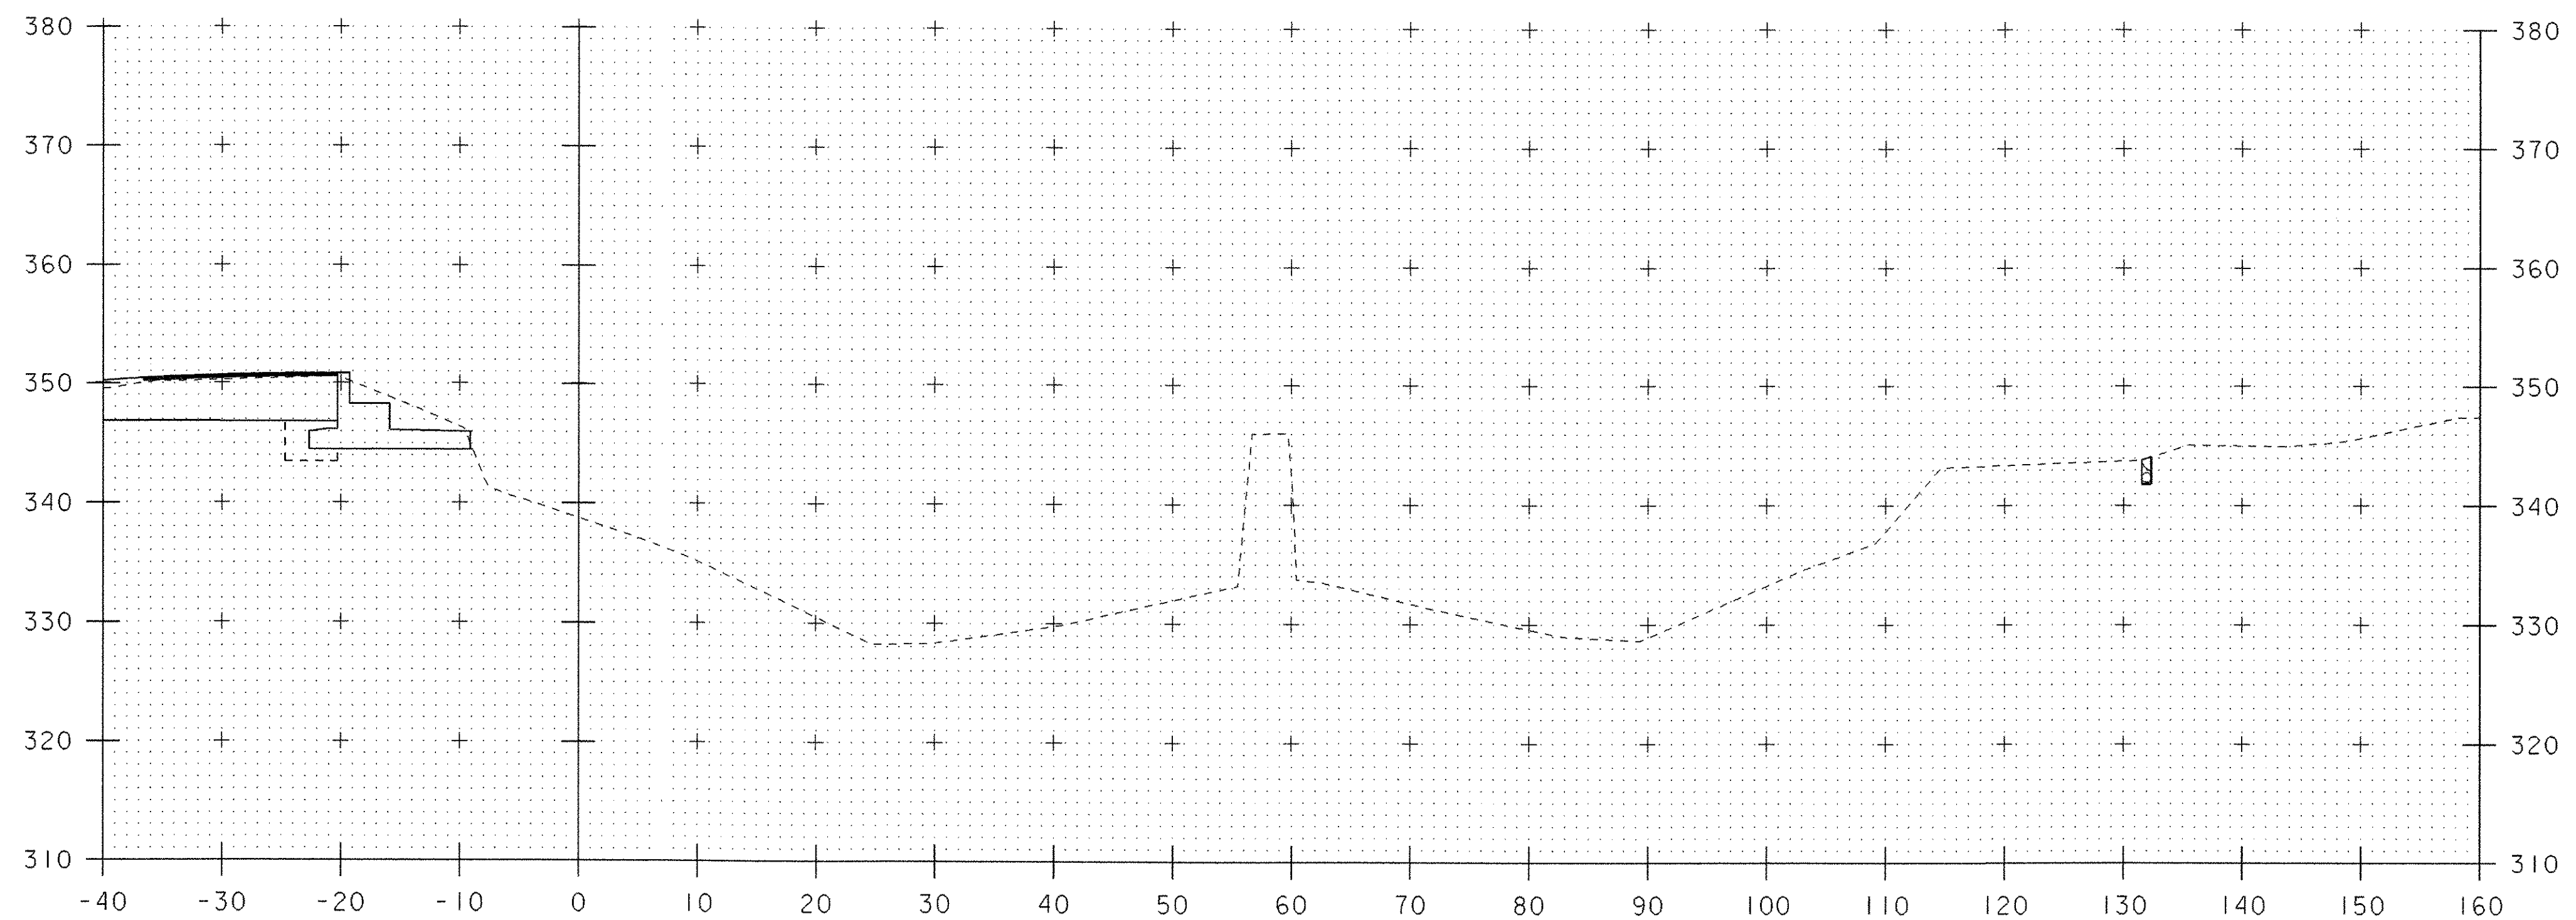

CHANNEL STA. 5+99.5 RT.  
 BEGIN UNCLASS. CHANNEL EXCAVATION  
 GEOTEXTILE UNDER STONE FILL  
 STONE FILL, TYPE II  
 GRUBBING MATERIAL

6+00

10 0 10  
 SCALE: 1" = 10'-0"

CHANNEL CROSS SECTIONS (2)

PROJECT NAME:	SALISBURY - CORNWALL	FILE NAME:	96j268\Structures\sj268c02.i	PLOT DATE:	02-APR-2007
PROJECT NUMBER:	BHO 1445 (27)	PROJECT MANAGER:	R. R. WHITCOMB	DRAWN BY:	G. ROY
		DESIGNED BY:	G. ROY	CHECKED BY:	C. CARLSON
		STA. 6+00 - STA. 6+10		SHEET	54 OF 60