


6+30


CHANNEL STA. 6+21.1 LT.
 END UNCLASS. CHANNEL EXCAVATION
 GEOTEXTILE UNDER STONE FILL
 STONE FILL, TYPE II
 GRUBBING MATERIAL

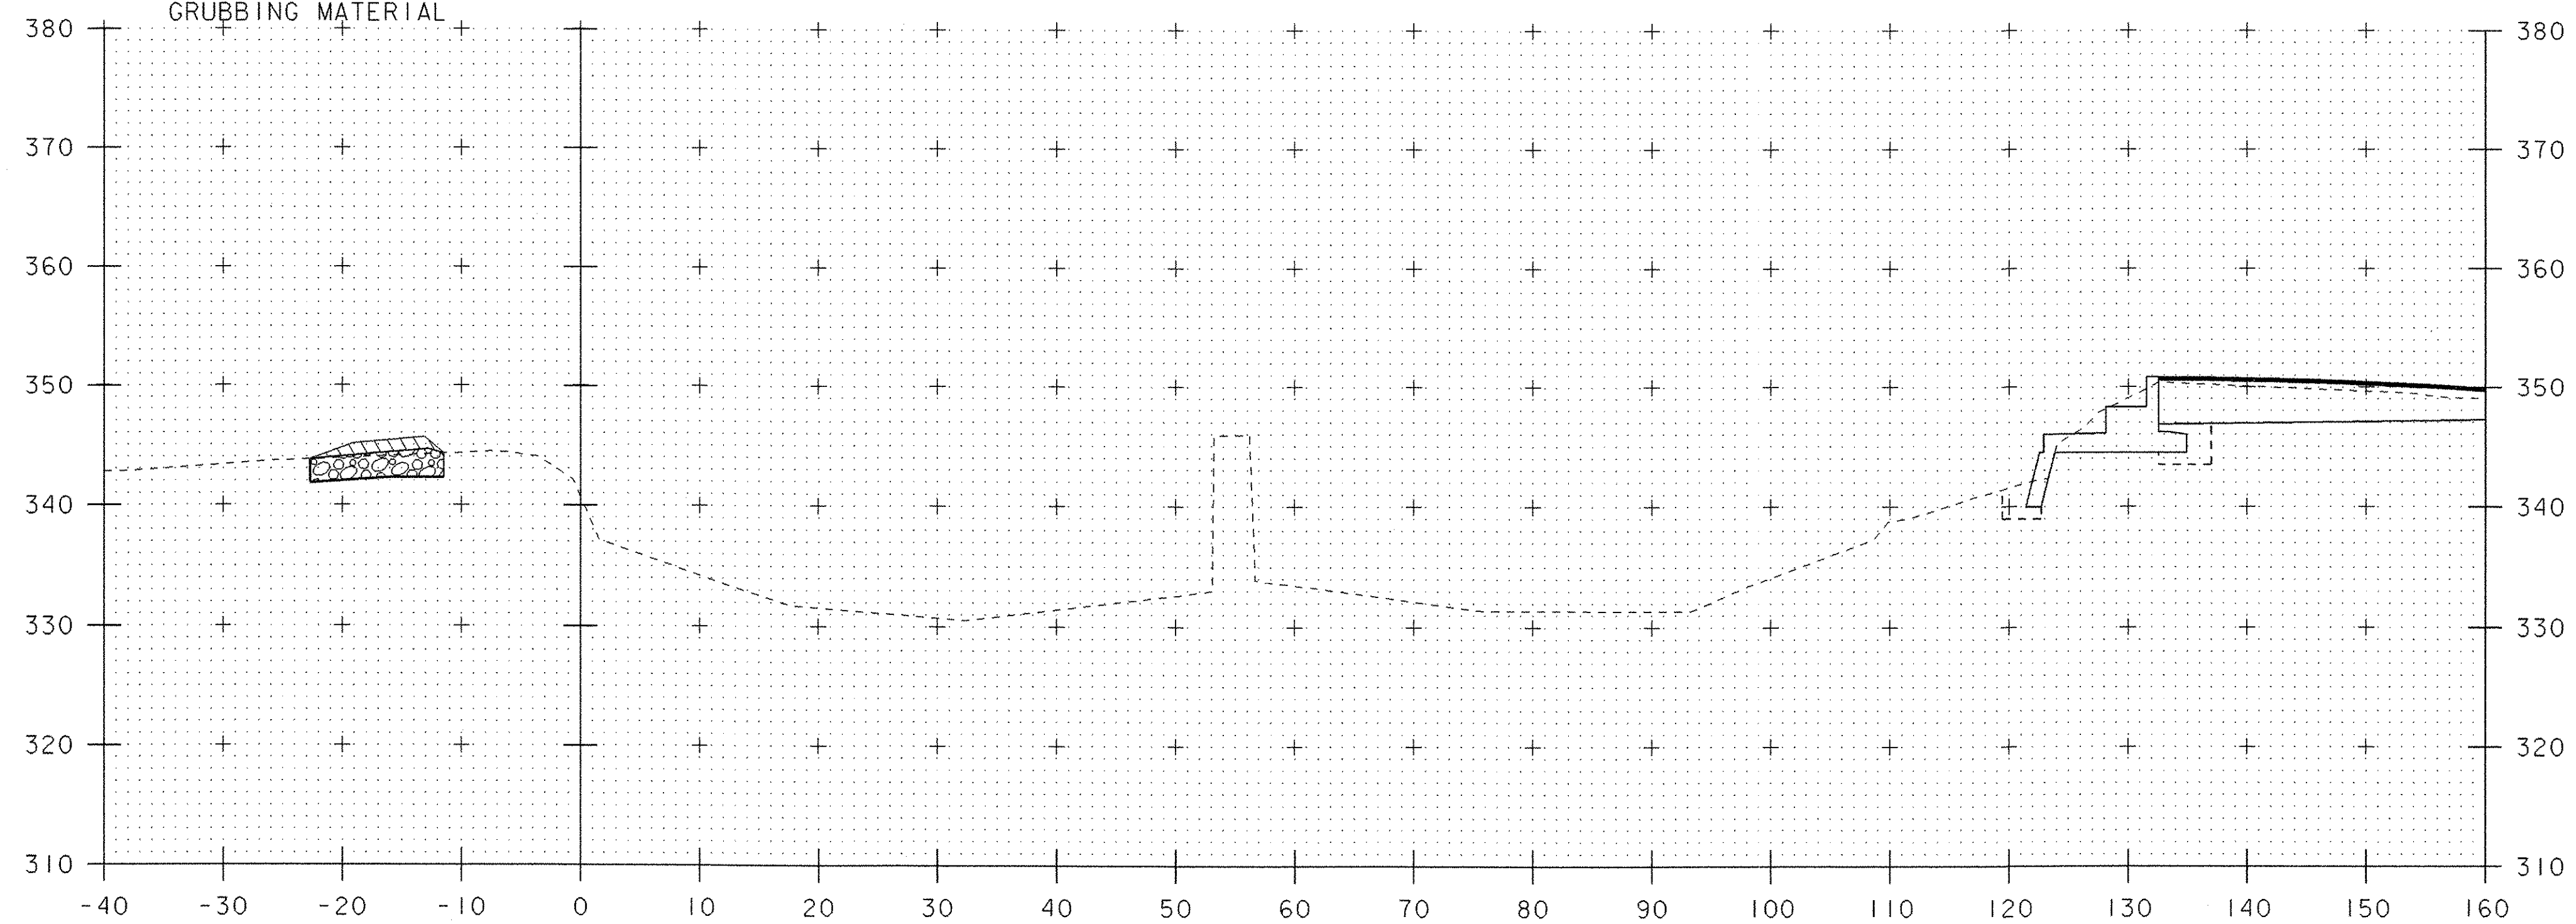

6+20

CHANNEL STA. 6+11.0 RT.
 BEGIN STRUCTURE EXCAVATION
 GRANULAR BACKFILL FOR STRUCTURES

CHANNEL CROSS SECTIONS (3)

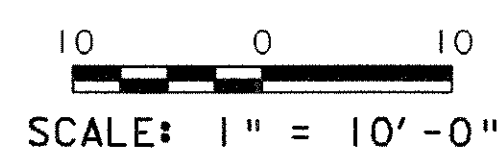

PROJECT NAME:	SALISBURY - CORNWALL	PLOT DATE:	02-APR-2007
PROJECT NUMBER:	BHO 1445 (27)	DRAWN BY:	G. ROY
FILE NAME:	96j268\Structures\sj268c03.i	CHECKED BY:	C. CARLSON
PROJECT MANAGER:	R. R. WHITCOMB	SHEET	55 OF 60
DESIGNED BY:	G. ROY		
STA. 6+20 - STA. 6+30			