


6+50


CHANNEL STA. 6+46.3 RT.  
 END UNCLASS. CHANNEL EXCAVATION  
 GEOTEXTILE UNDER STONE FILL  
 STONE FILL, TYPE II  
 GRUBBING MATERIAL

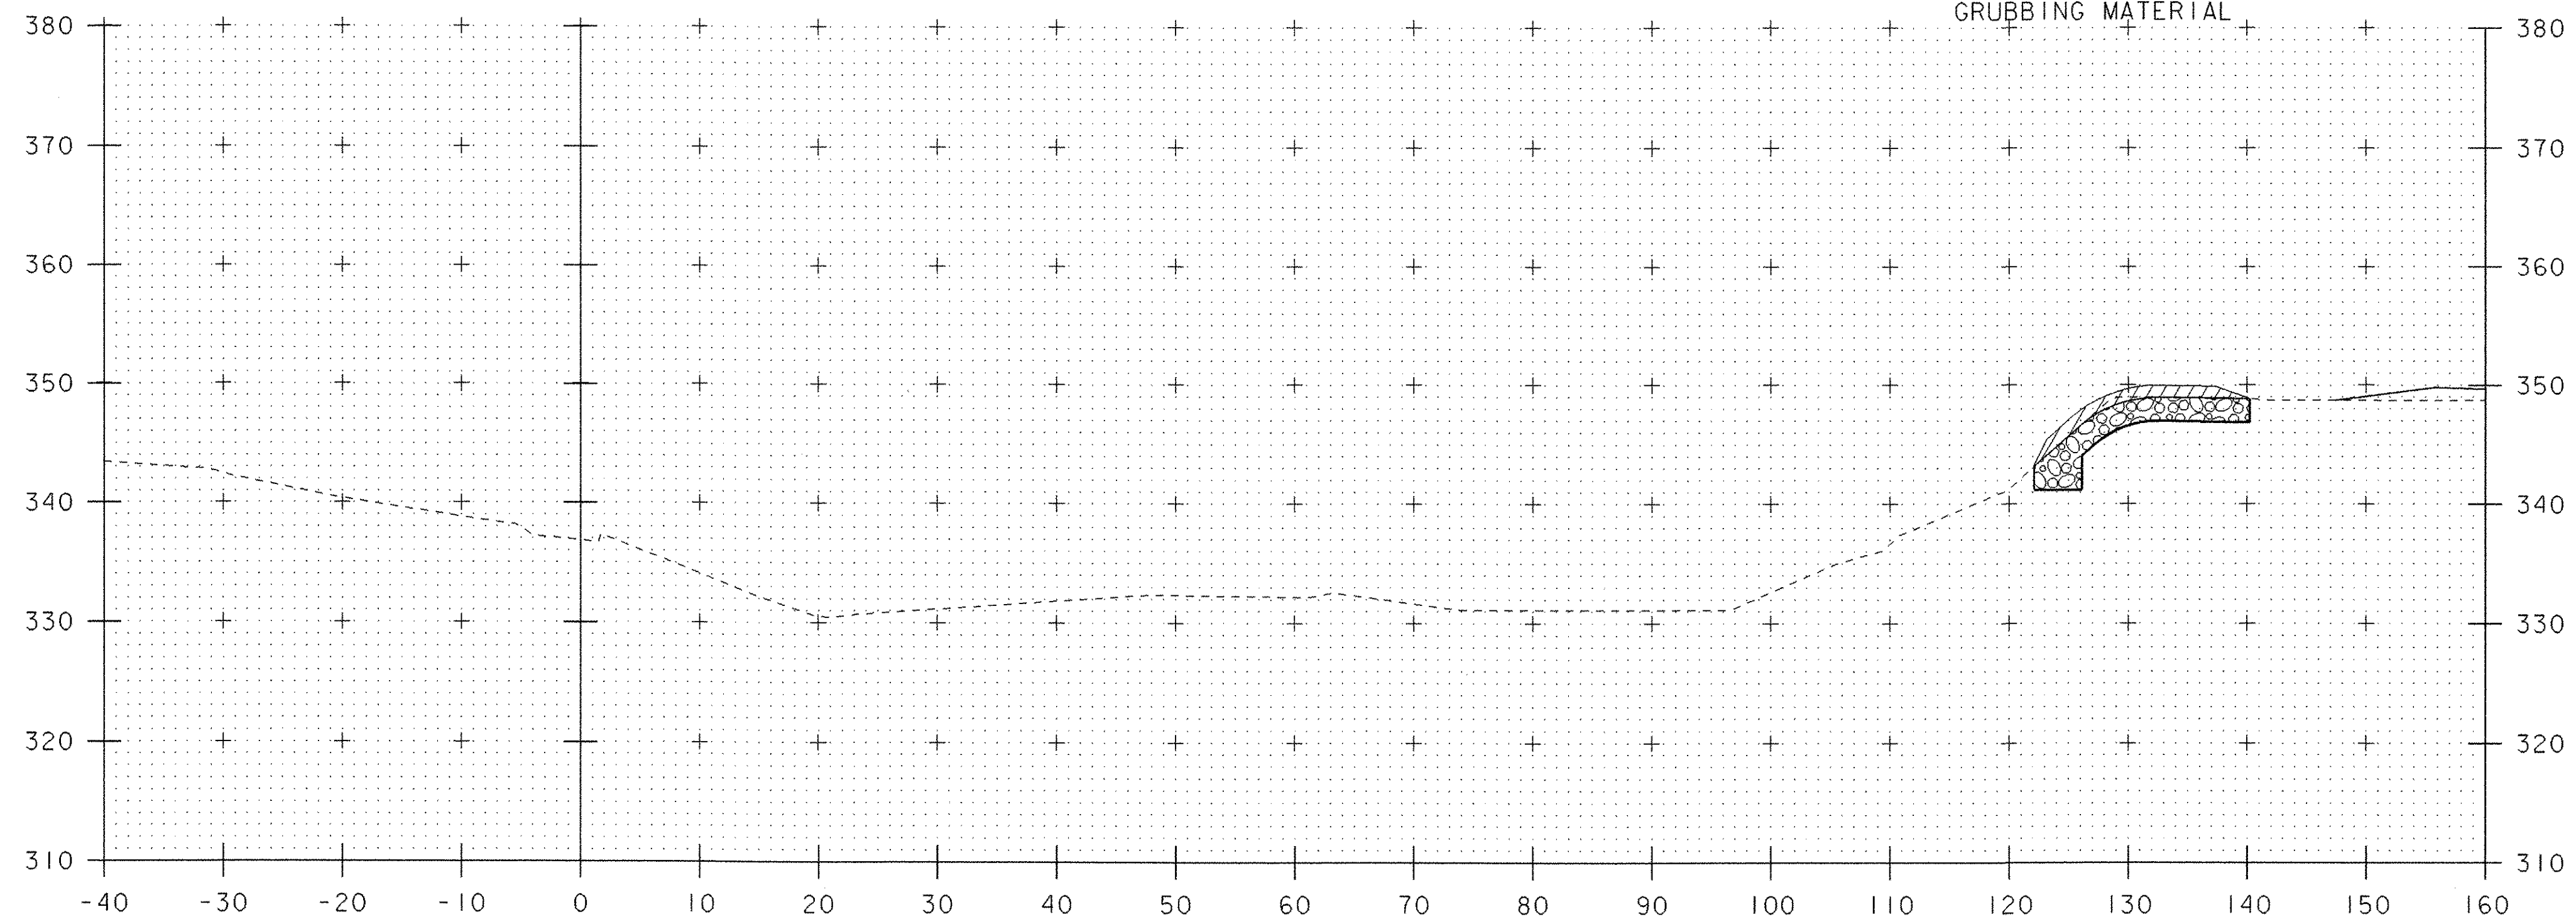

6+40

CHANNEL STA. 6+37.6 RT.  
 END STRUCTURE EXCAVATION  
 GRANULAR BACKFILL FOR STRUCTURES

CHANNEL CROSS SECTIONS (4)

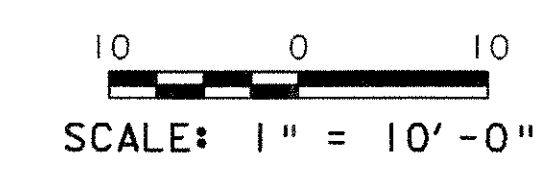

PROJECT NAME:	SALISBURY - CORNWALL	PLOT DATE:	02-APR-2007
PROJECT NUMBER:	BHO 1445 (27)	DRAWN BY:	G. ROY
FILE NAME:	96j268\Structures\sj268c04.i	CHECKED BY:	C. CARLSON
PROJECT MANAGER:	R. R. WHITCOMB	SHEET	56 OF 60
DESIGNED BY:	G. ROY		
STA. 6+40 - STA. 6+50			