



ABUTMENT #1
SCALE: 1"=10'

4+87.7

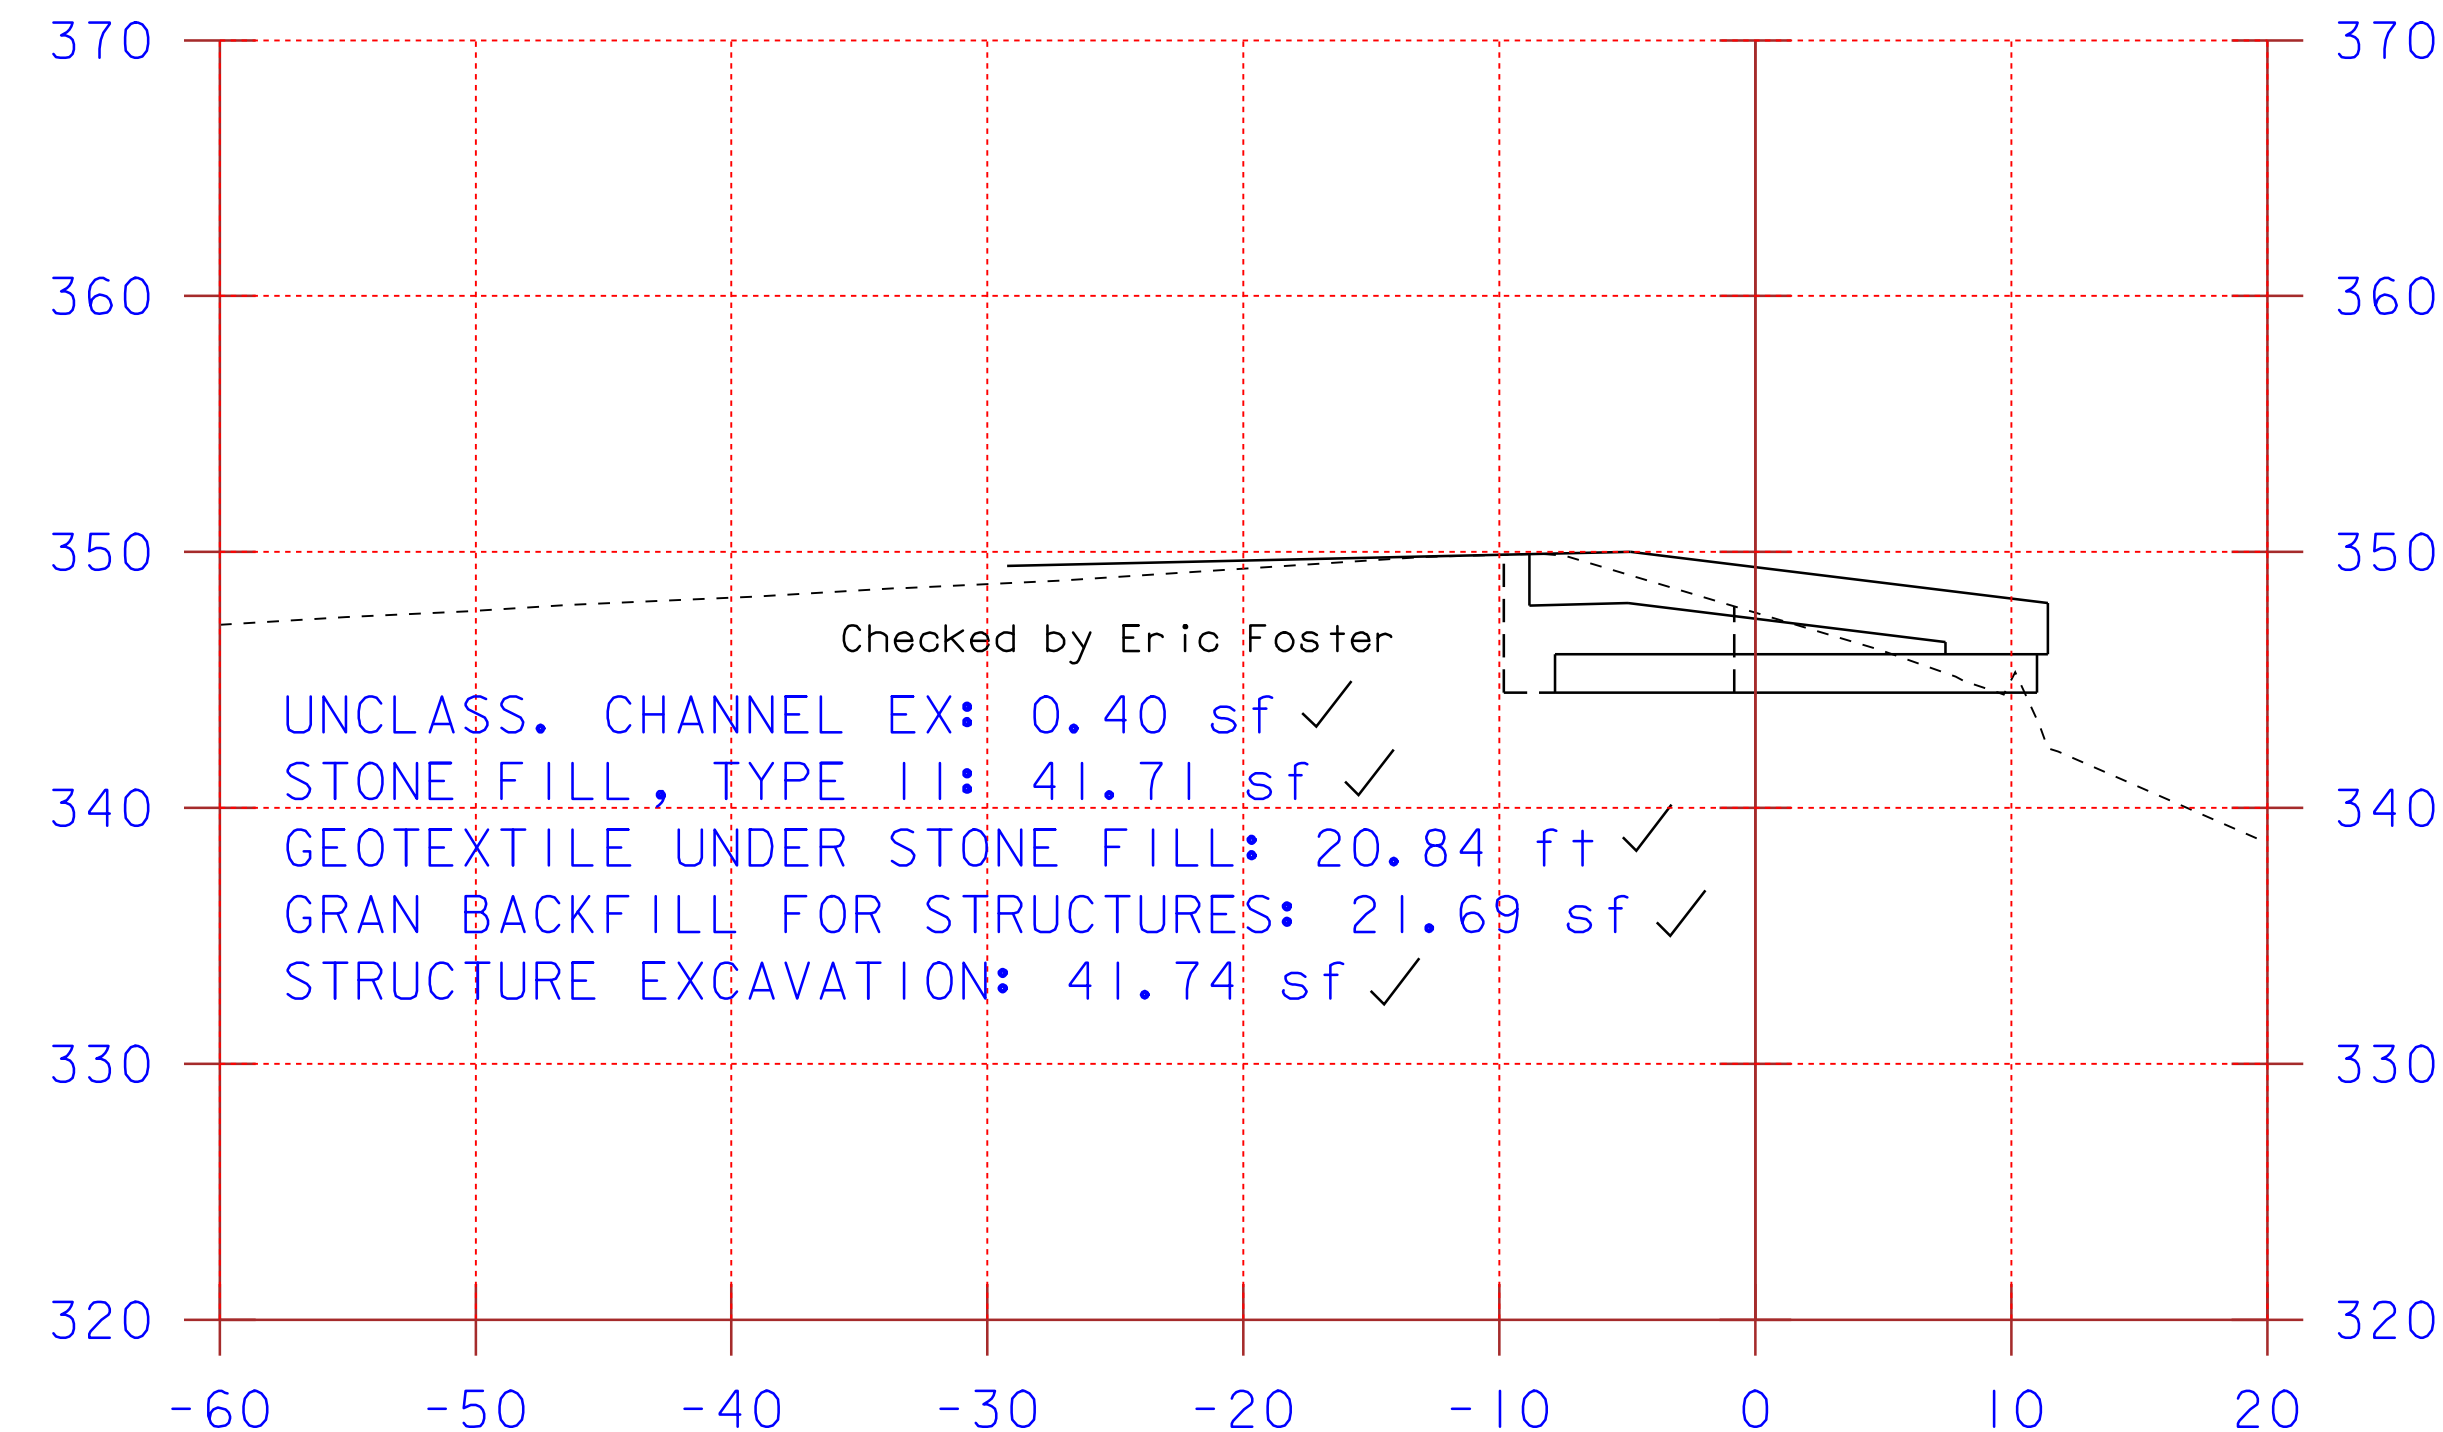


ABUTMENT #1
SCALE: 1"=10'

4+89.2 ahead

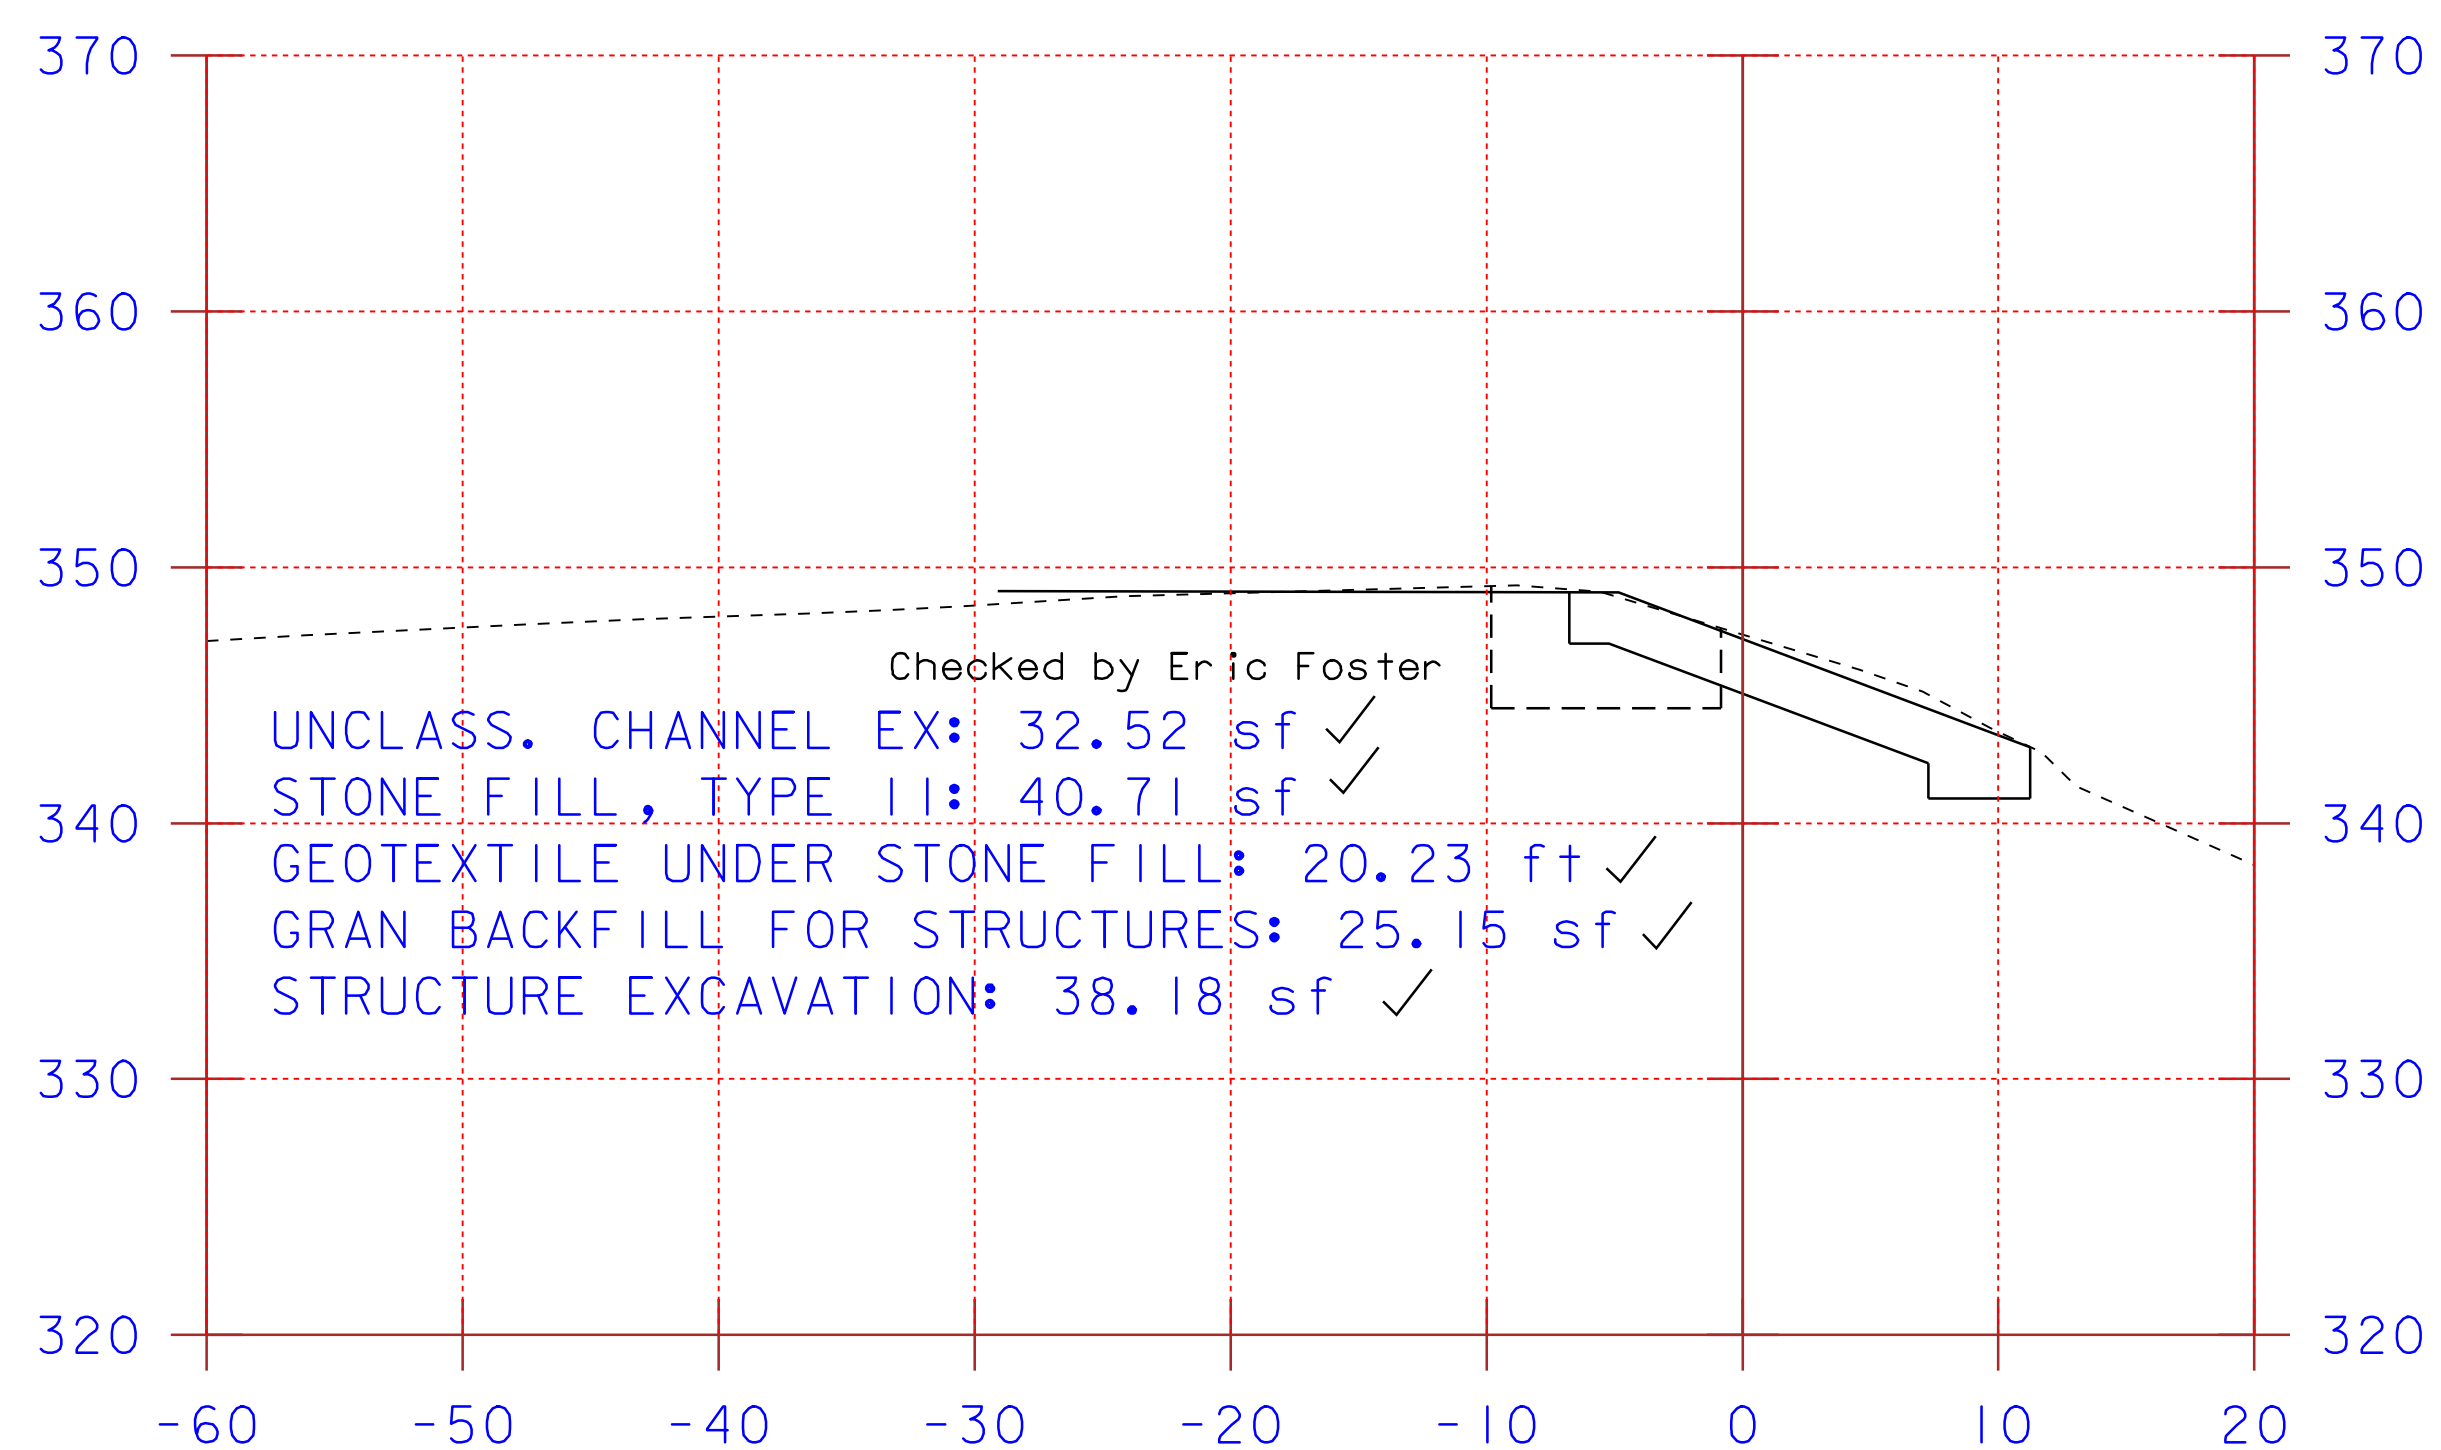

ABUTMENT #1
SCALE: 1"=10'

4+87.2

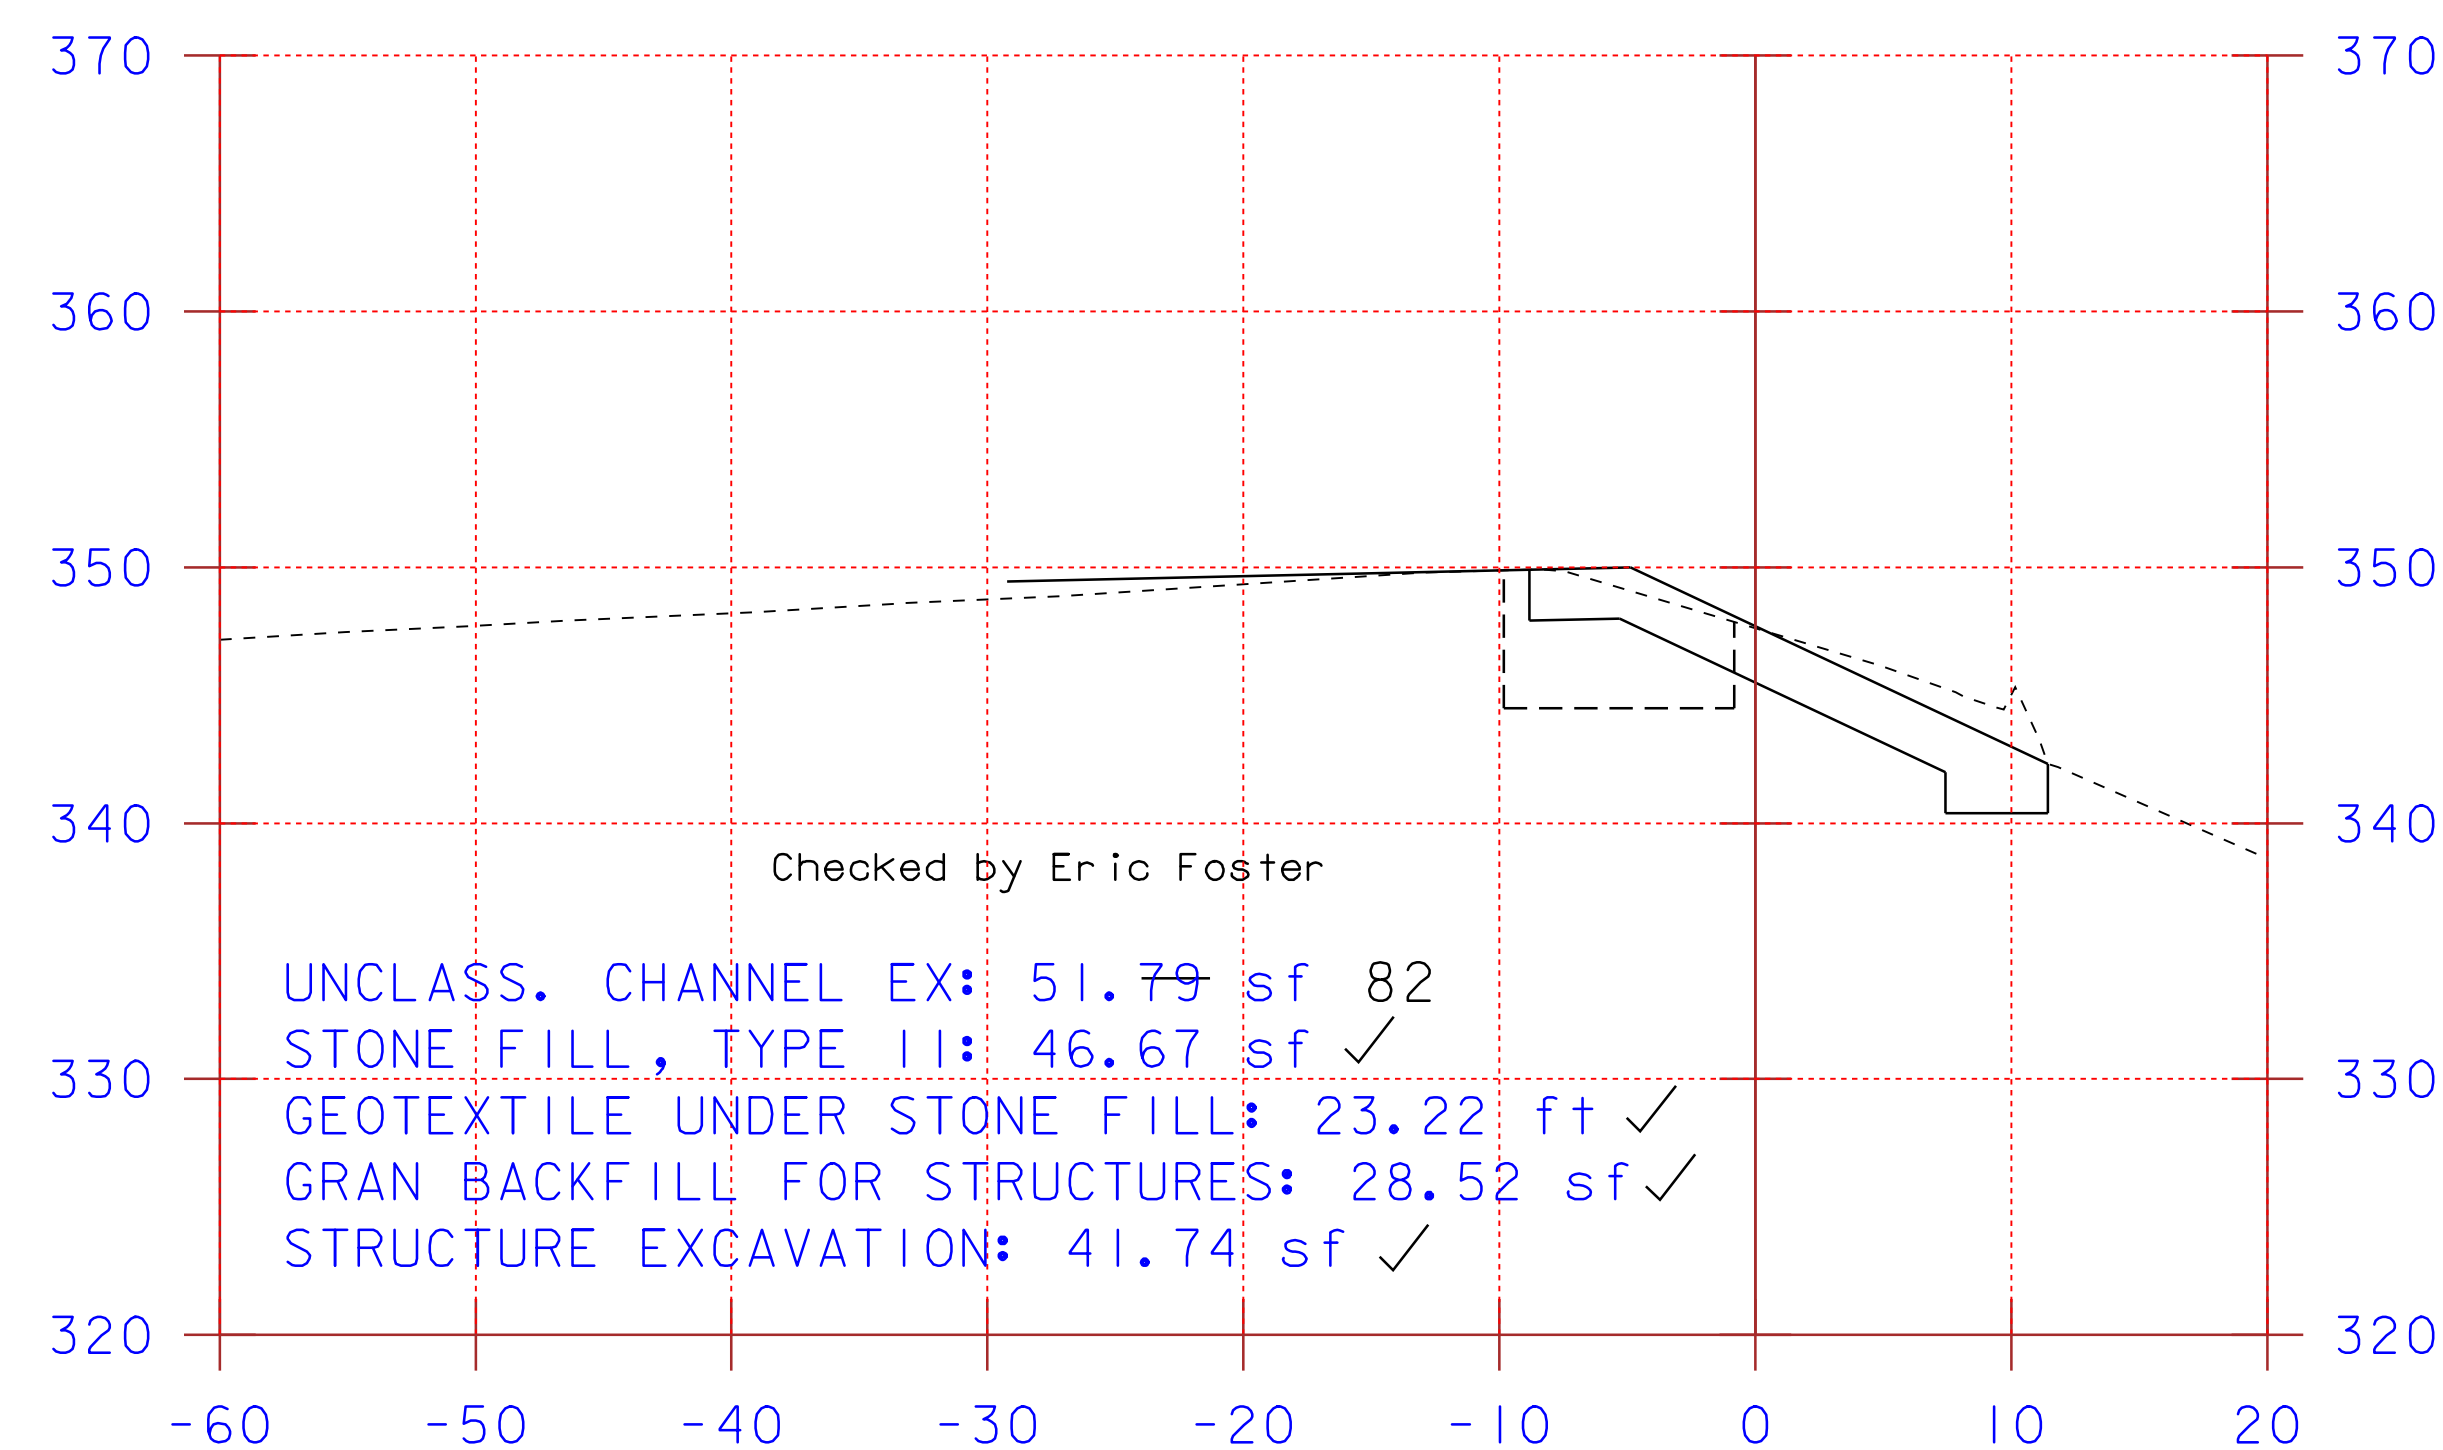

ABUTMENT #1
SCALE: 1"=10'

4+89.2 behind

PROJECT NAME:	SALISBURY - CORNWALL		
PROJECT NUMBER:	BHO 1445 (27)		
FILE NAME:	96J268\Structures\sj268m01	PLOT DATE:	19-OCT-2009 09:5
PROJECT MANAGER:	R. R. WHITCOMB	DRAWN BY:	G. ROY
DESIGNED BY:	G. ROY	CHECKED BY:	C. CARLSON
STA. 8+75 - STA. 9+50		SHEET	62 OF 60